

PERMIT

SEWAGE DISPOSAL SYSTEM

MARYLAND STATE DEPARTMENT OF HEALTH

HOWARD COUNTY

ELLICOTT CITY

DISTRICT 5

DATE 8/11/59

INDEXED

P 01516

A 00971

C. Claude Cassal IS PERMITTED TO INSTALL ALTER

ADDRESS Highland, Md PHONE _____

A SEWAGE DISPOSAL SYSTEM LOCATED AT Crow's Nest Lane

SUBDIVISION Clarksville Ridge ROAD Crow's Nest Lane LOT 38

PROPERTY OWNER Glenn E. Fulmer

ADDRESS W.R. Graco, Clarksville

SPECIFICATIONS

DRAIN FIELD DEPTH 3 FEET, BOTTOM AREA 333 SQ. FT.

SEEPAGE PITS _____ ABSORBENT SIDE-WALL AREA _____ SQ. FT.

SEPTIC TANK CAPACITY 750 GALLONS

FOR GARBAGE GRINDER, INCREASE DISPOSAL AREA 22% & TANK CAPACITY 50%.


OTHER Place part of the field about 55 ft. from Lot #37 and 180' - 200' from Crow's Nest Rd.

PLANS APPROVED BY Raymond Hodges DATE 6/5/59

FILL SEPTIC TANK AND DISTRIBUTION BOX WITH WATER BEFORE CALLING FOR AN INSPECTION. COVER NO WORK UNTIL INSPECTED AND APPROVED.

NEITHER THE HOWARD COUNTY COMMISSIONERS NOR THE HEALTH DEPARTMENT IS RESPONSIBLE FOR THE SUCCESSFUL OPERATION OF ANY SYSTEM.

00971

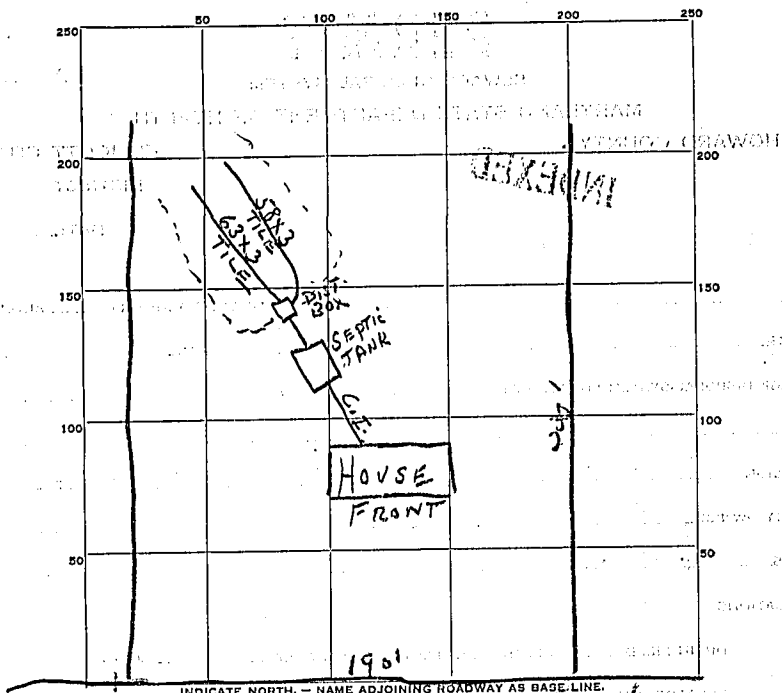

INDICATE NORTH. - NAME ADJOINING ROADWAY AS BASE LINE.

CROW'S NEST ROAD

PERMIT CARD NO.

SEPTIC TANK, LEVEL OR CLEANOUTS 1- COVER TYPE

DISTRIBUTION BOX, LEVEL OR

TILE FIELD, DEPTH 4-4 1/2 FT. TRENCH WIDTH 3 FT.

GRAVEL DEPTH _____ IN. TOTAL LENGTH 121 FT.

NUMBER OF TRENCHES 2 TOTAL BOTTOM AREA 363 SQ. FT.

SEEPAGE PITS, INSIDE DIAMETER _____ FT. DEPTH BELOW INLET _____ FT.

ABSORBENT AREA _____ SQ. FT.

REMARKS _____

DATE SYSTEM APPROVED 8-19-59 INSPECTOR J. Hennigan