

# APPLICATION

A 05260

SEWAGE DISPOSAL TESTING

P \_\_\_\_\_

MARYLAND STATE DEPARTMENT OF HEALTH

HOWARD COUNTY

ELLICOTT CITY

For house nearest R.T. 144

DISTRICT 4DATE 6/4/62

Septic Tank 750 gal.

Dry Well - one dry well 12 ft diameter and 7 ft deep below the inlet pipe. Dry well to be installed about 33 ft. behind the cellar door. (South side of building), and about 30 ft from driveway

TO: THE COUNTY HEALTH OFFICER  
ELLICOTT CITY, MARYLAND

I, HEREBY, APPLY FOR THE NECESSARY TESTS IN ORDER TO CONSTRUCT (OR RECONSTRUCT) A SEWAGE DISPOSAL SYSTEM.

PROPERTY OWNER Melvin Wessel  
ADDRESS Lisbon Rt 144 PHONE \_\_\_\_\_

PROPERTY LOCATION:

SUBDIVISION \_\_\_\_\_ LOT NO. \_\_\_\_\_

ROAD AND DESCRIPTION Dawey Road - approx. 350 feet off Rt 144 on the right side (tenant pole on Parcel 2am)

OCCUPANT \_\_\_\_\_ PHONE \_\_\_\_\_

PERSON TO CONSTRUCT SYSTEM \_\_\_\_\_

ADDRESS \_\_\_\_\_ PHONE \_\_\_\_\_

SIZE OF LOT approx. 1 acre TYPE BLDG. 2  
NUMBER OF BEDROOMS \_\_\_\_\_


IF NOT SINGLE RESIDENCE DESCRIBE \_\_\_\_\_

SIGNATURE OF APPLICANT Howard Pickett / dmaAPPROVED BY Donald W. Monaghan FOR Dry Well DATE 6-6-62  
(KIND OF SYSTEM)REJECTED BY \_\_\_\_\_ FOR \_\_\_\_\_ DATE \_\_\_\_\_  
(KIND OF SYSTEM)

HOLD PENDING FURTHER TESTS \_\_\_\_\_ DATE \_\_\_\_\_

REASONS FOR REJECTION OR HOLDING \_\_\_\_\_

## THIS IS NOT A PERMIT

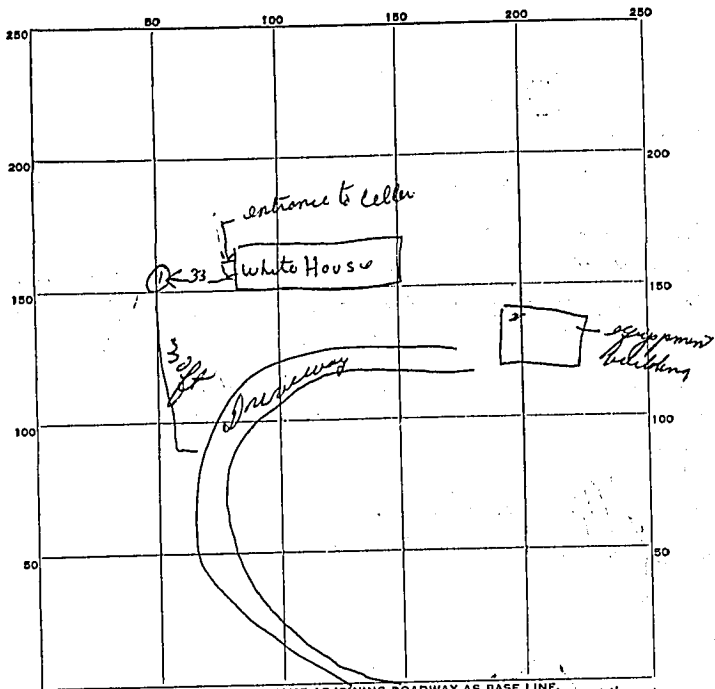

| DATE   | TEST NO. | DEPTH | PRE-WET |      | TEST - 1" DROP |      | TIME   |
|--------|----------|-------|---------|------|----------------|------|--------|
|        |          |       | START   | STOP | START          | STOP |        |
| 6-6-62 | 1        | 9 ft  | 127     | 130  | 130            | 140  | 10 min |
|        |          |       |         |      |                |      |        |
|        |          |       |         |      |                |      |        |
SOIL AUGER FINDING \_\_\_\_\_

TESTED BY John L. L. L.

REMARKS This test for house nearest RT 144

ALSO PRESENT Howard L. P. P. LOT NO. \_\_\_\_\_