

C.O. 5.23-96
12:00

PERMIT

SEWAGE DISPOSAL SYSTEM

DEPARTMENT OF HEALTH AND MENTAL HYGIENE

P 56643

A REPAIR

DISTRICT _____

DATE 5-23-96

DATE SYSTEM APPROVED 5/23/96

INSPECTOR DKS

INDEXED

HOWARD COUNTY HEALTH DEPARTMENT

BUREAU OF ENVIRONMENTAL HEALTH

313-2640

Jack Fyock Septic Service, Inc. IS PERMITTED TO INSTALL _____ ALTER

ADDRESS P.O. Box 89 Triadelphia Road, Glenelg, MD 21737 PHONE 988-9270

SUBDIVISION Breezewood LOT 30, Sec.3 ROAD 10610 Breezewood Drive

PROPERTY OWNER Whitlow

ADDRESS _____

SEPTIC TANK CAPACITY 1000 GALLONS

NUMBER OF BEDROOMS 3

125 SQUARE FEET PER BEDROOM

LINEAR FEET OF TRENCH REQUIRED 47'

REPAIR - PURPOSE - SEPTIC SYSTEM HAS FAILED.

Call for inspection when ground is open so sanitarian can recommend repairs.

Install one trench off existing drywell 5/23/96

inlet 2', bottom 10', stone 8' vr/

length 55'

PLANS APPROVED BY Donna K. Spore DATE 5/23/96

COVER NO WORK UNTIL INSPECTED AND APPROVED

NEITHER THE HOWARD COUNTY COUNCIL NOR THE HEALTH DEPARTMENT IS RESPONSIBLE FOR THE SUCCESSFUL OPERATION OF ANY SYSTEM

NOTE: CLEANOUT REQUIRED EVERY 70 FEET OF SEWER LINE AND/OR AT 90° SWEEPS IN LINES FROM HOUSE TO DRAIN FIELDS, 90° ELBOWS NOT ACCEPTABLE.

NOTE: ALL PARTS OF SEPTIC SYSTEMS (I.E. TANK, DISTRIBUTION BOX TRENCHES) TO BE 100 FEET FROM WELL (UNLESS OTHERWISE SPECIFICALLY AUTHORIZED)

NOTE: IF DEEP TRENCH(ES) ARE USED CALL FOR INSPECTION BEFORE AND AFTER PLACING GRAVEL IN TRENCH(ES)

NOTE: NO DRY WELL SHALL EXCEED 15 FOOT IN DIAMETER NO ABSORPTION TRENCH TO EXCEED 100 FEET IN LENGTH

NOTE: ALL PIPE FROM HOUSE TO SEPTIC TANK MUST BE CAST IRON OR SCHEDULE 35/40 PVC OR ABS


PERMIT VOID AFTER TWO YEARS

NOTE: INSTALL STAND PIPE ON SEPTIC TANK AND DRY WELL STAND PIPES MUST BE 6 INCHES IN DIAMETER CAST IRON. CONCRETE OR TERRA COTTA OR PVA OR ABS ACCEPTED. IF TOP OF SEPTIC TANK IS DEEPER THAN 3 FEET, MANHOLE TO GRADE REQUIRED.

NOTE: DISTRIBUTION BOXES MUST HAVE BAFFLES

***INSTALLER IS RESPONSIBLE FOR OBTAINING FINAL APPROVAL ON THIS PERMIT**

P 56643

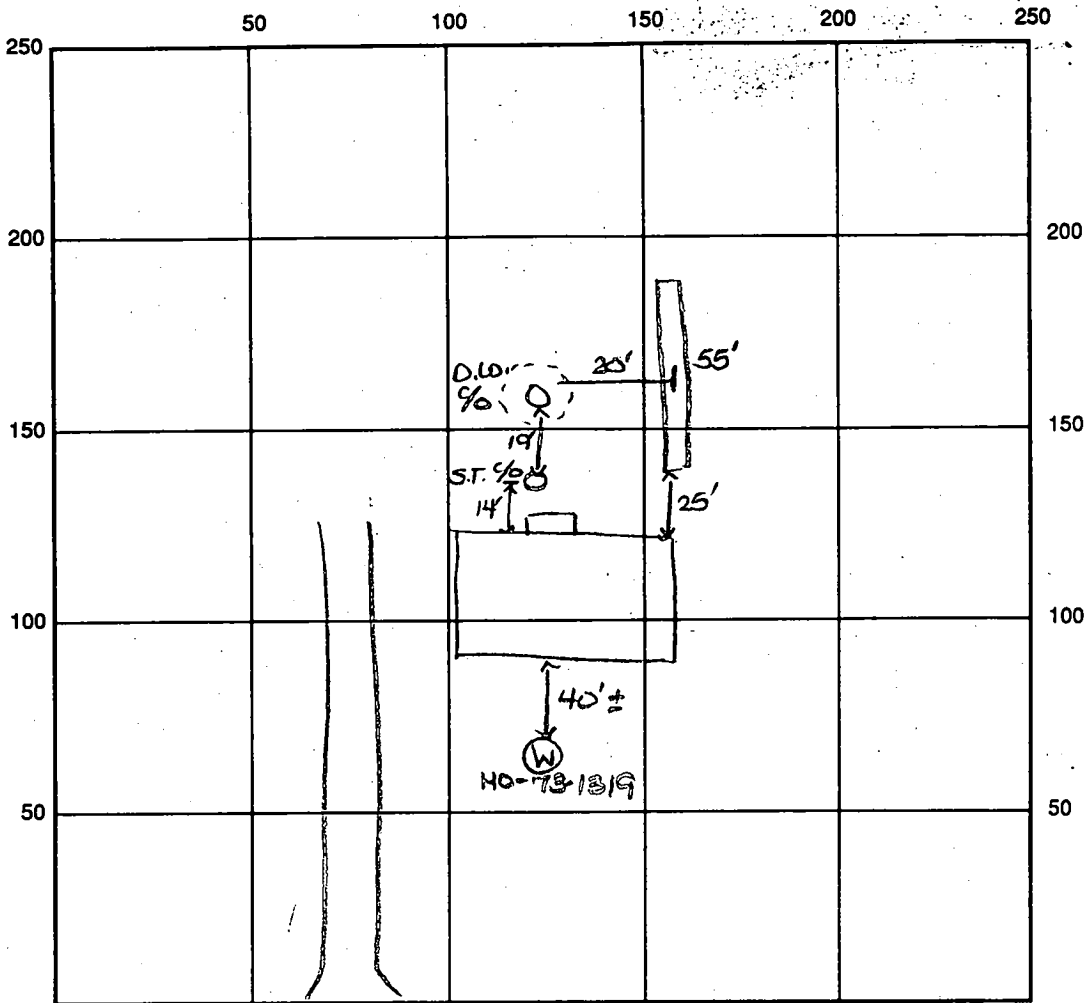

INDICATE NORTH - NAME ADJOINING ROADWAY AS BASE LINE

Breezewood Drive

SEPTIC TANK LEVEL Existing CLEANOUTS Existing - one on s.t., one on d.w.

DISTRIBUTION BOX LEVEL N/A

DRAIN FIELD/TITLE DEPTH 10 FT. TRENCH WIDTH 2 FT. INLET DEPTH 2 FT.

EFFECTIVE GRAVEL DEPTH 8 FT. TOTAL LENGTH 55 FT.

NUMBER OF TRENCHES 1 ONE SIDEWALL AREA 440 SQ. FT.

DRYWALL INSIDE DIAMETER EX. FT. EFFECTIVE DEPTH BELOW INLET EX. FT.

ABSORBENT AREA 440 SQ. FT. + Existing

REMARKS: 5/23/96 FINAL - OK to cover all work: DKS

DATE SYSTEM APPROVED 5/23/96 INSPECTOR DONNA K GOR

2/5/76 - Ready
after 2 P.M.

System Final

PERMIT

SEWAGE DISPOSAL SYSTEM

CONNECTION NOT
AS PER TED

22763

16821

MARYLAND STATE DEPARTMENT OF HEALTH

HOWARD COUNTY

ELLICOTT CITY

DISTRICT 3

INDEXED

DATE 1/21/76

Ten Oaks Construction Company IS PERMITTED TO INSTALL ALTER

ADDRESS 1203 Ten Oaks Road, Baltimore, Md. 21227 PHONE 243-9518

A SEWAGE DISPOSAL SYSTEM LOCATED AT _____

SUBDIVISION Brimwood Farms ROAD 10610 Breeswood Drive LOT 20, Sec. 3

PROPERTY OWNER Joyce Keller Whitlow

ADDRESS _____

SPECIFICATIONS - 3 bedrooms

DRAIN FIELD _____ DEPTH _____ FEET. BOTTOM AREA _____ SQ. FT.

SEEPAGE PITS _____ ABSORBENT SIDE-WALL AREA _____ SQ. FT.

SEPTIC TANK CAPACITY 1,000 GALLONS

FOR GARBAGE GRINDER, INCREASE DISPOSAL AREA 25% & TANK CAPACITY 50%.

OTHER Dry well - 375 sq. ft. absorbent sidewall area to begin below the inlet.

Inlet to be 3 ft. below original grade. Maximum depth permitted for dry well is 104 ft.

below original grade. Locate dry well 120 ft. from the front property line and 37 ft. from

left side line as seen from Breeswood Drive.


NOTE: ALL PIPE FROM HOUSE TO DISPOSAL AREA MUST BE CAST IRON.

PERMIT VOID AFTER THREE YEARS.

INSTALL STAND PIPE ON SEPTIC TANK AND DRY WELL. STAND PIPE MUST BE 6" IN DIA., CAST IRON,

PLANS APPROVED BY R. V. Torres DATE 3/27/72
CONCRETE OR TERRA COTTA ACCEPTED.

FILL SEPTIC TANK AND DISTRIBUTION BOX WITH WATER BEFORE CALLING FOR AN INSPECTION. COVER NO WORK UNTIL INSPECTED AND APPROVED.

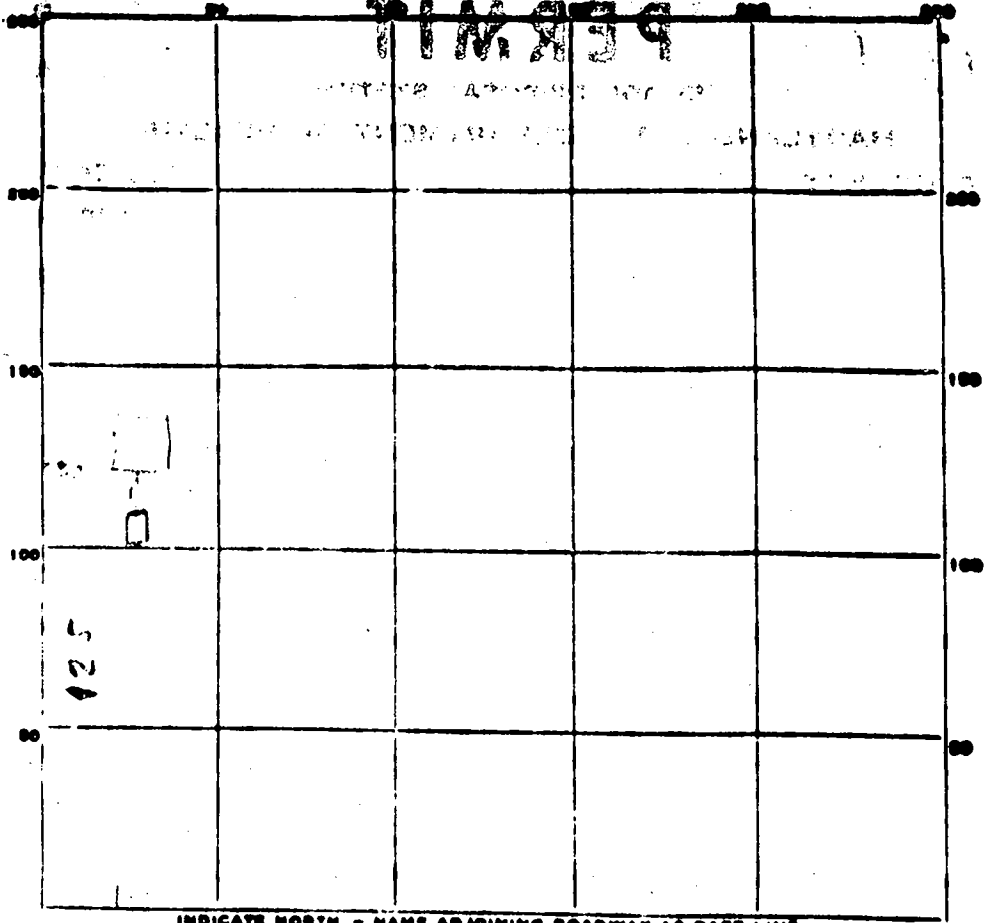

INDICATE NORTH - NAME ADJOINING ROADWAY AS BASE LINE.

PERMIT CARD 3000

SEPTIC TANK, LEVEL 1

CLEANOUTS ✓

DISTRIBUTION BOX, LEVEL 2

TILE FIELD, DEPTH 14 FT. TRENCH WIDTH 12 FT.

GRAVEL DEPTH 4 IN. TOTAL LENGTH 12 FT.

NUMBER OF TRENCHES 1 TOTAL BOTTOM AREA 12

SEEPAGE PITS, INSIDE DIAMETER 12 FT. DEPTH BELOW INLET 2 1/2 FT.

ABSORBENT AREA 12 SQ. FT.

REMARKS 1 trench 12 ft long

APPLICATION

A 16921

P _____

SEWAGE DISPOSAL TESTING

MARYLAND STATE DEPARTMENT OF HEALTH

HOWARD COUNTY Septic Tank - 1000 gal

ELLICOTT CITY

Dry Well - 375 sq ft absorbent sidewalk area to DISTRICT 2

be installed below the inlet to the dry well DATE 3/7/72

to be installed per dry well as 10 ft ft below

required practice locate dry well 120 ft from

front property line and 37 ft from Sept. tanks

to be 100 ft from Greenwood Drive

System to be installed before City Council release

TO: THE COUNTY HEALTH OFFICER
ELLICOTT CITY, MARYLAND

I, HEREBY, APPLY FOR THE NECESSARY TESTS IN ORDER TO CONSTRUCT OR RECONSTRUCT A SEWAGE DISPOSAL SYSTEM.

PROPERTY OWNER Russell V. Beckett & others

ADDRESS 10750 Old Frederick Road, Woodstock, Md. PHONE 328-2184

PROPERTY LOCATION:

SUBDIVISION Greenwood Farms LOT NO. 20, Sec. 3

ROAD AND DESCRIPTION Greenwood Drive

OCCUPANT _____ PHONE _____

PERSON TO CONSTRUCT SYSTEM _____

ADDRESS _____ PHONE _____


SIZE OF LOT 43,605 sq. ft. TYPE BLDG. 1

IF NOT SINGLE RESIDENCE DESCRIBE _____ (Single Fmly. Dwlg.)

SIGNATURE OF APPLICANT Russell V. Beckett

APPROVED BY E.M. FOR well DATE 3/7/72

NOTATION

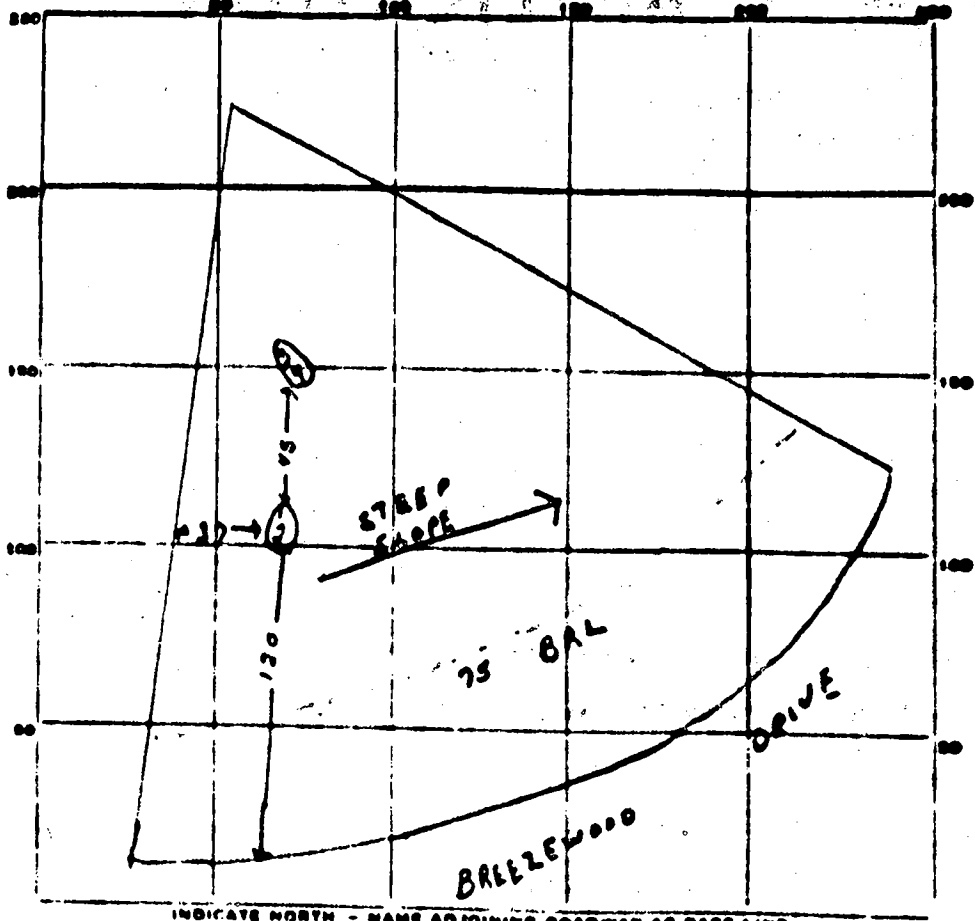

DATE	TEST NO.	DEPTH	PRE-WET		TEST - 1" DROP		TIME
			START	STOP	START	STOP	
3/23/72	1	3 ft.	12 ¹⁰	12 ¹⁴	12 ¹⁹	12 ²¹	7 min
	2	11 ft.	12 ¹⁰	12 ¹⁸	12 ¹⁸	12 ²⁰	12 min
	3	10 1/2 ft.	12 ¹⁶	12 ¹⁹	12 ¹⁹	12 ²⁴	5 min
	4	2 1/2 ft.	12 ¹⁵	12 ¹⁹	12 ¹⁹	12 ²¹	4 min
10/7/75	5	12 1/2	vis	dry			R.M.

C 1 0272

STATE OF MARYLAND
 WATER RESOURCES ADMINISTRATION
 TAYES STATE OFFICE BLDG., ANNAPOLIS, MD. 21401
 WELL COMPLETION REPORT

THIS REPORT MUST BE SUBMITTED WITHIN
 30 DAYS AFTER WELL COMPLETION
 FILL IN THIS FORM COMPLETELY
 COUNTY NUMBER W22758

DATE RECEIVED (WRA USE ONLY)
 DATE WELL COMPLETED
 June 1, 1976
 250376

DEPTH OF WELL
 143
 (TO NEAREST FOOT)

PERMIT NO. FROM "PERMIT TO DRILL WELLS"
 H-73-1577

DRILLER IDENTIFICATION NO. 30

OWNER: Miller, Joyco
 STREET OR RD: 8046 C Town & Country Blvd.
 POST OFFICE: Elkton City, Maryland

WELL LOG

DEPTH	DESCRIPTION	PERMITS
0		
5		
9		
17		
27		
37		
47		
53		
60		
7		

ABSTRACT RECORD

WELL HAS BEEN DRILLED (circle appropriate box)
 YES NO

TYPE OF DRILLING MATERIAL (circle appropriate box)
 CEMENT CM CONCRETE GROUT CG

NO. OF CASINGS _____ NO. OF POUNDS 1,140

DEVELOPMENT OF WELL _____

DEPTH OF GROUT SEAL (TO NEAREST FOOT)
 FROM _____ FT. TO _____ FT.
 LAYED OFF FROM SURFACE: _____

CASING RECORD

(circle appropriate code below)

STEEL SI CO
 PLASTIC PL OTHER OT

MAIN CASING TYPE _____

INTERNAL DIAMETER (TO NEAREST INCH) _____

TOTAL DEPTH OF MAIN CASING (TO NEAREST FOOT) 42

OTHER CASING (IF USED)

DIAMETER (INCH) _____ DEPTH (FEET) _____

SCREEN RECORD

(circle appropriate code below)

STEEL BY BR NO
 PLASTIC PL OTHER OT

DEPTH

DEPTH (TO NEAREST WHOLE FOOT) FROM _____ TO _____

PUMPING TEST

WELLS PUMPED (TO NEAREST HOUR) _____

PUMPING DATE _____

WATER LEVEL (MEASURED FROM LAND SURFACE)
 BEFORE PUMPING _____ FEET
 DURING PUMPING _____ FEET

TYPE OF PUMPER USED (circle appropriate box)
 A AIR P PERISTALTIC V VERTICAL C CENTRIFUGAL R ROTARY O OTHER J JET S SURFACE

PUMP INSTALLED

TYPE OF PUMP (circle appropriate letter)
 A A B B C C D D E E F F G G H H I I J J K K L L M M N N O O P P Q Q R R S S T T U U V V W W X X Y Y Z Z

DRILLER WILL INSTALL PUMP (circle appropriate box)
 YES NO

CAPACITY _____

DEVELOPMENT PER MINUTE (TO NEAREST GALLON) _____

PUMP HORSE POWER _____

PUMP COLUMN LENGTH (NEAREST FOOT) _____

CASING HEIGHT (circle appropriate box)
 ABOVE LAND SURFACE
 BELOW LAND SURFACE

LOCATION OF WELL ON LOT

Circle to nearest structure (e.g., buildings, utility tanks, etc.) and other land marks and indicate not less than two diagonal measurements to well.

CIRCLE APPROPRIATE BOXES

