

APPLICATION

A 05261

SEWAGE DISPOSAL TESTING

P _____

MARYLAND STATE DEPARTMENT OF HEALTH

HOWARD COUNTY

ELLICOTT CITY

DISTRICT 4

DATE 6/4/62

Septic Tank - 750 gal

Dry Well - 12 ft diameter and 7 ft deep
below the outlet pipe.

Please Dry Well = 30 ft for the right of driveway
at a point directly off right side of porch. ~~connect~~
Cost man pipe must be used from house
to septic tank.

TO: THE COUNTY HEALTH OFFICER
ELLICOTT CITY, MARYLAND

I, HEREBY, APPLY FOR THE NECESSARY TESTS IN ORDER TO CONSTRUCT (OR RECONSTRUCT) A SEWAGE DISPOSAL SYSTEM.

PROPERTY OWNER Melvin Wessel
ADDRESS Lisboa Rt 144 PHONE _____

PROPERTY LOCATION: _____
SUBDIVISION _____ LOT NO. _____

ROAD AND DESCRIPTION Dairy Road - approx. 350 ft off Rt 144 on the right
tenant house on Wessel farm

OCCUPANT _____ PHONE _____

PERSON TO CONSTRUCT SYSTEM _____
ADDRESS _____ PHONE _____

SIZE OF LOT approx 1 acre TYPE BLDG. 2
IF NOT SINGLE RESIDENCE DESCRIBE _____ NUMBER OF BEDROOMS _____

SIGNATURE OF APPLICANT Howard Pickett/dma


APPROVED BY Dorothy W. Managhan FOR Dry well DATE 6-20-62
(KIND OF SYSTEM)

REJECTED BY _____ FOR _____ DATE _____
(KIND OF SYSTEM)

HOLD PENDING FURTHER TESTS SWM DATE 6-6-62

REASONS FOR REJECTION OR HOLDING little fees.

THIS IS NOT A PERMIT

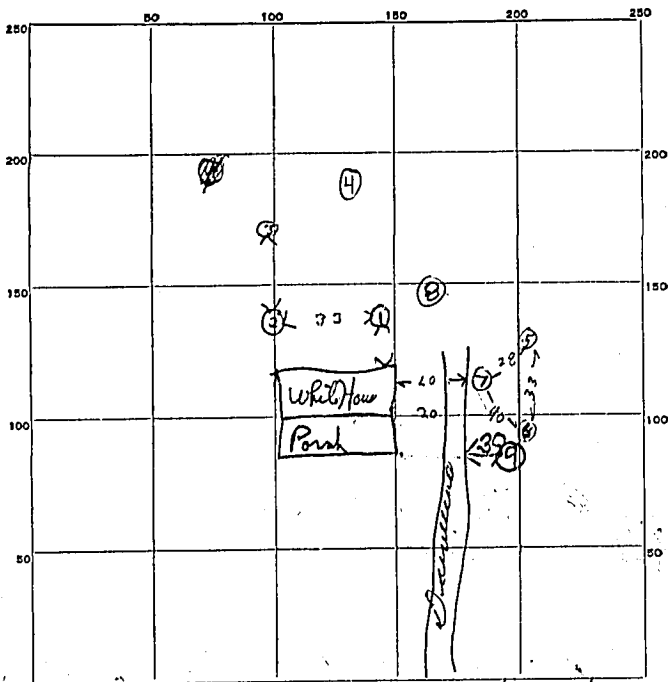

INDICATE NORTH. - NAME ADJOINING ROADWAY AS BASE LINE
Daisy Road 6744 →

DATE	TEST NO.	DEPTH	PRE-WET		TEST - 1" DROP		TIME
			START	STOP	START	STOP	
6-6-62	1	3	203	245	little perc		
	2	3	207	250	little perc		
	3	3	210	250	little perc		
	4	2 1/2	214	250	little perc		
8 JUN 62	5	4	1257	153	1st inch 55 min		
8 " "	6	4	101	141	little perc		
8 " "	7	3 1/2	103	141	little perc		
8 " "	8	8	Under ground water at 8 ft				
6-20-62	9	11 ft	918	920	920	926	6 min

SOIL AUGER FINDING _____

TESTED BY *DWM 6-16-62* *DWM-6-20-62*

REMARKS _____

ALSO PRESENT *7 7 Pipe 8/4/62* LOT NO *21 Pipe 100*