

# PERMIT

SEWAGE DISPOSAL SYSTEM

MARYLAND STATE DEPARTMENT OF HEALTH

HOWARD COUNTY

ELLICOTT CITY

DISTRICT 4

DATE 6/20/62

*approved  
7-11-62  
DUM*

P 05363

A 05261

**INDEXED**

*Howard Lic. #*

**INDEXED**

IS PERMITTED TO INSTALL  ALTER

ADDRESS \_\_\_\_\_ PHONE \_\_\_\_\_

A SEWAGE DISPOSAL SYSTEM LOCATED AT Daisy Rd - approx. 350 ft. off Rt 144 on right second house on right

SUBDIVISION \_\_\_\_\_ ROAD \_\_\_\_\_ LOT \_\_\_\_\_

PROPERTY OWNER Wesley, Mabrian

ADDRESS Lisbon

### SPECIFICATIONS

DRAIN FIELD \_\_\_\_\_ DEPTH \_\_\_\_\_ FEET, BOTTOM AREA \_\_\_\_\_ SQ. FT.

SEEPAGE PITS 1 ABSORBENT SIDE-WALL AREA 12'x8' SQ. FT. below the inlet pipe.

SEPTIC TANK CAPACITY 750 GALLONS

FOR GARBAGE GRINDER, INCREASE DISPOSAL AREA 22% & TANK CAPACITY 50%.


OTHER Place the Dry Well 30 ft from to the right of driveway at a point directly off right side of porch. (If it is a pipe must be ahead from house to septic tank.)

PLANS APPROVED BY DW Monaghan DATE 6/20/62

FILL SEPTIC TANK AND DISTRIBUTION BOX WITH WATER BEFORE CALLING FOR AN INSPECTION. COVER NO WORK UNTIL INSPECTED AND APPROVED.

NEITHER THE HOWARD COUNTY COMMISSIONERS NOR THE HEALTH DEPARTMENT IS RESPONSIBLE FOR THE SUCCESSFUL OPERATION OF ANY SYSTEM.

A 05261

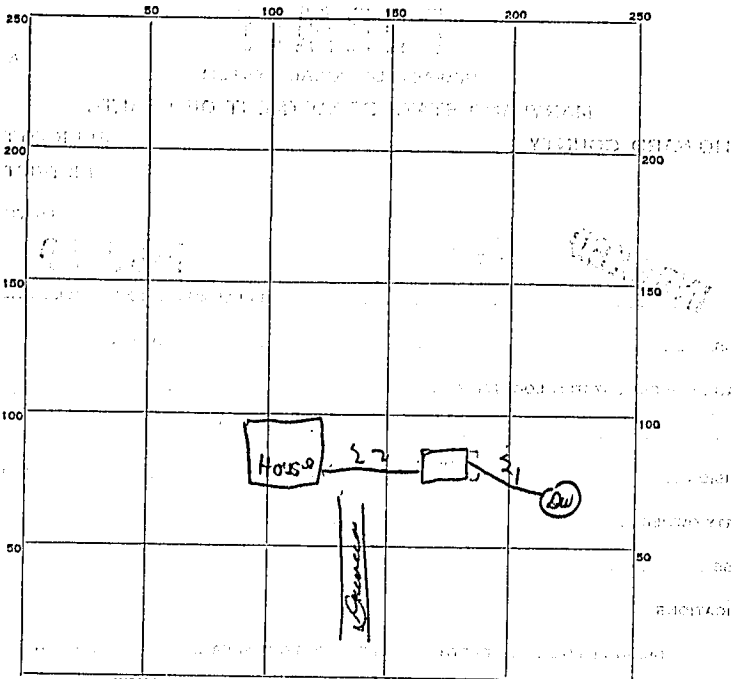

INDICATE NORTH - NAME ADJOINING ROADWAY AS BASE LINE.

*Daisy Road*

$$\begin{array}{r} 3.14 \\ \times 12 \\ \hline 628 \\ 31.4 \\ \hline 376 \\ \hline 3608 \end{array}$$

PERMIT CARD \_\_\_\_\_

SEPTIC TANK, LEVEL  CLEANOUTS

DISTRIBUTION BOX, LEVEL \_\_\_\_\_

TILE FIELD, DEPTH \_\_\_\_\_ FT. TRENCH WIDTH \_\_\_\_\_ FT.

GRAVEL DEPTH \_\_\_\_\_ IN. TOTAL LENGTH \_\_\_\_\_ FT.

NUMBER OF TRENCHES \_\_\_\_\_ TOTAL BOTTOM AREA \_\_\_\_\_

SEEPAGE PITS, INSIDE DIAMETER 12 FT. DEPTH BELOW INLET 8 FT.

ABSORBENT AREA 300 SQ. FT.

REMARKS \_\_\_\_\_

DATE SYSTEM APPROVED 7-11-62 INSPECTOR DUM