

7/18/96
8/28/96 10:00
12:00

7/18/96
called Fogle's
about permit
fee (15)

PERMIT

SEWAGE DISPOSAL SYSTEM

DEPARTMENT OF HEALTH AND MENTAL HYGIENE

03-306364

HOWARD COUNTY HEALTH DEPARTMENT

BUREAU OF ENVIRONMENTAL HEALTH

313-2640

INDEXED

P 57034

A REPAIR

DISTRICT _____

DATE 7-19-96

DATE SYSTEM APPROVED 8/29/96

INSPECTOR ALM

Fogle's Septic Clean, Inc.

IS PERMITTED TO INSTALL _____ ALTER

ADDRESS 558-R Obrecht Road, Sykesville, MD 21784

PHONE 795-5674

SUBDIVISION Buttercup Estates LOT 7

ROAD 12790 Frederick Road

PROPERTY OWNER Howard Kenyon

12820

ADDRESS 12790 Frederick Road
West Friendship, Maryland

SEPTIC TANK CAPACITY Existing GALLONS

Map 15, Grid 10, Parcel 237

NUMBER OF BEDROOMS 5

180 SQUARE FEET PER BEDROOM

LINEAR FEET OF TRENCH REQUIRED 180

REPAIR - PURPOSE - SEPTIC SYSTEM HAS FAILED.

Call for inspection when ground is opened so sanitarian can recommend repair.

existing trench to be disconnected

Trenches to be installed through passed perc hole
on contour parallel to road.

Trenches to be 2' wide, inlet 3' bottom 8' stone 5'.

PLANS APPROVED BY

Souma & Soel

DATE 7/18/96

COVER NO WORK UNTIL INSPECTED AND APPROVED

NEITHER THE HOWARD COUNTY COUNCIL NOR THE HEALTH DEPARTMENT IS RESPONSIBLE FOR THE SUCCESSFUL OPERATION OF ANY SYSTEM

NOTE: CLEANOUT REQUIRED EVERY 70 FEET OF SEWER LINE AND/OR AT 90° SWEEPS IN LINES FROM HOUSE TO DRAIN FIELDS, 90° ELBOWS NOT ACCEPTABLE.

NOTE: ALL PARTS OF SEPTIC SYSTEMS (I.E. TANK, DISTRIBUTION BOX TRENCHES) TO BE 100 FEET FROM WELL (UNLESS OTHERWISE SPECIFICALLY AUTHORIZED)

NOTE: IF DEEP TRENCH(ES) ARE USED CALL FOR INSPECTION BEFORE AND AFTER PLACING GRAVEL IN TRENCH(ES)

NOTE: NO DRY WELL SHALL EXCEED 15 FOOT IN DIAMETER NO ABSORPTION TRENCH TO EXCEED 100 FEET IN LENGTH

NOTE: ALL PIPE FROM HOUSE TO SEPTIC TANK MUST BE CAST IRON OR SCHEDULE 35/40 PVC OR ABS


PERMIT VOID AFTER TWO YEARS

NOTE: INSTALL STAND PIPE ON SEPTIC TANK AND DRY WELL STAND PIPES MUST BE 6 INCHES IN DIAMETER CAST IRON. CONCRETE OR TERRA COTTA OR PVA OR ABS ACCEPTED. IF TOP OF SEPTIC TANK IS DEEPER THAN 3 FEET. MANHOLE TO GRADE REQUIRED.

NOTE: DISTRIBUTION BOXES MUST HAVE BAFFLES

*INSTALLER IS RESPONSIBLE FOR OBTAINING FINAL APPROVAL ON THIS PERMIT

P 57034

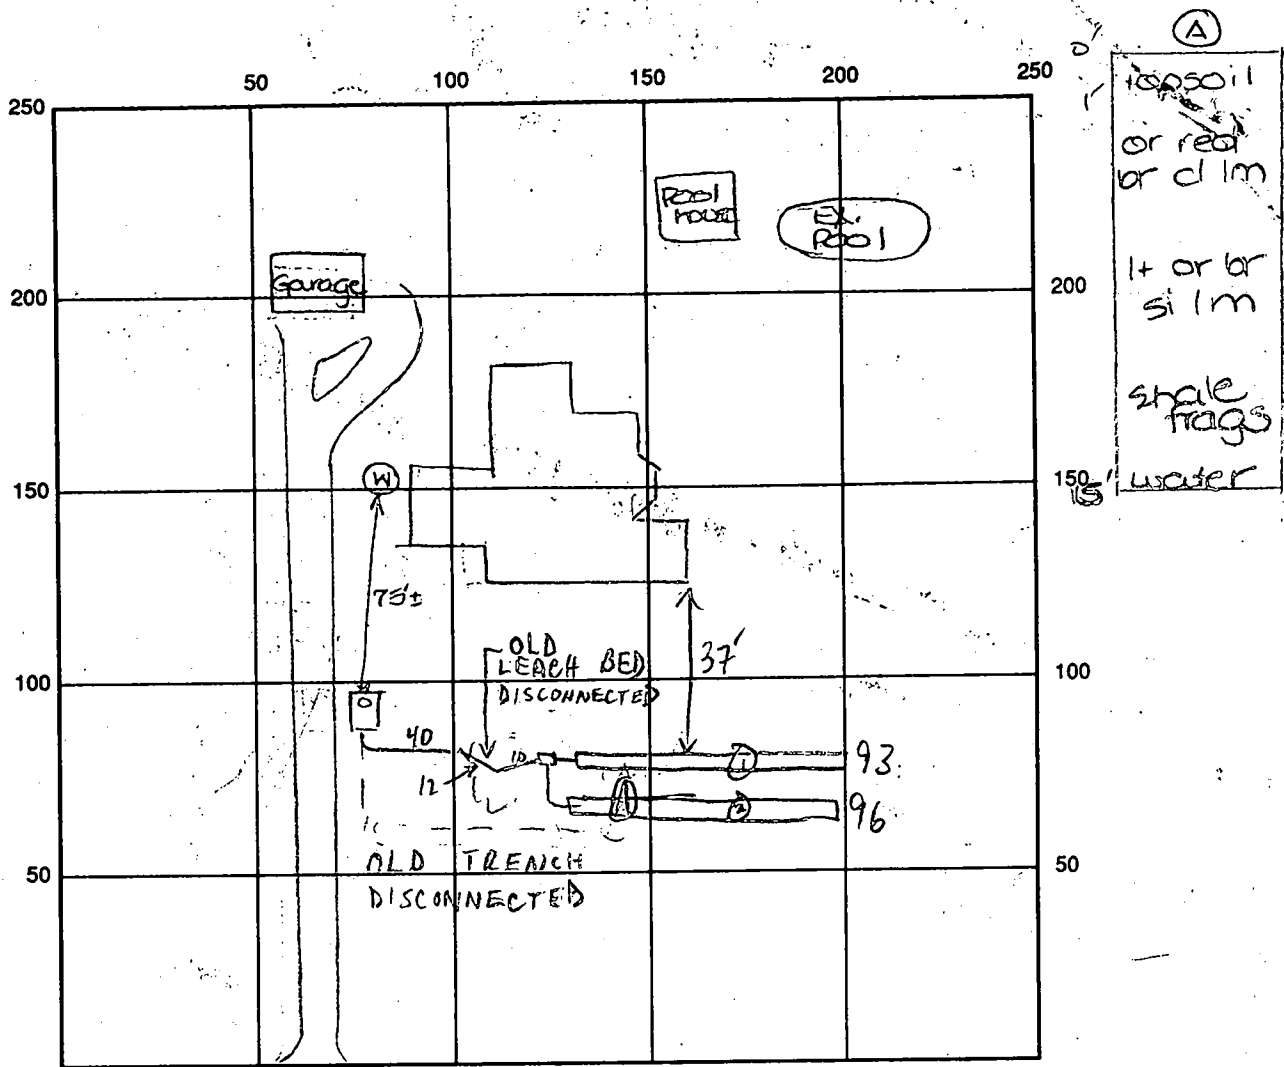

INDICATE NORTH - NAME ADJOINING ROADWAY AS BASE LINE

SEPTIC TANK LEVEL EXISTING 750 GAL Frederick Rd CLEANOUTS NEW ON S.T.

DISTRIBUTION BOX LEVEL OK

DRAIN FIELD/TITLE DEPTH 8 1/2 FT. TRENCH WIDTH 2 FT. INLET DEPTH 3 1/3 FT.

EFFECTIVE GRAVEL DEPTH 5 1/2 FT. TOTAL LENGTH 93 96 FT.

NUMBER OF TRENCHES 2 ONE SIDEWALL/BOTTOM AREA 93 96 SQ. FT.

DRYWALL INSIDE DIAMETER FT. EFFECTIVE DEPTH BELOW INLET FT.

ABSORBENT AREA SQ. FT.

REMARKS: 7/18/96 well not observed - location per owner. Perc hole
(A) OK. If necessary, trenches may be 10' deep w/
5' stone to have necessary fall. OK to start work. DCS
8/28/96 OK TO STONE, LEAVE ENDS OPEN FOR FINAL MR
8/29/96 Final inspection made AUW

DATE SYSTEM APPROVED 8/29/96 INSPECTOR A. M. Mellow

SEWAGE DISPOSAL SYSTEM

MARYLAND STATE DEPARTMENT OF HEALTH

HOWARD COUNTY

BELLEHART CITY

DISTRICT 2

INDEXED

DATE 11/73

Jack Frost IS PERMITTED TO INSTALL ALTER

ADDRESS The Oaks Road, Clarks, MD PHONE 281-2110

A SEWAGE DISPOSAL SYSTEM LOCATED AT

SUBDIVISION BUTTER COP ESTATES LOT NEW 7 ROAD Route 144 LOT 2nd driveway West of Rb. 22 & Rb. 144

PROPERTY OWNER Chester Orless

ADDRESS

SPECIFICATIONS

DRAIN FIELD DEPTH FEET, BOTTOM AREA 92 FT. Lot NEW 7 Buttercop Estates

SEEPAGE PITS ABSORBENT SIDE WALL AREA 92 FT.

SEPTIC TANK CAPACITY GALLONS

FOR GARBAGE GRINDER, INCREASE DISPOSAL AREA AND TANK CAPACITY AS NOTED ON THIS PLAN

OTHER See 5/9/73 Repair permit from Howard County Health Dept. system location C.B.A.

PLANS APPROVED BY C. B. Streater DATE 5/9/73

FILL SEPTIC TANK AND DISTRIBUTION BOX WITH WATER BEFORE CALLING FOR AN INSPECTION. COVER NO WORK UNTIL INSPECTED AND APPROVED.

NEITHER THE HOWARD COUNTY COMMISSIONERS NOR THE HEALTH DEPARTMENT IS RESPONSIBLE FOR THE SUCCESSFUL OPERATION OF ANY SYSTEM.

SEWAGE DISPOSAL TESTING

STATE OF MARYLAND - DEPARTMENT OF HEALTH AND MENTAL HYGIENE

HOWARD COUNTY HEALTH DEPARTMENT
ENVIRONMENTAL HEALTH SERVICES
P. O. BOX 476, ELLICOTT CITY, MARYLAND 21043
TELEPHONE: 410-6000, EXT. 239

DISTRICT
DATE 5/19/73

5/19/73
9:30 A.M.

TO: THE COUNTY HEALTH OFFICER
ELLICOTT CITY, MARYLAND

I, HEREBY, APPLY FOR THE NECESSARY TEST IN ORDER TO CONSTRUCT (OR RECONSTRUCT) A SEWAGE DISPOSAL SYSTEM:

PROPERTY OWNER Mr. & Mrs. Charles Green

ADDRESS 1270 Friendship Rd. West DISTRICT 42-2225

PROPERTY LOCATION: Friendship Rd. NE W 2

SUBDIVISION _____ LOT NO. _____

ROAD AND DESCRIPTION 2nd driveway west of 1270 Friendship Rd. West

SIZE OF LOT 1/2 acre 1800 sq. ft. 3 bedrooms 2 1/2 baths

IF NOT SINGLE RESIDENCE DESCRIBE _____

THE SYSTEM INSTALLED UNDER THIS APPLICATION IS ACCEPTABLE ONLY UNTIL PUBLIC FACILITIES BECOME AVAILABLE.

SIGNATURE OF APPLICANT Charles Green

APPROVED BY _____ FOR _____ DATE _____

REJECTED BY _____ FOR _____ DATE _____

HOLD PENDING FURTHER TESTS _____ DATE _____

REASONS FOR REJECTION OR HOLDING 1. Existing house soil fair & loose

2. Found on trench & c tank

5/19/73 Approved hold for permit Not approved until permit fee paid C.B.B. 5/19/73

THIS IS NOT A PERMIT

STATE OF MASSACHUSETTS DEPARTMENT OF HEALTH AND PUBLIC SAFETY BUREAU OF HEALTH SERVICES 100 STATE STREET, BOSTON, MASSACHUSETTS 02109	STATE OF MASSACHUSETTS DEPARTMENT OF HEALTH AND PUBLIC SAFETY BUREAU OF HEALTH SERVICES 100 STATE STREET, BOSTON, MASSACHUSETTS 02109	STATE OF MASSACHUSETTS DEPARTMENT OF HEALTH AND PUBLIC SAFETY BUREAU OF HEALTH SERVICES 100 STATE STREET, BOSTON, MASSACHUSETTS 02109	STATE OF MASSACHUSETTS DEPARTMENT OF HEALTH AND PUBLIC SAFETY BUREAU OF HEALTH SERVICES 100 STATE STREET, BOSTON, MASSACHUSETTS 02109
DATE	DISTRICT	LOCALITY	WELL NO.
		Existing Home	20144

ST ok
 5/8/73
 Approved
 Held
 for
 repair
 per
 C.R.

DATE	TEST NO.	DEPTH	PRE-WET START	STOP	TEST - 1" GROP START	STOP	TIME
	No Tests						
4/25/72	1 V	10 1/2'	TOP	5'	5'	5'	
	2 V						
					50'	6' deep	300
					#2	Trench gravel in	
						& pipe cleaned on	

REMARKS
 TYPE OF SOIL

3B Existing house # 50' Trench open
 Trench #2
 gravel
 10' solid
 40' open pipe