

8/21/96 AM

PERMIT

SEWAGE DISPOSAL SYSTEM

DEPARTMENT OF HEALTH AND MENTAL HYGIENE

NO-records

P 57025A

A REPAIR

DISTRICT 3rd

DATE 8/14/96

DATE SYSTEM APPROVED 8/21/96

INSPECTOR M. Ripkin

HOWARD COUNTY HEALTH DEPARTMENT

BUREAU OF ENVIRONMENTAL HEALTH

~~XXXXXXXX~~ 313-2640

INDEXED

Hatfield

IS PERMITTED TO INSTALL ALTER

ADDRESS _____ PHONE 301 - 854-6172

SUBDIVISION Woodmark, Section 11 LOT 14, Block F ROAD 12225 Heathcliff Court

PROPERTY OWNER Webb

ADDRESS 12225 Heathcliff Court
Ellicott City, Maryland 21042

SEPTIC TANK CAPACITY 1250 GALLONS

NUMBER OF BEDROOMS 4

125 SQUARE FEET PER BEDROOM

LINEAR FEET OF TRENCH REQUIRED 130±

REPAIR - PURPOSE - DRYWELL FAILING

Call for inspection when ground is opened so sanitarian can recommend repair.
07/29/96

SPECS PREV. DISCUSSED W/A. McMillen per CONTRACTOR
INV. 3-4½ BOT 5-6½ 2' STONE 130± TRENCH

PLANS APPROVED BY _____ DATE _____

COVER NO WORK UNTIL INSPECTED AND APPROVED.

NEITHER THE HOWARD COUNTY COUNCIL NOR THE HEALTH DEPARTMENT IS RESPONSIBLE FOR THE SUCCESSFUL OPERATION OF ANY SYSTEM

NOTE: CLEANOUT REQUIRED EVERY 70 FEET OF SEWER LINE AND/OR AT 90° SWEEPS IN LINES FROM HOUSE TO DRAIN FIELDS, 90° ELBOWS NOT ACCEPTABLE.

NOTE: ALL PARTS OF SEPTIC SYSTEMS (I.E. TANK, DISTRIBUTION BOX TRENCHES) TO BE 100 FEET FROM WELL (UNLESS OTHERWISE SPECIFICALLY AUTHORIZED)

NOTE: IF DEEP TRENCH(ES) ARE USED CALL FOR INSPECTION BEFORE AND AFTER PLACING GRAVEL IN TRENCH(ES)

NOTE: NO DRY WELL SHALL EXCEED 15 FOOT IN DIAMETER NO ABSORPTION TRENCH TO EXCEED 100 FEET IN LENGTH

NOTE: ALL PIPE FROM HOUSE TO SEPTIC TANK MUST BE CAST IRON OR SCHEDULE 35/40 PVC OR ABS


PERMIT VOID AFTER TWO YEARS

NOTE: INSTALL STAND PIPE ON SEPTIC TANK AND DRY WELL STAND PIPES MUST BE 6 INCHES IN DIAMETER CAST IRON. CONCRETE OR TERRA COTTA OR PVA OR ABS ACCEPTED. IF TOP OF SEPTIC TANK IS DEEPER THAN 3 FEET. MANHOLE TO GRADE REQUIRED.

NOTE: DISTRIBUTION BOXES MUST HAVE BAFFLES

***INSTALLER IS RESPONSIBLE FOR OBTAINING FINAL APPROVAL ON THIS PERMIT**

P 57025A

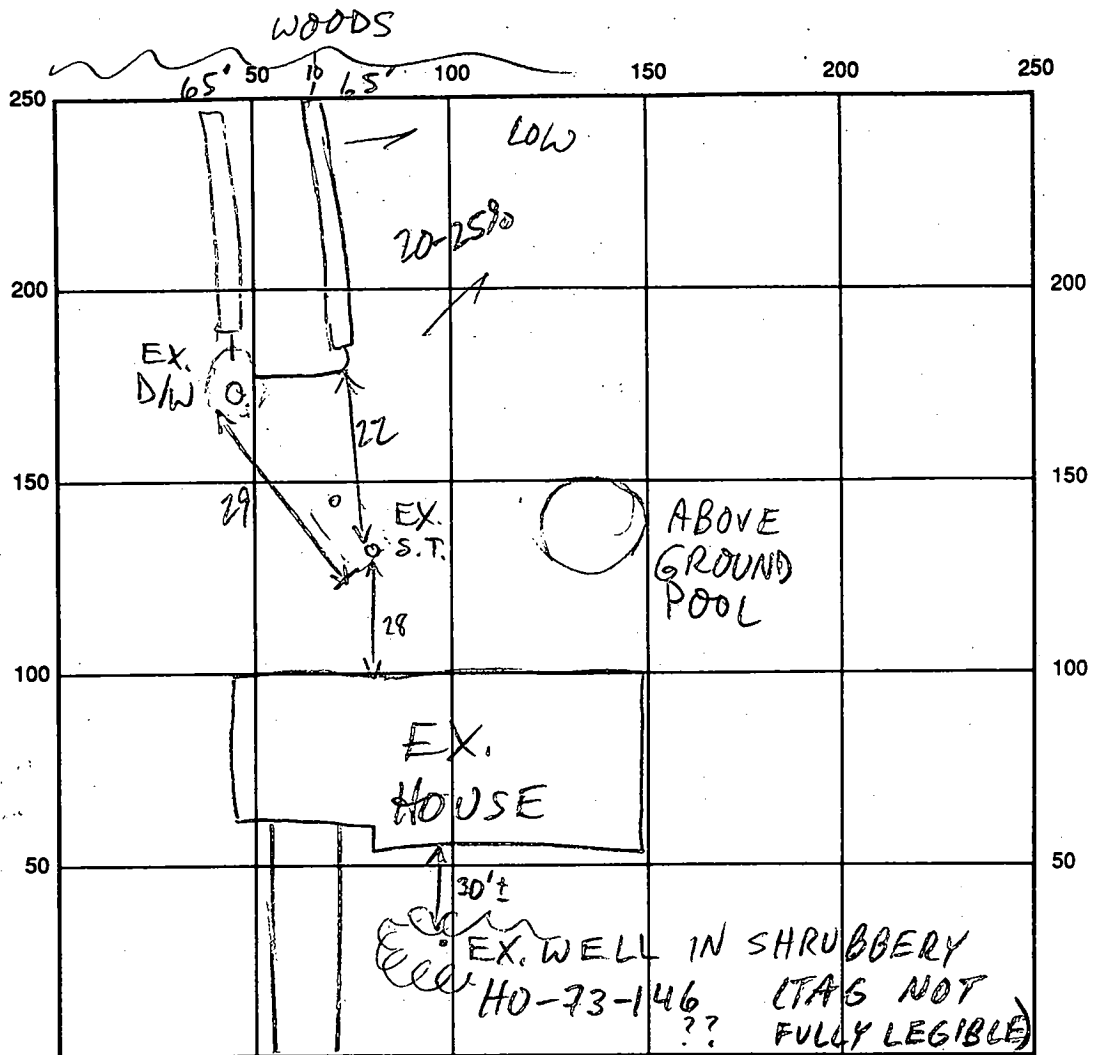

HEATHCLIFF CT

INDICATE NORTH - NAME ADJOINING ROADWAY AS BASE LINE

SEPTIC TANK LEVEL EX. - OK CLEANOUTS EX C/O @ S.T + D/W OK

DISTRIBUTION BOX LEVEL

DRAIN FIELD/TITLE DEPTH 65/5 FT. TRENCH WIDTH 3 FT. INLET DEPTH 4.5/2 FT.

EFFECTIVE GRAVEL DEPTH 2/2 FT. TOTAL LENGTH 2@65 FT.

NUMBER OF TRENCHES 2 ONE-SIDEWALL/BOTTOM AREA 2@195 SQ. FT.

DRYWALL INSIDE DIAMETER FT. EFFECTIVE DEPTH BELOW INLET FT.

ABSORBENT AREA 390 SQ. FT.

REMARKS: 8/21/96 OK TO FINISH + COVER MR

DATE SYSTEM APPROVED 8/21/96 INSPECTOR M. Ripkin

9/10/76
p-77

PERMIT

SEWAGE DISPOSAL SYSTEM

MARYLAND STATE DEPARTMENT OF HEALTH

HOWARD COUNTY

ELLICOTT CITY

DISTRICT 3rd

INDEXED

DATE 9/8/76

Jim Brittingham

IS PERMITTED TO INSTALL ALTER

ADDRESS 3004 N. Rogers Avenue, Ellicott City, Md. 21043 PHONE 461-1870

A SEWAGE DISPOSAL SYSTEM LOCATED AT _____

SUBDIVISION Woodmark ROAD 12225 Hestheliff Road LOT 14, Blk. F, Sec. 11

PROPERTY OWNER Mark Wakefield

ADDRESS Carroll Mill Road, Ellicott City, Md. 21043

SPECIFICATIONS 4 bedrooms

DRAIN FIELD _____ DEPTH _____ FEET, BOTTOM AREA _____ SQ. FT.

SEEPAGE PITS _____ ABSORBENT SIDE-WALL AREA _____ SQ. FT.

SEPTIC TANK CAPACITY 1250 GALLONS

FOR GARBAGE GRINDER, INCREASE DISPOSAL AREA 25% & TANK CAPACITY 50%

OTHER DRY WELL - 480 sq. ft. sidewall area below top 3 ft. of soil. Maximum depth of dry well is 10 1/2 ft. below grade at time of perc test. MAXIMUM DEPTH OF INLET IS 4 ft. Place the dry well 70 ft. from the back lot line and 20 ft. from the left side of the lot as seen when facing the lot from NEAREST ROAD. Lot also suitable for deep ditch. Call sanitarian if ditch desired.

NOTE: ALL PIPE FROM HOUSE TO DISPOSAL AREA MUST BE CAST IRON PERMIT VOID AFTER THREE YEARS.


NOTE: INSTALL STAND PIPE ON SEPTIC TANK AND DRY WELL. STAND PIPES MUST BE 6 INCHES IN DIAMETER. CAST IRON, CONCRETE OR TERRA COTTA ACCEPTED.

PLANS APPROVED BY Raymond Hodges DATE 8/29/76

FILL SEPTIC TANK AND DISTRIBUTION BOX WITH WATER BEFORE CALLING FOR AN INSPECTION. COVER NO WORK UNTIL INSPECTED AND APPROVED.

NEITHER THE HOWARD COUNTY COMMISSIONERS NOR THE HEALTH DEPARTMENT IS RESPONSIBLE FOR THE SUCCESSFUL OPERATION OF ANY SYSTEM.

15392

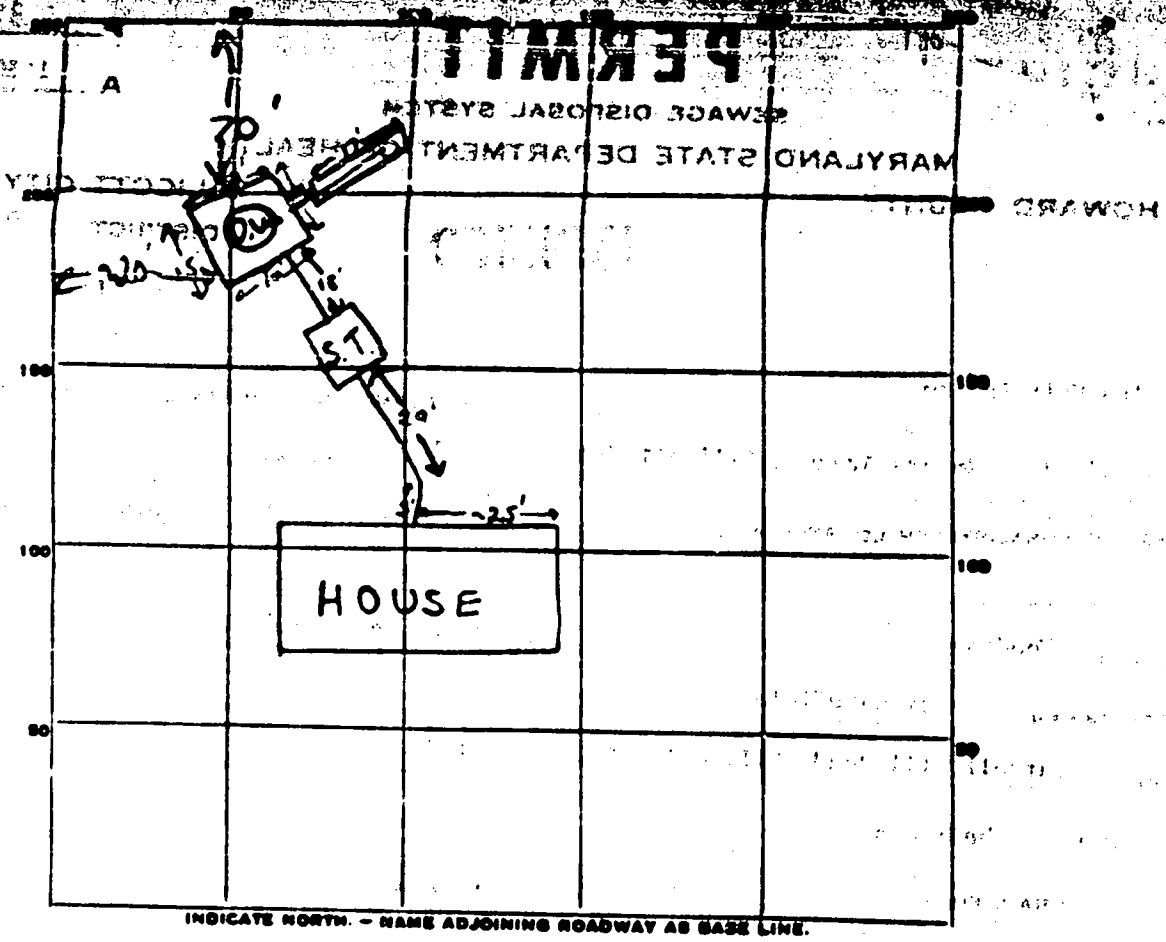

PERMIT CARD signed for ok FS
 SEPTIC TANK, LEVEL 1200 gal CLEANOUTS S.T. / DW
o.k. / o.k.
 DISTRIBUTION BOX, LEVEL _____

TILE FIELD, DEPTH 10 1/2 FT. TRENCH WIDTH 2 FT.

GRAVEL DEPTH 7 FT. TOTAL LENGTH 17 FT.

NUMBER OF TRENCHES 1 1/2 SIDEWALL AREA 119

SEE PAGE PITS, INSIDE DIAMETER 53 FT. DEPTH BELOW INLET 7 FT.

dry well! ABSORBENT AREA 371 SQ. FT. TOTAL Abs. Area 490 SQ. FT.

REMARKS dry well ended at 1/2' FS

DATE SYSTEM APPROVED 9/10/76 INSPECTOR F. Skinner

APPLICATION

A 2892

SEWAGE DISPOSAL TESTING

P _____

STATE OF MARYLAND - DEPARTMENT OF HEALTH AND MENTAL HYGIENE

HOWARD COUNTY HEALTH DEPARTMENT
ENVIRONMENTAL HEALTH SERVICES
P. O. BOX 476, ELLICOTT CITY, MARYLAND 21043
TELEPHONE: 465-6666, EXT. 366

DISTRICT 3rd

DATE 4-30-73

TO: THE COUNTY HEALTH OFFICER
ELLICOTT CITY, MARYLAND

I, HEREBY, APPLY FOR THE NECESSARY TEST IN ORDER TO CONSTRUCT (OR RECONSTRUCT) A SEWAGE DISPOSAL SYSTEM.

PROPERTY OWNER Mark Wakefield

ADDRESS Carpoll Mill Rd., E.C.

PHONE 551-5072

PROPERTY LOCATION:

SUBDIVISION Woodmark

LOT NO. 14, Blk. P., Sec. 11

ROAD AND DESCRIPTION Unnamed Rd.

SIZE OF LOT 48,400 sq. ft.

TYPE BLDG. 3 or 4 Bedrooms
NUMBER OF BEDROOMS

IF NOT SINGLE RESIDENCE DESCRIBE _____

THE SYSTEM INSTALLED UNDER THIS APPLICATION IS ACCEPTABLE ONLY UNTIL PUBLIC FACILITIES BECOME AVAILABLE.

SIGNATURE OF APPLICANT Mark Wakefield /s/

APPROVED BY _____ FOR _____ DATE _____
(KIND OF SYSTEM)


REJECTED BY _____ FOR _____ DATE _____
(KIND OF SYSTEM)

HOLD PENDING FURTHER TESTS _____ DATE _____

REASONS FOR REJECTION OR HOLDING _____

THIS IS NOT A PERMIT

APPLICATION

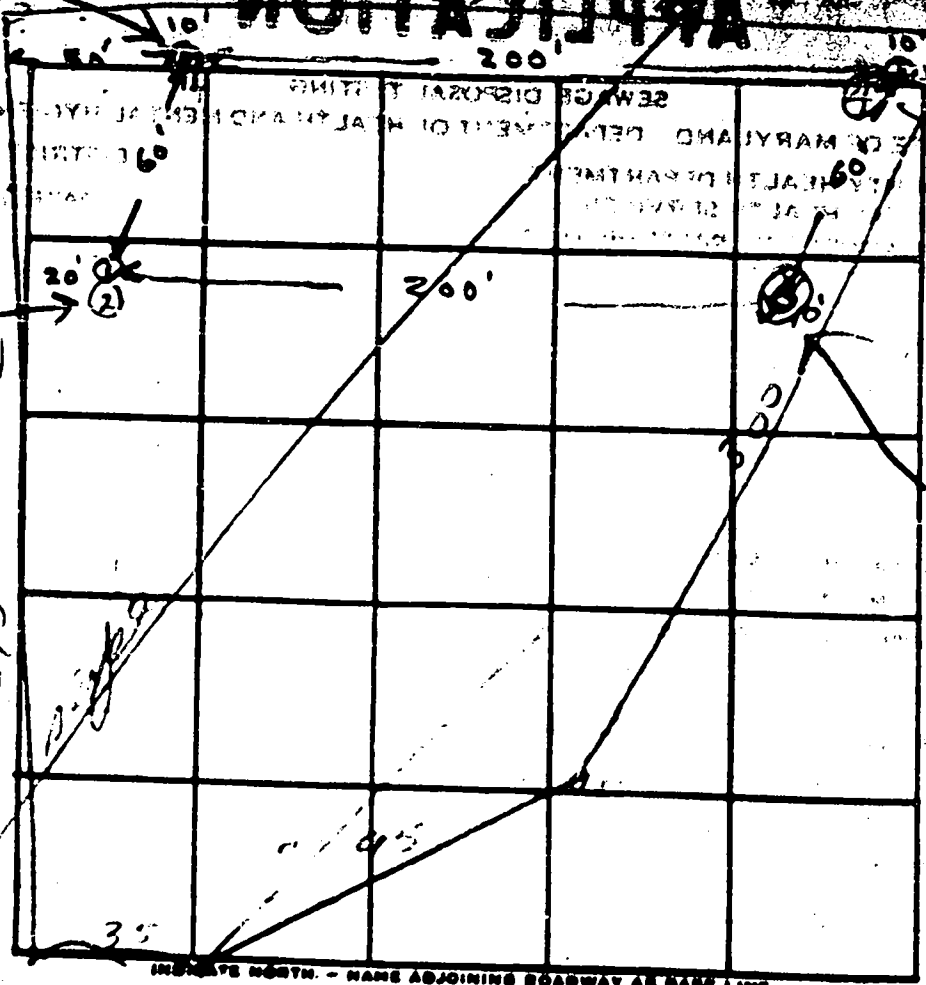

HIGHEST HOLE

LOWEST HOLE

NEXT LOWEST HOLE

DATE	TEST NO.	DEPTH	PRE-WET		TEST - 1" DROP		TIME
			START	STOP	START	STOP	
4/11/73	1	4	128	120	130	136	6
	2	10'	128	129	129	136	7
	3	10'	131	132	133	136	3
	4	4	126	125	127	134	2
	5	9	APP	SPR		DRY	
4/17/73	6	10'	TOP	4"	5"	5"	

Drilled
6 inches
7" depth
4 FT

REMARKS R.H. 6/6/73

TYPE OF SOIL D.M.B. for P.E.T.

14F
sect 11

