

10/24/96
RJP

PERMIT

SEWAGE DISPOSAL SYSTEM

DEPARTMENT OF HEALTH AND MENTAL HYGIENE

P 57349

A REPAIR

DISTRICT 6th

DATE 10-23-96

HOWARD COUNTY HEALTH DEPARTMENT

BUREAU OF ENVIRONMENTAL HEALTH

XXXXXXXX 313-2640

INDEXED

06-405045

DATE SYSTEM APPROVED 10/24/96

INSPECTOR RJP (SR16)

Waterloo Sanitation IS PERMITTED TO INSTALL ALTER X

ADDRESS 7311 Washington Boulevard, Baltimore, Maryland 21227 PHONE 799-1942

SUBDIVISION _____ LOT _____ ROAD 10625 Gorman Road

PROPERTY OWNER Gordon Hanlin

ADDRESS 10625 Gorman Road
Laurel, Maryland 20810

SEPTIC TANK CAPACITY 1000 GALLONS

***PURPOSE FOR REPAIR: _____ Failed
Septic System

NUMBER OF BEDROOMS _____

_____ SQUARE FEET PER BEDROOM

Approval for B.P.
Future Addition

LINEAR FEET OF TRENCH REQUIRED _____

REPAIR - PURPOSE - SEPTIC TANK HAS COLLASPED.

Call for inspection when tank is in place so that a sanitarian can approve size and location.

(PUBLIC WORKS CONFIRMS PUBLIC SEWER NOT ACCESSIBLE CW/ALM)

PLANS APPROVED BY CWilliams DATE 10/23/96

COVER NO WORK UNTIL INSPECTED AND APPROVED

NEITHER THE HOWARD COUNTY COUNCIL NOR THE HEALTH DEPARTMENT IS RESPONSIBLE FOR THE SUCCESSFUL OPERATION OF ANY SYSTEM

NOTE: CLEANOUT REQUIRED EVERY 70 FEET OF SEWER LINE AND/OR AT 90° SWEEPS IN LINES FROM HOUSE TO DRAIN FIELDS, 90° ELBOWS NOT ACCEPTABLE.

NOTE: ALL PARTS OF SEPTIC SYSTEMS (I.E. TANK, DISTRIBUTION BOX TRENCHES) TO BE 100 FEET FROM WELL (UNLESS OTHERWISE SPECIFICALLY AUTHORIZED)

NOTE: IF DEEP TRENCH(ES) ARE USED CALL FOR INSPECTION BEFORE AND AFTER PLACING GRAVEL IN TRENCH(ES)

NOTE: NO DRY WELL SHALL EXCEED 15 FOOT IN DIAMETER NO ABSORPTION TRENCH TO EXCEED 100 FEET IN LENGTH

NOTE: ALL PIPE FROM HOUSE TO SEPTIC TANK MUST BE CAST IRON OR SCHEDULE 35/40 PVC OR ABS


PERMIT VOID AFTER TWO YEARS

NOTE: INSTALL STAND PIPE ON SEPTIC TANK AND DRY WELL STAND PIPES MUST BE 6 INCHES IN DIAMETER CAST IRON. CONCRETE OR TERRA COTTA OR PVA OR ABS ACCEPTED. IF TOP OF SEPTIC TANK IS DEEPER THAN 3 FEET. MANHOLE TO GRADE REQUIRED.

NOTE: DISTRIBUTION BOXES MUST HAVE BAFFLES

***INSTALLER IS RESPONSIBLE FOR OBTAINING FINAL APPROVAL ON THIS PERMIT**


R57349

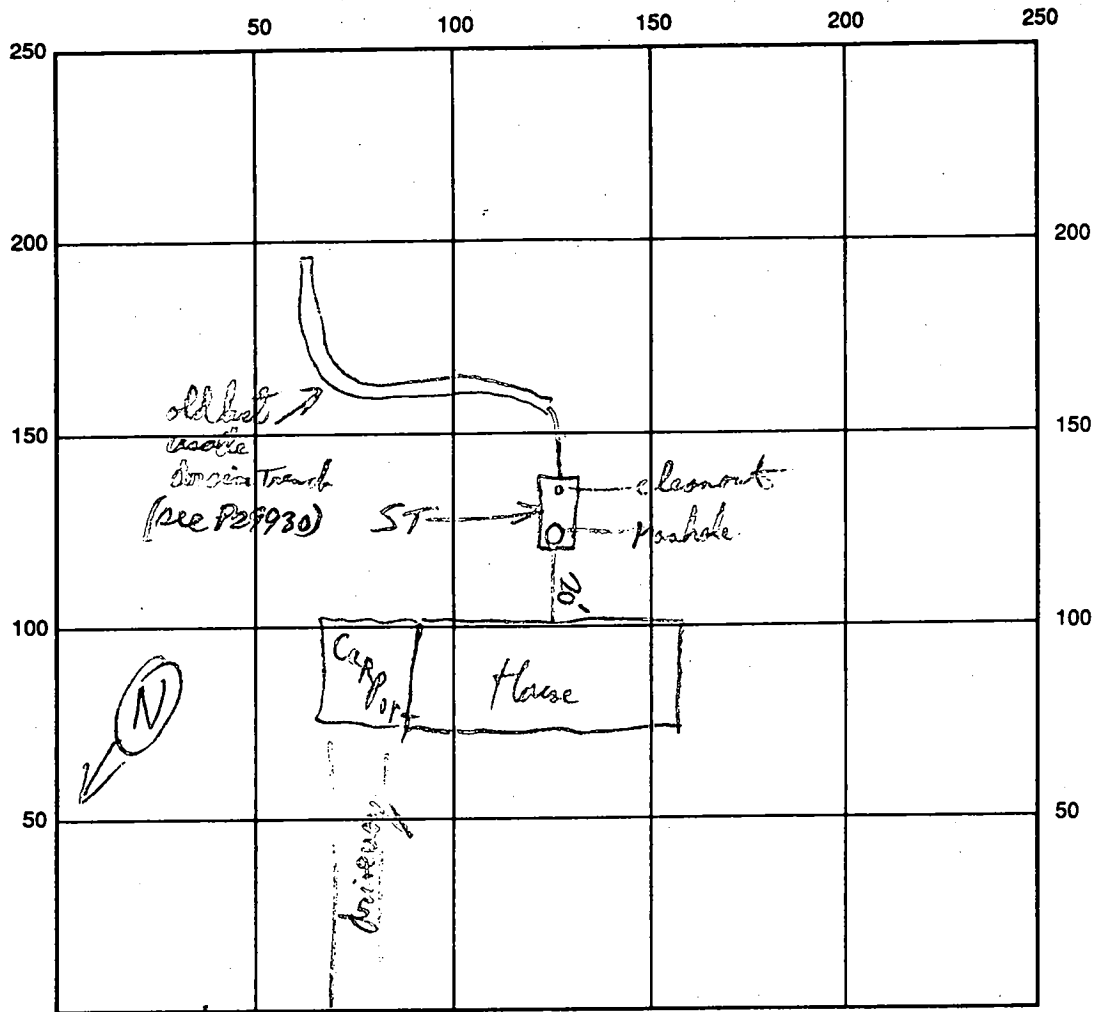

Groundwater INDICATE NORTH - NAME ADJOINING ROADWAY AS BASE-LINE

SEPTIC TANK LEVEL 1000 gal (1185 sq ft) CLEANOUTS 4 washholes at ST.
 DISTRIBUTION BOX LEVEL Top 2 1/2 ft below grade
 DRAIN FIELD/TITLE DEPTH existing Septic Line - No Change FT. TRENCH WIDTH FT. INLET DEPTH FT.
 EFFECTIVE GRAVEL DEPTH FT. TOTAL LENGTH FT.
 NUMBER OF TRENCHES ONE SIDEWALL/BOTTOM AREA SQ. FT.
 DRYWALL INSIDE DIAMETER FT. EFFECTIVE DEPTH BELOW INLET FT.
 ABSORBENT AREA SQ. FT.

REMARKS: No evidence of Septic Drain field problem. entire area is enclosed - soils are excellent for Septic system -
pro recent filling - No evidence of seepage) and soils are excellent for Septic system.
Replace for septic tank which covered last week. - also old connections pipes are being
replaced with cast iron from House to S.T. and sched 40 PVC from Tank to old septic line
OK to Cover Riff 10/24/96

DATE SYSTEM APPROVED 10/24/96 INSPECTOR Ronald J. Ludwig 

Approved 6/19/79
J. Stayer

PERMIT

P 29930
A Repair

SEWAGE DISPOSAL SYSTEM
MARYLAND STATE DEPARTMENT OF HEALTH*

HOWARD COUNTY

ELLICOTT CITY

DISTRICT 6th

INDEXED

DATE 6/18/79

Jenkins Brothers IS PERMITTED TO INSTALL ALTER X

ADDRESS Route 144, Ellicott City, Md. PHONE 465-6646

SUBDIVISION _____ ROAD 10625 Gorman Road LOT _____

PROPERTY OWNER Gordon Hanlin

ADDRESS 10625 Gorman Road, Laurel, Md. 20810

SPECIFICATIONS

SEPTIC TANK CAPACITY _____ GALLONS
DRAIN FIELD _____ DEPTH _____ FEET, BOTTOM AREA _____ SQ. FT.
DEEP TRENCH _____ DEPTH _____ FEET, BOTTOM AREA _____ SQ. FT.
SEEPAGE PITS _____ ABSORBENT SIDE-WALL AREA _____ SQ. FT.
INLET PIPE _____ FT. BELOW ORIGINAL GRADE. MAXIMUM DEPTH _____ FT. BELOW ORIGINAL GRADE
EFFECTIVE DEPTH AT _____ FT. BELOW ORIGINAL GRADE.
LOCATE DISPOSAL AREA _____ FT. FROM _____ LOT LINE AND _____ FT. FROM _____ LOT LINE AS SEEN WHEN
FACING LOT FROM

TRENCH - 60 ft. long, 11 ft. deep, 6 ft. of stone under pipe. 5 ft. earth buffer
from septic tank to trench. Trench to follow contour of land.

PLANS APPROVED BY James Stayer DATE 6/18/79

COVER NO WORK UNTIL INSPECTED AND APPROVED.

NEITHER THE HOWARD COUNTY COUNCIL NOR THE HEALTH DEPARTMENT IS RESPONSIBLE FOR THE SUCCESSFUL OPERATION OF ANY SYSTEM.

NOTE: IF TRENCH IS USED CALL FOR INSPECTION BEFORE PLACING GRAVEL IN TRENCH.

NOTE: NO DRY WELL SHALL EXCEED 15 FOOT IN DIAMETER.


NOTE: ALL PIPE FROM HOUSE TO DISPOSAL AREA MUST BE CAST IRON.

PERMIT VOID AFTER THREE YEARS.

NOTE: INSTALL STAND PIPE ON SEPTIC TANK AND DRY WELL. STAND PIPES MUST BE 6 INCHES IN DIAMETER. CAST IRON, CONCRETE OR TERRA
COTTA ACCEPTED.

***INSTALLER IS RESPONSIBLE FOR OBTAINING FINAL APPROVAL ON THIS PERMIT.**

P
29930

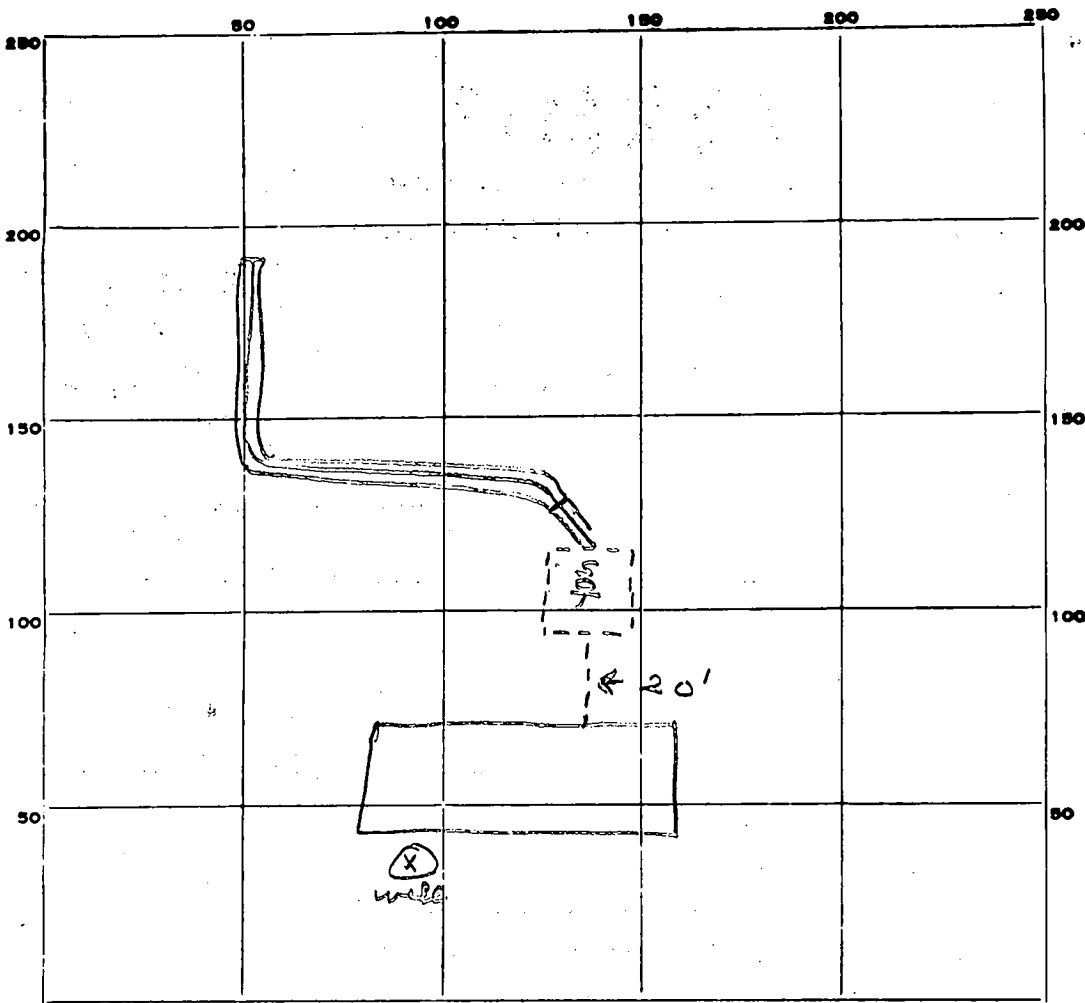

INDICATE NORTH. - NAME ADJOINING ROADWAY AS BASE LINE.

Gorman Rd

PERMIT CARD _____

SEPTIC TANK, LEVEL _____

CLEANOUTS _____

DISTRIBUTION BOX, LEVEL _____

TILE FIELD, DEPTH 11 FT. TRENCH WIDTH 2 FT.

GRAVEL DEPTH 6 ^{ft} IN. TOTAL LENGTH 60 FT.

NUMBER OF TRENCHES 1 TOTAL BOTTOM AREA 360

SEEPAGE PITS, INSIDE DIAMETER _____ FT. DEPTH BELOW INLET _____ FT.

ABSORBENT AREA 360 SQ. FT.

REMARKS 6/18/79 - OK given to owner work after
gravel & pipe added. Owners, Mr. Hamlin, will
give written verification of gravel depth. J

DATE SYSTEM APPROVED 6/18/79 INSPECTOR J. Stayer

6/18/79

HOWARD County Health Dept.

P.O. Box 476

Ellicott City

Gordon Hamlin

10625 Gorman Rd

Laurel, Md.

This is to verify that there is a feet
of gravel in the 60 ft ^{long} trench on the
above property.

Gordon Hamlin
(owner)

Repair Perce
6/18/79
9:30 A.M.

APPLICATION

SEWAGE DISPOSAL TESTING

STATE OF MARYLAND - DEPARTMENT OF HEALTH AND MENTAL HYGIENE

A _____
P _____

HOWARD COUNTY HEALTH DEPARTMENT
ENVIRONMENTAL HEALTH SERVICES
P.O. BOX 476 ELLICOTT, MARYLAND 21043
TELEPHONE: 992-2330

DISTRICT 6th
DATE 6/18/79

TO: THE COUNTY HEALTH OFFICER
ELLICOTT CITY, MARYLAND

I, HEREBY, APPLY FOR THE NECESSARY TEST IN ORDER TO CONSTRUCT (OR RECONSTRUCT) A SEWAGE DISPOSAL SYSTEM.

PROPERTY OWNER Gordon Hanlin
ADDRESS 10625 Gorman Road, Laurel, Md. PHONE _____

PROPERTY LOCATION _____
SUBDIVISION _____ LOT NO. _____
ROAD AND DESCRIPTION 10625 Gorman Road
SIZE OF LOT ? TYPE BLDG. ?

THE SYSTEM INSTALLED UNDER THIS APPLICATION IS ACCEPTABLE ONLY UNTIL PUBLIC FACILITIES BECOME AVAILABLE.

I FULLY UNDERSTAND THE FEE CONNECTED WITH THE FILING OF THIS PERC TEST APPLICATION IS NON-REFUNDABLE UNDER

ANY CIRCUMSTANCES.

SIGNATURE OF APPLICANT /s/ Jenkins Brothers

APPROVED BY [Signature] FOR 60pts. tested DATE 6/18/79

REJECTED BY _____ FOR _____ DATE _____

HOLD PENDING FURTHER TESTS _____ DATE _____

REASONS FOR REJECTION OR HOLDING _____

THIS IS NOT A PERMIT

