

APPLICATION

A 12571

SEWAGE DISPOSAL TESTING

P _____

MARYLAND STATE DEPARTMENT OF HEALTH

HOWARD COUNTY

ELLICOTT CITY

DISTRICT 4DATE 4/7/67TO: THE COUNTY HEALTH OFFICER
ELLICOTT CITY, MARYLAND

I, HEREBY, APPLY FOR THE NECESSARY TESTS IN ORDER TO CONSTRUCT (OR RECONSTRUCT) A SEWAGE DISPOSAL SYSTEM.

PROPERTY OWNER Sam MullinixADDRESS St. Michael's Rd., Mt. Airy, Md. PHONE _____

PROPERTY LOCATION:

SUBDIVISION _____ LOT NO. _____

ROAD AND DESCRIPTION St. Michael's Rd. - 1st lane on left after passing the
St. Michael's Catholic Church on the
right

OCCUPANT _____ PHONE _____

PERSON TO CONSTRUCT SYSTEM _____


ADDRESS _____ PHONE _____

SIZE OF LOT 200 + acres TYPE BLDG. Existing houseIF NOT SINGLE RESIDENCE DESCRIBE _____
NUMBER OF BEDROOMS
(Single Fmly. Dwlg.)SIGNATURE OF APPLICANT Howard L. PickettAPPROVED BY Donald W. Morgan FOR Dry Well DATE 4-11-67
(KIND OF SYSTEM)REJECTED BY _____ FOR _____ DATE _____
(KIND OF SYSTEM)

HOLD PENDING FURTHER TESTS _____ DATE _____

REASONS FOR REJECTION OR HOLDING _____

THIS IS NOT A PERMIT

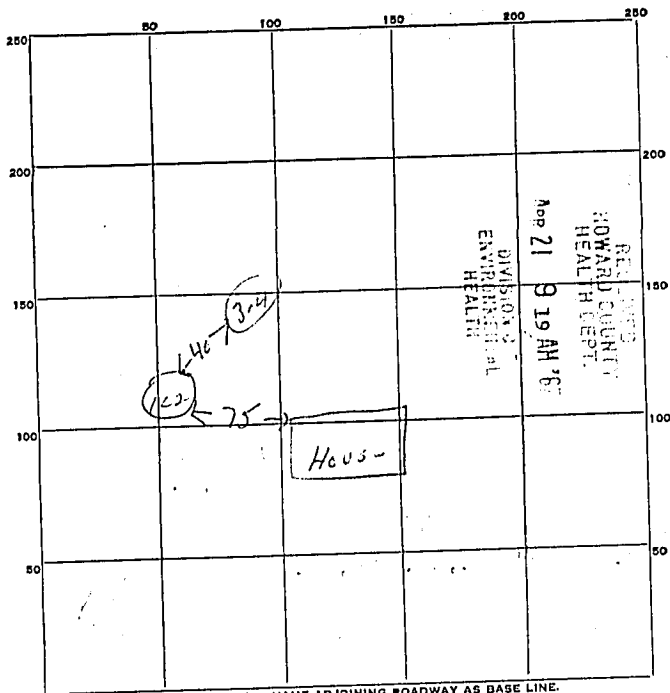

INDICATE NORTH. - NAME ADJOINING ROADWAY AS BASE LINE.

57 Michaels Rd.

DATE	TEST NO.	DEPTH	PRE-WET		TEST - 1" DROP		TIME
			START	STOP	START	STOP	
4/11/67	1	9ft	9 32	9 48	9 45	10 02	22 min
	2	7ft	9 37	9 55	9 55	4 45	100 min
	3	9ft	not tested same type		sand		
	4	4ft	sand & shale				

SOIL AUGER FINDING

TESTED BY

DUM

REMARKS

12ft of - cast iron pipe leaked from well.
 no present