

12/10/96
1PM
12/16/96
1:00 tank replacement
line replacement

PERMIT

SEWAGE DISPOSAL SYSTEM

DEPARTMENT OF HEALTH AND MENTAL HYGIENE

P 57558C

A REPAIR

DISTRICT _____

DATE 11/19/96

DATE SYSTEM APPROVED 12/10/96

INSPECTOR DKS/KAM

HOWARD COUNTY HEALTH DEPARTMENT

BUREAU OF ENVIRONMENTAL HEALTH

~~XXXXXXXX~~ 313-2640

05-350476

INDEXED

Jack Fyock Septic Service _____ IS PERMITTED TO INSTALL _____ ALTER X

ADDRESS 4105 Ten Oaks Road, Dayton, Maryland 21036 PHONE 988-9270

SUBDIVISION _____ LOT _____ ROAD 12940 Route 108

PROPERTY OWNER Scott Glenn 301 854-3289
12940 Route 108

ADDRESS Highland, Maryland 20777

SEPTIC TANK CAPACITY Existing GALLONS

NUMBER OF BEDROOMS 4 (Proposed)

125 SQUARE FEET PER BEDROOM

LINEAR FEET OF TRENCH REQUIRED 91±

SUPPORTING DOCUMENTATION MISPLACED
APPLICANT INTENDS TO APPLY FOR BUILDING PERMIT,
FOR THIS ADDITION, IN JAN, 97

BUDG. PERMIT SIGNED

AND RETURNED 3-72-97

Serial # 61010 4389-
1 story addition - 2 bedroom

REPAIR - PURPOSE - TO SUPPORT THE PROPOSED ADDITION - INCREASE IN THE NUMBER OF BEDROOMS FROM 3, TO 4.

Call for inspection when ground is opened so sanitarian can recommend repair.

Install trenches off existing system. Trenches to run
on contour parallel to Route 108.

11/18/96

Trenches to be 2' wide, inlet 5.5', bottom 11.0', slope 5.5'.

PLANS APPROVED BY Sandra K Sol / KAM DATE 12/10/96

COVER NO WORK UNTIL INSPECTED AND APPROVED

NEITHER THE HOWARD COUNTY COUNCIL NOR THE HEALTH DEPARTMENT IS RESPONSIBLE FOR THE SUCCESSFUL OPERATION OF ANY SYSTEM

NOTE: CLEANOUT REQUIRED EVERY 70 FEET OF SEWER LINE AND/OR AT 90° SWEEPS IN LINES FROM HOUSE TO DRAIN FIELDS, 90° ELBOWS NOT ACCEPTABLE.

NOTE: ALL PARTS OF SEPTIC SYSTEMS (I.E. TANK, DISTRIBUTION BOX TRENCHES) TO BE 100 FEET FROM WELL (UNLESS OTHERWISE SPECIFICALLY AUTHORIZED)

NOTE: IF DEEP TRENCH(ES) ARE USED CALL FOR INSPECTION BEFORE AND AFTER PLACING GRAVEL IN TRENCH(ES)

NOTE: NO DRY WELL SHALL EXCEED 15 FOOT IN DIAMETER NO ABSORPTION TRENCH TO EXCEED 100 FEET IN LENGTH

NOTE: ALL PIPE FROM HOUSE TO SEPTIC TANK MUST BE CAST IRON OR SCHEDULE 35/40 PVC OR ABS


PERMIT VOID AFTER TWO YEARS

NOTE: INSTALL STAND PIPE ON SEPTIC TANK AND DRY WELL STAND PIPES MUST BE 6 INCHES IN DIAMETER CAST IRON, CONCRETE OR TERRA COTTA OR PVA OR ABS ACCEPTED. IF TOP OF SEPTIC TANK IS DEEPER THAN 3 FEET. MANHOLE TO GRADE REQUIRED.

NOTE: DISTRIBUTION BOXES MUST HAVE BAFFLES

***INSTALLER IS RESPONSIBLE FOR OBTAINING FINAL APPROVAL ON THIS PERMIT**

P 57558C

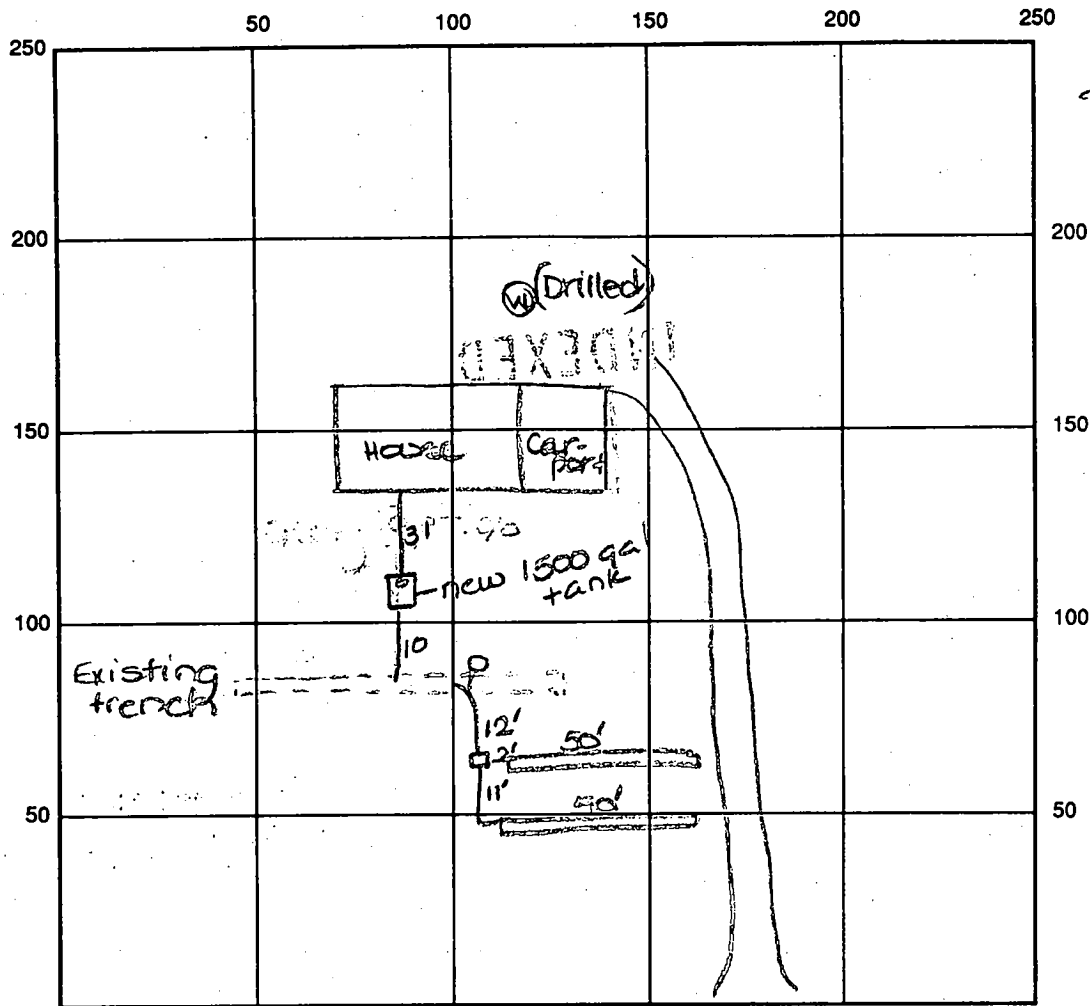

INDICATE NORTH - NAME ADJOINING ROADWAY AS BASE LINE

Route 108

SEPTIC TANK LEVEL Existing CLEANOUTS in line (to accommodate future tank repl.)

DISTRIBUTION BOX LEVEL OK

DRAIN FIELD/TITLE DEPTH 11.0 FT. TRENCH WIDTH 2 FT. INLET DEPTH 5.5 FT.

EFFECTIVE GRAVEL DEPTH 5.5 FT. TOTAL LENGTH 2 x 50 FT. → 100'

NUMBER OF TRENCHES 2 ONE SIDEWALL/BOTTOM AREA 550 SQ. FT.

DRYWALL INSIDE DIAMETER — FT. EFFECTIVE DEPTH BELOW INLET — FT.

ABSORBENT AREA 550 SQ. FT.


REMARKS: 12/10/96 FINAL INSP - OK TO COVER WORK AS completed. Sufficient materials at site. DLS/KMM
12/16/96 OK to cover replacement line as installed - too muddy to leave open ALM
12/16/96 New 1800 gal tank installed & line from house to tank & tank to DB installed OK to cover ALM

Note: Tank replacement was permitted under field replacement permit ALM

DATE SYSTEM APPROVED 12/10/96 INSPECTOR D. Miller & S. Miller # Army
12/16/96 M. Miller

Approved Septic System Plan
Howard County Health Department

Frank Shenn
Signature
43,560.90 SQ. FT. 3-12-97

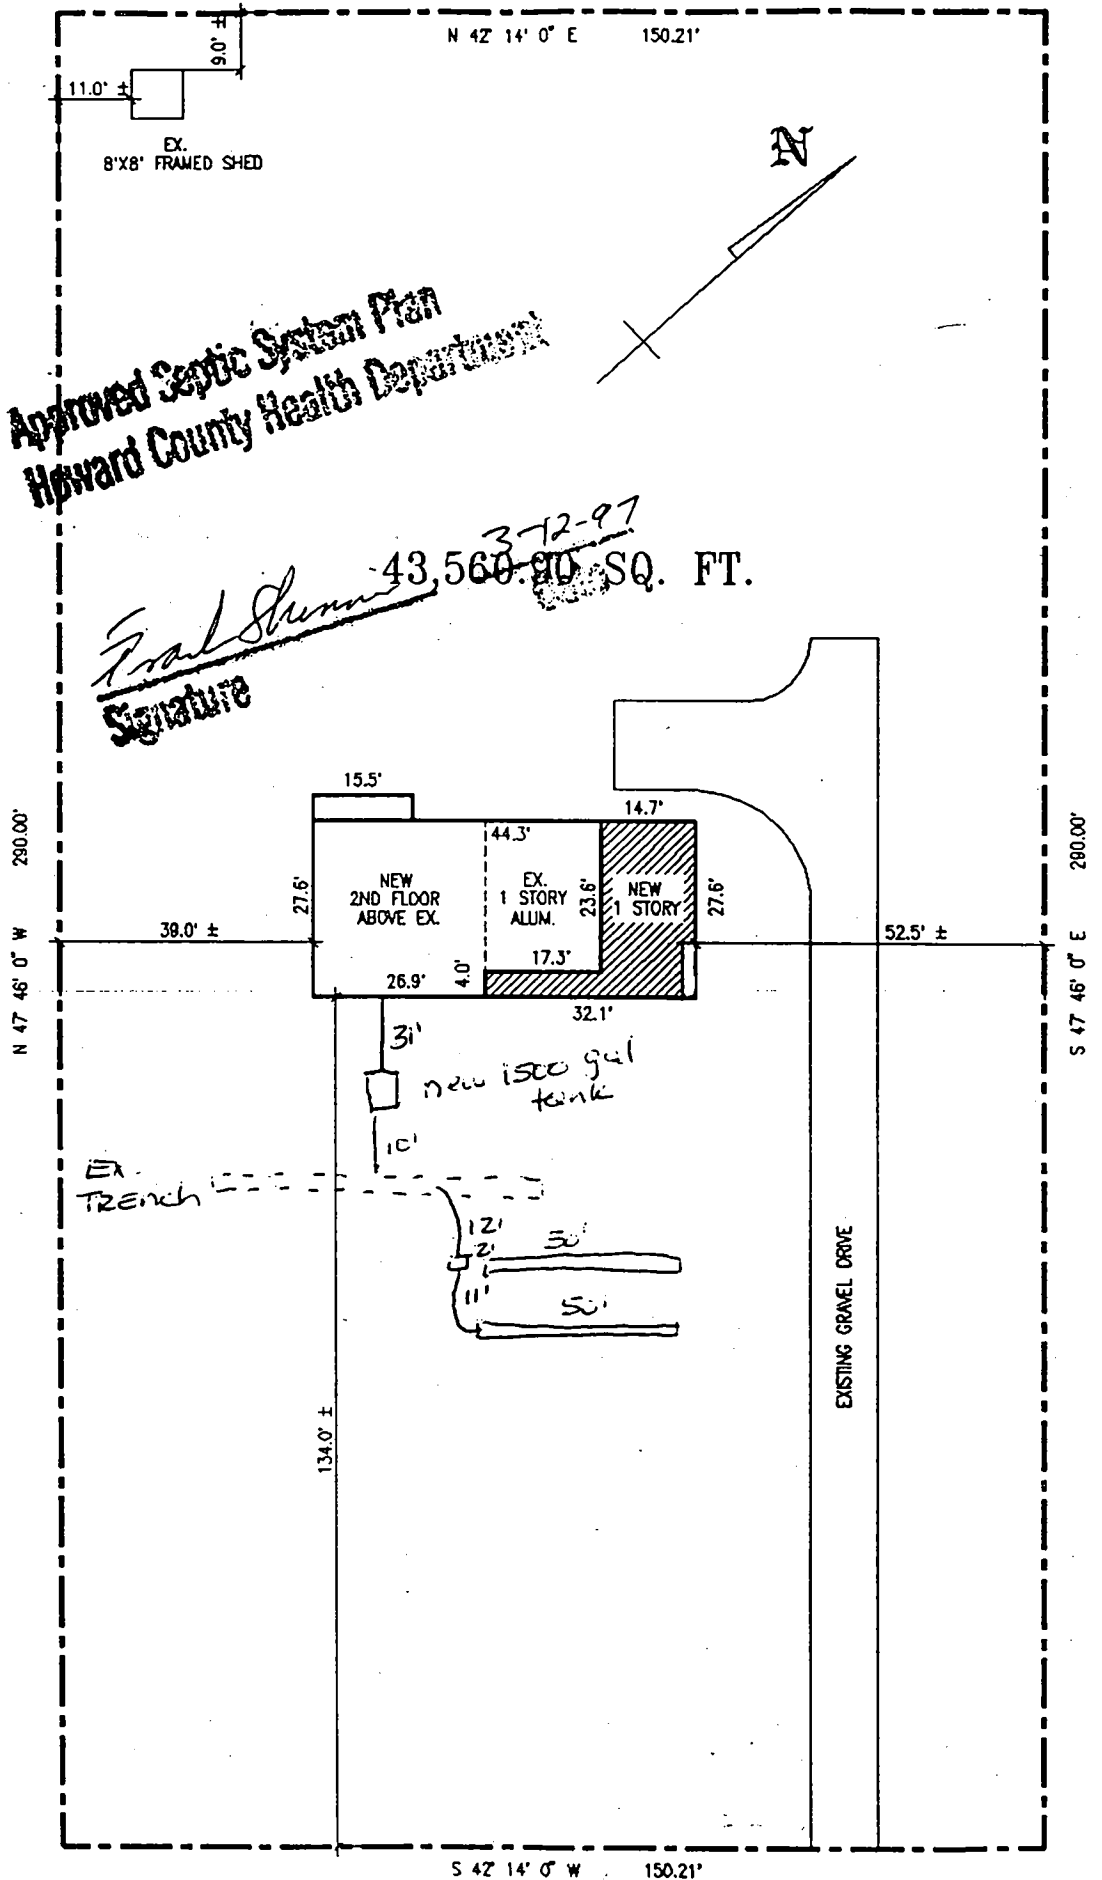

SCALE 1" = 30'
DATE: 1-22-97

LOCATION DRAWING
LIBER 1106 FOLIO 201
HOWARD COUNTY, MARYLAND

CLARKSVILLE PIKE (ROUTE 108)

APPLICATION

HOWARD COUNTY

SERIAL NUMBER

PERMIT APPLICATION

DEPARTMENT OF INSPECTIONS, LICENSES & PERMIT

3430 COURT HOUSE DRIVE, ELLICOTT CITY, MARYLAND 21043

B00101389

BUILDING ADDRESS (HOUSE NO., STREET, TOWN OR AREA)
12940 ~~Highland~~ Clarksville Pike
Highland MD 20777 28606

GRADING/SEDIMENT CONTROL YES NO SDP #

DESCRIPTION OF WORK AUTHORIZED
Sub addition + 2nd Fl
partial addition (2 bedrooms
office 1 full bath)

LOT NO.	PARCEL NO.	SEC.	AREA	BLOCK NO.	LIBER.	FOLIO.
	131			23	1106	201
SUB DIVISION		ZONE	ZONE MAP	ELEC. DIST.	CENSUS TR.	
		RPD	34	5	6051.01	

OWNER NAME AND ADDRESS
Mr & Mrs Scott Glenn
12940 Route 102
Highland Md 20777
PHONE NO. 301-854-3299

SIZE OF BLDG.	FRONT	DEPTH	HEIGHT

OCCUPANT'S NAME AND ADDRESS
Same
PHONE NO.

TYPE OF BLDG.	AREA	VOLUME	ROOF
B. ROOMS			
ROOMS			
BATHS			
FIREPLACES			

ARCHITECT OR ENGINEER'S NAME AND ADDRESS
Workman - Hutchison
11-20 Parktown Dr.
Rockville Md 20857
PHONE NO. 301-770-9163

FOOTINGS	FOUNDATION	S. WALLS

CONTRACTOR'S NAME AND ADDRESS
JAT CONSTRUCTION, INC
17105 Quarter Horse Way
Olney Md 20832
PHONE NO. 301-924-1128

UTILITIES			
WATER	SEWER/SEPTIC	GAS	ELECTRICITY
Well	Septic		DN
			TYPE OF HEAT
			AC

I have carefully examined and read this application and know the same is true and correct, and that in doing this work, all provisions of Howard County Ordinances and the State Laws of Maryland will be complied with, whether specified or not; and I will notify the Department of Inspections, and Permit twenty-four hours in advance when I am ready for the inspection. Call for elsewhere in the application; and that no work will be covered up until such inspection has been completed.
[Signature]

EXISTING USE Single Fam Dwelling	PROPOSED USE Some w/ addition
EST. CONSTRUCTION COST 100,000.00	LICENSE NUMBER 28857
	PERMIT FEE

[Signature]
TITLE DATE
3/12/97

W/S CODE FOR OFFICE USE ONLY

DISTANCE IN FEET FROM R/W LINE TO FRONT BUILDING LINE _____
SIDE YARD _____
(DISTANCE IN FEET FROM SIDE BLDG. LINE TO SIDE PROPERTY LINE)
TO SIDE BUILDING LINE _____
DISTANCE IN FEET, REAR YD. REQUIRING SET _____
BACK _____ (CORNER LOT ONLY)
SDP # _____

FUNCTION	DATE	SIGNATURE APPROVAL
ZONING/PLANNING		
SHA		
SEDIMENT/GRADING		
BUILDING OFFICIAL		
WATER & SEWER	3-12-97	<i>[Signature]</i>
HEALTH DEPT	3-12-97	<i>[Signature]</i>
FIRE PROTECTION		
STORM WATER MGM		

Check payable to: DIRECTOR OF FINANCE OF HOWARD COUNTY

CAUTION
To begin construction before a permit placard has been issued and displayed on the job is a violation of the law.
Use and occupancy permit must be applied for two weeks before it will be issued.

IMPORTANT: PLEASE SHOW ZIP CODES AND AREA CODES WHEREVER REQUIRED

LP-69-591
H 15 101

APPROVED _____ DATE _____
Distribution of Copies:
White - Building Official
Green - Planning & Zoning
Yellow - Engineering
Pink - Health Dept.
Gold - S.H.A.