

4/10/67  
Ready

4-10-67  
2071

# PERMIT

SEWAGE DISPOSAL SYSTEM

P 12561

A \_\_\_\_\_

MARYLAND STATE DEPARTMENT OF HEALTH

HOWARD COUNTY

ELLICOTT CITY

DISTRICT 4

DATE 4/3/67

INDEXED

Herman Sirk IS PERMITTED TO INSTALL \_\_\_\_\_ ALTER

ADDRESS Annapolis Rock Road, Woodbine, Md. PHONE HU 9-4724

A SEWAGE DISPOSAL SYSTEM LOCATED AT \_\_\_\_\_

SUBDIVISION \_\_\_\_\_ ROAD <sup>1060</sup> Daisy Rd. - off Rt. 146r (144)  
approx. 3/4 mile on right - brick house

PROPERTY OWNER Richard Mullinix

ADDRESS \_\_\_\_\_

SPECIFICATIONS

DRAIN FIELD \_\_\_\_\_ DEPTH \_\_\_\_\_ FEET, BOTTOM AREA \_\_\_\_\_ SQ. FT.

SEEPAGE PITS \_\_\_\_\_ ABSORBENT SIDE-WALL AREA \_\_\_\_\_ SQ. FT.

SEPTIC TANK CAPACITY \_\_\_\_\_ GALLONS

FOR GARBAGE GRINDER, INCREASE DISPOSAL AREA 22% & TANK CAPACITY 50%.

OTHER REPAIR - Trench 4 ft. wide, 30 ft. long and approx. 15 ft. <sup>deep</sup> with

8 ft. of stone to be connected to existing dry well.

PLANS APPROVED BY \_\_\_\_\_ DATE 4/3/67


FILL SEPTIC TANK AND DISTRIBUTION BOX WITH WATER BEFORE CALLING FOR AN INSPECTION. COVER NO WORK UNTIL INSPECTED AND APPROVED.

NEITHER THE HOWARD COUNTY COMMISSIONERS NOR THE HEALTH DEPARTMENT IS RESPONSIBLE FOR THE BLDG. PERMIT SIGNED AND RETURNED

7/18/65 - check  
Sirt # 65783 - final

## NOTIFY THE HEALTH DEPARTMENT 48 HOURS BEFORE EXCAVATIONS ARE TO BE BACK FILLED.

P 12561

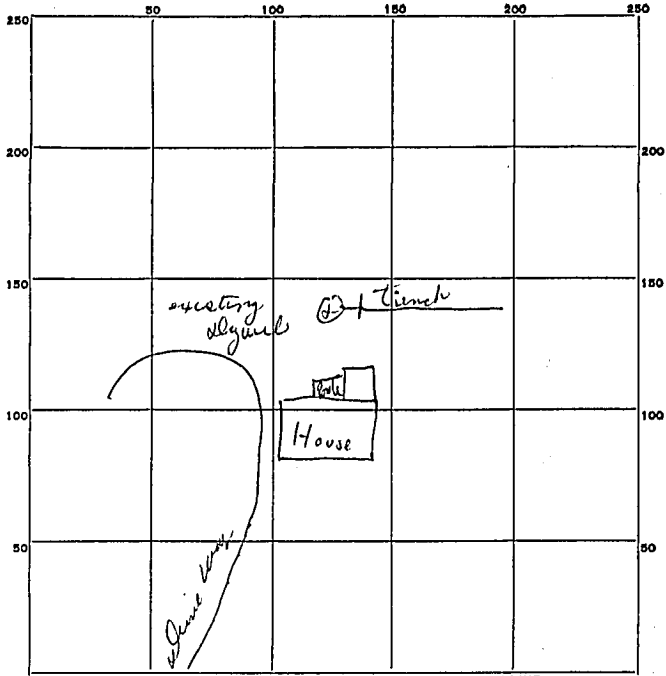

INDICATE NORTH. - NAME ADJOINING ROADWAY AS BASE LINE.

*Living Rd*

RECEIVED  
HOWARD COUNTY  
HEALTH DEPT.  
APR 10 11 44 AM '67  
DIVISION OF  
ENVIRONMENTAL  
HEALTH

35  
9  
315

PERMIT CARD S. 10

SEPTIC TANK, LEVEL \_\_\_\_\_ CLEANOUTS \_\_\_\_\_

DISTRIBUTION BOX, LEVEL \_\_\_\_\_

TILE FIELD, DEPTH \_\_\_\_\_ FT. TRENCH WIDTH \_\_\_\_\_ FT.

GRAVEL DEPTH \_\_\_\_\_ IN. TOTAL LENGTH \_\_\_\_\_ FT.

NUMBER OF TRENCHES \_\_\_\_\_ TOTAL BOTTOM AREA \_\_\_\_\_

SEEPAGE PITS, INSIDE DIAMETER \_\_\_\_\_ FT. DEPTH BELOW INLET \_\_\_\_\_ FT.

ABSORBENT AREA \_\_\_\_\_ SQ. FT.

REMARKS 4-10-67 - trench 4 ft wide - 35 ft long - 9 ft of gravel under pipe - 630 sq  
ft sidewalk area installed off old driveway

DATE SYSTEM APPROVED 4-10-67 INSPECTOR Bill Managhai