

11/8/68
after 7:30 am

OFF 11-8-68
13602

PERMIT

P-13983

SEWAGE DISPOSAL SYSTEM

A-13602

MARYLAND STATE DEPARTMENT OF HEALTH

HOWARD COUNTY

ELLICOTT CITY

INDEXED

DISTRICT 4

DATE 10/1/68

William T. Hood - *Handwritten Signature* IS PERMITTED TO INSTALL ALTERN

ADDRESS Mt. Airy, Maryland PHONE 489-4605

A SEWAGE DISPOSAL SYSTEM LOCATED AT _____

SUBDIVISION _____ ROAD Daisy Road - 8/10 LOT _____

mile in off Rt. 144 - right hand side

PROPERTY OWNER Carl Oland & wife

ADDRESS _____

SPECIFICATIONS - 3 bedrooms

DRAIN FIELD _____ DEPTH _____ FEET, BOTTOM AREA _____ SQ. FT.

SEEPAGE PITS _____ ABSORBENT SIDE-WALL AREA _____ SQ. FT.

SEPTIC TANK CAPACITY 750 GALLONS

FOR GARBAGE GRINDER, INCREASE DISPOSAL AREA 22% & TANK CAPACITY 50%.

OTHER Dry well - dig pit 16 ft. square - set block and top for 12 ft. diam

and fill in rest of pit with gravel. Dry well to be 8 ft. deep below inlet

pipe. Inlet pipe to be 4 ft. below original grade.

Place dry well about 95 ft. from edge of Daisy Road and about 57 ft. to the

right of the fence line as seen when facing from Daisy Road.

PERMIT VOID AFTER THREE YEARS.


PLANS APPROVED BY D. W. Monaghan 06/5/68

FILL SEPTIC TANK AND DISTRIBUTION BOX WITH WATER BEFORE CALLING FOR AN INSPECTION. COVER NO WORK UNTIL INSPECTED AND APPROVED.

NEITHER THE HOWARD COUNTY COMMISSIONERS NOR THE HEALTH DEPARTMENT IS RESPONSIBLE FOR THE SUCCESSFUL OPERATION OF ANY SYSTEM.

NOTIFY THE HEALTH DEPARTMENT 48 HOURS BEFORE EXCAVATIONS ARE TO BE BACK FILLED.

13602

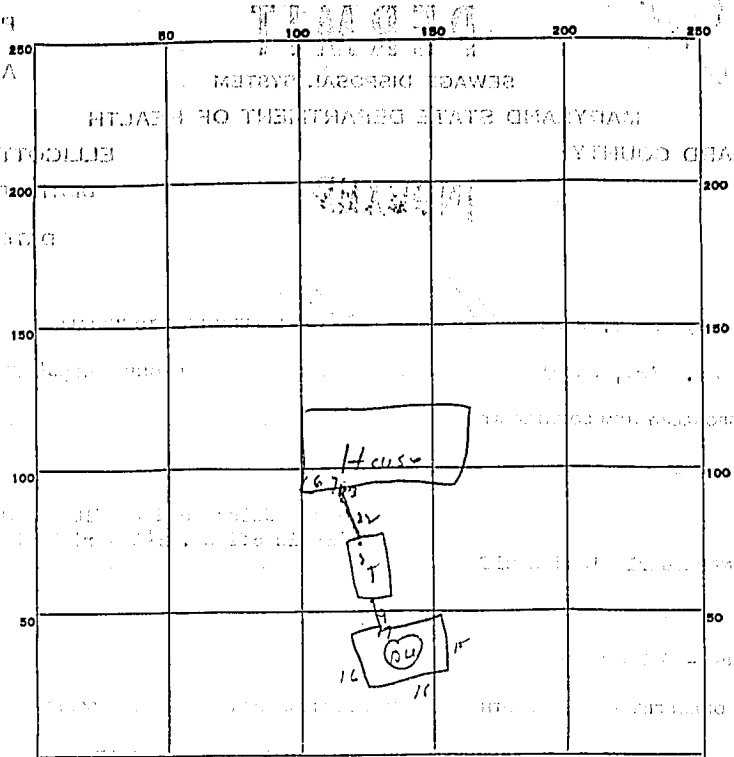

17
16
15
16
64

INDICATE NORTH - NAME ADJOINING ROADWAY AS BASE LINE.
Dairy Road

PERMIT CARD OK

SEPTIC TANK, LEVEL OK CLEANOUTS OK

DISTRIBUTION BOX, LEVEL _____

TILE FIELD, DEPTH _____ FT. TRENCH WIDTH _____ FT.

GRAVEL DEPTH _____ IN. TOTAL LENGTH _____ FT.

NUMBER OF TRENCHES _____ TOTAL BOTTOM AREA _____

SEEPAGE PITS, INSIDE DIAMETER 64 FT. DEPTH BELOW INLET 8 FT.

ABSORBENT AREA 512 SQ. FT.

REMARKS _____

DATE SYSTEM APPROVED 4/5/68 INSPECTOR Don Mangan