

PUB. SEWER STATUS VERIFIED BY \_\_\_\_\_

# 311965

ISSUE DATE: \_\_\_\_\_

APPROVAL DATE: \_\_\_\_\_

# PERMIT INDEXED

P Re-index

A 58088-C

## ON-SITE SEWAGE DISPOSAL SYSTEM HOWARD COUNTY HEALTH DEPARTMENT BUREAU OF ENVIRONMENTAL HEALTH

\_\_\_\_\_ IS PERMITTED TO INSTALL  ALTER

ADDRESS: \_\_\_\_\_ PHONE NUMBER: \_\_\_\_\_

SUBDIVISION: \_\_\_\_\_ LOT NUMBER: \_\_\_\_\_

ADDRESS: 16015 Frederick Road PROPERTY OWNER: Walter Compton

SEPTIC TANK CAPACITY (GALLONS): \_\_\_\_\_

PUMP CHAMBER CAPACITY (GALLONS): \_\_\_\_\_

NUMBER OF BEDROOMS: \_\_\_\_\_

SQUARE FEET PER BEDROOM: \_\_\_\_\_

LINEAR FEET OF TRENCH REQUIRED: \_\_\_\_\_

TRENCHES:	Trench to be _____ feet wide. Inlet _____ feet below original grade. Bottom maximum depth _____ feet below original grade. Effective area begins at _____ feet below original grade. _____ feet of stone below distribution pipe.
LOCATION:	Re-index
PURPOSE:	

PLANS APPROVED: \_\_\_\_\_ DATE: \_\_\_\_\_

- NOTE: PERMIT VOID AFTER 2 YEARS
- NOTE: CONTRACTOR RESPONSIBLE FOR SCHEDULING A PRE-CONSTRUCTION INSPECTION FOR ALL INSTALLATIONS
- NOTE: WATERTIGHT SEPTIC TANKS REQUIRED
- NOTE: ALL PARTS OF SEPTIC SYSTEM SHALL BE 100 FEET FROM ANY WATER WELL
- NOTE: MANHOLE RISERS REQUIRED ON ALL SEPTIC TANKS AND PUMP CHAMBERS

**NEITHER THE HOWARD COUNTY COUNCIL NOR THE HEALTH DEPARTMENT IS  
RESPONSIBLE FOR THE SUCCESSFUL OPERATION OF ANY SYSTEM  
PERMITTEE RESPONSIBLE FOR OBTAINING FINAL APPROVAL ON THIS PERMIT  
CALL 410-313-2640 FOR INSPECTION OF SEPTIC SYSTEM**

A58088-C

# PERMIT

SEWAGE DISPOSAL SYSTEM

MARYLAND STATE DEPARTMENT OF HEALTH

HOWARD COUNTY

## INDEXED

ELLICOTT CITY

DISTRICT 4

DATE 9/19/72

Walter J. Compton IS PERMITTED TO INSTALL ALTER

ADDRESS 16015 Route 144, Lisbon, Md. PHONE 483-4060

A SEWAGE DISPOSAL SYSTEM LOCATED AT \_\_\_\_\_

SUBDIVISION \_\_\_\_\_ ROAD 16015 Frederick Road LOT \_\_\_\_\_

PROPERTY OWNER same as above WALTER JACKSON COMPTON

ADDRESS \_\_\_\_\_

SPECIFICATIONS - 4 bedrooms when renovated

DRAIN FIELD \_\_\_\_\_ DEPTH \_\_\_\_\_ FEET, BOTTOM AREA \_\_\_\_\_ SQ. FT.

SEEPAGE PITS \_\_\_\_\_ ABSORBENT SIDE-WALL AREA \_\_\_\_\_ SQ. FT.

SEPTIC TANK CAPACITY 1,500 GALLONS

FOR GARBAGE GRINDER, INCREASE DISPOSAL AREA 25% & TANK CAPACITY 50%.

OTHER Two Trenches 70 ft. long 10 ft. deep with 5 ft. of gravel below pipe.

Outlet pipe to enter trench 4 ft. below original grade. Call for inspection when

trenches are dug before any gravel is installed. All pipe to be cast iron with

leaded joints within 100 ft. radius of hand dug well. (Locate trenches where percolation sheet shows it.)

NOTE: INSTALL STAND PIPE ON SEPTIC TANK.

ALL PIPE FROM HOUSE TO TANK MUST BE CAST IRON.

PLANS APPROVED BY James T. Wright DATE 9/5/72


FILL SEPTIC TANK AND DISTRIBUTION BOX WITH WATER BEFORE CALLING FOR AN INSPECTION. COVER NO WORK, UNTIL INSPECTED AND APPROVED.

NEITHER THE HOWARD COUNTY COMMISSIONERS NOR THE HEALTH DEPARTMENT IS RESPONSIBLE FOR THE SUCCESSFUL OPERATION OF ANY SYSTEM.

BLOG. PERMIT SIGNED  
AND RETURNED 9/5/72  
Serial # BD 163808  
Storage Building

A 13950

A 5888-C

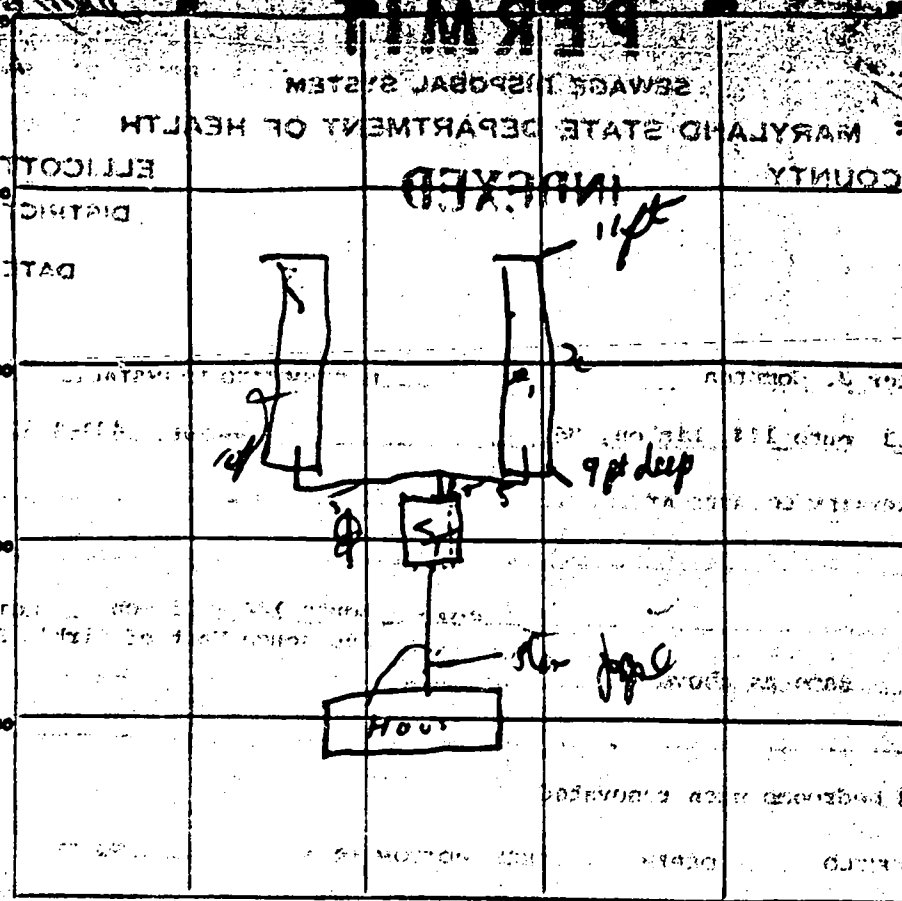

INDICATE NORTH - NAME ADJOINING ROADWAY AS BASE LINE.  
RT 100

PERMIT CARD CK

SEPTIC TANK, LEVEL \_\_\_\_\_ CLEANOUTS OK

DISTRIBUTION BOX, LEVEL \_\_\_\_\_

TILE FIELD, DEPTH \_\_\_\_\_ FT. TRENCH WIDTH \_\_\_\_\_ FT.

GRAVEL DEPTH \_\_\_\_\_ IN. TOTAL LENGTH \_\_\_\_\_ FT.

NUMBER OF TRENCHES \_\_\_\_\_ TOTAL BOTTOM AREA \_\_\_\_\_

SEEPAGE PITS, INSIDE DIAMETER \_\_\_\_\_ FT. DEPTH BELOW INLET \_\_\_\_\_ FT.

ABSORBENT AREA \_\_\_\_\_ SQ. FT.

REMARKS 9/20/72 <sup>1101</sup> - CK to put gravel in Trench #1 see right side of plan. Dury

9/21/72 <sup>470</sup> abt put gravel in second Trench

to call for final insp when job is complete

9/22/72 Trenches + pipe abt completely installed

Recall 9/25/72 1/22 Note put on back card - do not cover

work card

DATE SYSTEM APPROVED 9/25/72 INSPECTOR Dury

# APPLICATION

SEWAGE DISPOSAL TESTING

MARYLAND STATE DEPARTMENT OF HEALTH

HOWARD COUNTY

ELLICOTT CITY

DISTRICT 4

DATE 9/26/68

*Recorded 9/5/69 9:20*

*Septic tank to be <sup>509</sup> 1500*

*follows: ① trench 10 ft long 10 feet deep with 5 feet of gravel. Below pipe. Put set pipe to into trench 4 ft below original grade. All pipe to be cast iron. Depth within 10 ft. radius of hole in day. To ~~locate~~ trench where percolation sheet shows it.*

TO: THE COUNTY HEALTH OFFICER  
ELLICOTT CITY, MARYLAND

I, HEREBY, APPLY FOR THE NECESSARY TESTS IN ORDER TO CONSTRUCT (OR RECONSTRUCT) A SEWAGE DISPOSAL SYSTEM.

PROPERTY OWNER Walter J. Compton

ADDRESS Rt. 144 - Lisbon, Maryland PHONE 489-4060

PROPERTY LOCATION:

SUBDIVISION \_\_\_\_\_ LOT NO. \_\_\_\_\_

ROAD AND DESCRIPTION Rt. 144 - Lisbon - 2nd house above Sirk's Store - same side going West (Sirk's house, then 1 other house)

OCCUPANT \_\_\_\_\_ PHONE \_\_\_\_\_

PERSON TO CONSTRUCT SYSTEM \_\_\_\_\_

ADDRESS \_\_\_\_\_ PHONE Existing house

SIZE OF LOT almost 1 acre TYPE BLDG 3 (Single-family dwlg.)

IF NOT SINGLE RESIDENCE DESCRIBE \_\_\_\_\_

SIGNATURE OF APPLICANT *Walter J. Compton*

APPROVED BY *T. White* FOR *sew tank* DATE 9/5/69

REJECTED BY \_\_\_\_\_ FOR \_\_\_\_\_ DATE \_\_\_\_\_

HOLD PENDING FURTHER TESTS \_\_\_\_\_ DATE \_\_\_\_\_

REASONS FOR REJECTION OR HOLDING \_\_\_\_\_

# THIS IS NOT A PERMIT



**NOTES:**

1. THE PURPOSE OF THIS PLAT IS TO SHOW THE RELATIONSHIP OF THE IMPROVEMENTS SHOWN TO THE LOT (OR PARCEL) BOUNDARIES. THIS PLAT WAS PREPARED WITHOUT THE BENEFIT OF A TITLE REPORT WHICH MAY SHOW ADDITIONAL CONVEYANCES, EASEMENTS, COVENANTS, OR RIGHT-OF-WAY.
2. THIS PLAT IS NOT A BOUNDARY SURVEY AND DOES NOT MEET THE MINIMUM STANDARDS FOR A BOUNDARY SURVEY AS DEFINED BY COMAR REGULATIONS.
3. THIS PLAT IS A 'SPECIAL PURPOSE SURVEY' PER SECTION 10 OF COMAR REGULATIONS.

**ADDITIONAL NOTES:**

- 1) The subject property falls in flood zone "C" as shown on the flood hazard boundary map 240044 0007 B dated 12/04/86.
- 2) This is not a boundary survey or lot stakeout. No title research furnished to or done by this office.
- 3) This plat shows the principal structure and significant structures (close to the apparent property lines) as required by Maryland law. However, additional internal structures may not be shown.
- 4) Fences shown as  $\text{---} \times \text{---} \times \text{---}$  are approximate only. The exact location of fences and boundary lines can be accomplished with a boundary survey.
- 5) Land records reference 479/362

**NOTE:**

DUE TO LACK OF FIELD MONUMENTATION THIS OFFICE RECOMMENDS A BOUNDARY SURVEY.



*Well 25' off house  
ST. : 25' off  
of house*

TAX MAP 7  
PARCEL 232

*N25°20'00"E  
350.00'*

WALTER + WF COMPTON PROPERTY  
TAX MAP 7 PARCEL 192  
479/362

*S25°20'00"W  
350.00'*

TAX MAP 7  
PARCEL 193

*B00144454*

*10/15/03 Site visit  
Proposed new deck ok*



I hereby certify that the improvements shown hereon to the best of my professional knowledge and ability, have been accurately located by a transit, tape or total-station survey.

*Francis B. Collinson*

FRANCIS B. COLLINSON PLS #10104 9/12/03

16015 FREDERICK ROAD 479/362

SPECIAL PURPOSE PLAT  
LOCATION DRAWING TAX MAP 7 PARCEL 192

**WALTER + WF COMPTON PROPERTY**

4TH ELECTION DISTRICT  
HOWARD COUNTY, MARYLAND

SCALE: 1" = 50' SEPT. 2003

PROJECT#6732

CAD FILENAME: LISBON.DWG



A Division of Advanced Surveys, Inc.

5443 Southern Maryland Boulevard  
Lothian, Maryland 20711  
410-741-0850 301-574-0226  
1-800-235-4681