

Recorded  
6/22/72 - 9:30 A.M.

# APPLICATION

A 17128  
P \_\_\_\_\_

SEWAGE DISPOSAL TESTING

MARYLAND STATE DEPARTMENT OF HEALTH

HOWARD COUNTY *Sept 1st - 3 bedrooms - 1200 gal* ELLICOTT CITY

DISTRICT 4

DATE 6/7/72

*Dry well - 100 sq ft absorbent sidewall and  
per bedroom to begin below the front  
3 1/2 ft of non-porous soil. Maximum depth permitted  
for dry well is 10 ft. Inside dry well 110 ft from  
front property line and 2 ft from sept. tank.*

TO: THE COUNTY HEALTH OFFICER  
ELLICOTT CITY, MARYLAND

I, HEREBY, APPLY FOR THE NECESSARY TESTS IN ORDER TO CONSTRUCT (OR RECONSTRUCT) A SEWAGE DISPOSAL SYSTEM.

PROPERTY OWNER Clarence E. & Joan P. Bassler

ADDRESS Route 2, Daisy Road, Woodbine, Md. 21797 PHONE 489-4461

PROPERTY LOCATION:

SUBDIVISION Daisy Meadows LOT NO. Parcel 9 *Parcel 10*

ROAD AND DESCRIPTION Daisy Road - Use Bassler's driveway beside red barn  
that sits on road.

OCCUPANT \_\_\_\_\_ PHONE \_\_\_\_\_

PERSON TO CONSTRUCT SYSTEM \_\_\_\_\_

ADDRESS \_\_\_\_\_ PHONE \_\_\_\_\_

SIZE OF LOT ~~5,296.4 acres~~ 5,296.4 acres TYPE BLDG. 3 or 4 bedrooms  
NUMBER OF BEDROOMS

IF NOT SINGLE RESIDENCE DESCRIBE \_\_\_\_\_

SIGNATURE OF APPLICANT /s/ Joan P. Bassler

APPROVED BY Robert V. Tame FOR Dry Well DATE 8/3/72  
(KIND OF SYSTEM)


REJECTED BY \_\_\_\_\_ FOR \_\_\_\_\_ DATE \_\_\_\_\_  
(KIND OF SYSTEM)

HOLD PENDING FURTHER TESTS \_\_\_\_\_ DATE \_\_\_\_\_

REASONS FOR REJECTION OR HOLDING \_\_\_\_\_

# THIS IS NOT A PERMIT

SOIL

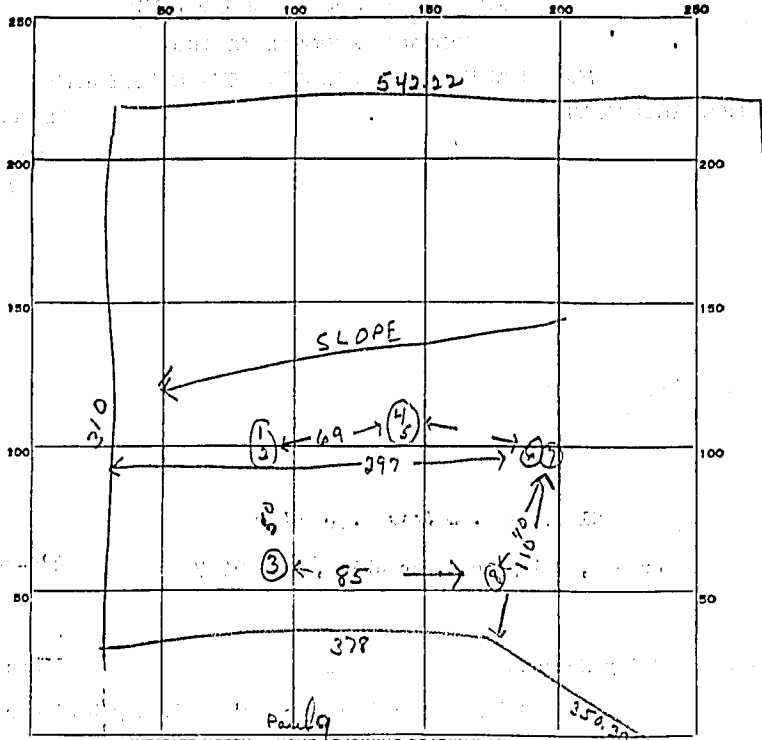

INDICATE NORTH. - NAME ADJOINING ROADWAY AS BASE LINE.

DAISY Rd.

DATE	TEST NO.	DEPTH	PRE-WET		TEST - 1" DROP		TIME
			START	STOP	START	STOP	
7/27/72	1	9 1/2 ft.	11 24	11 26	11 26	11 28	2 min
	2	4 ft.	11 25	11 27	11 27	11 29	2 min
	3	8 1/2 ft.	11 51	11 54	11 54	12 01	7 min
	4	12 ft.	11 51	11 53	11 53	11 55	2 min
	5	3 1/2 ft.	12 02	12 05	12 05	12 10	5 min
	6	4 ft.	12 02	12 05	12 05	12 10	5 min
	7	11 ft.	12 02	12 05	12 05	12 10	5 min
	8	7 ft.	12 02	12 05	12 05	12 10	5 min

obj. used for report  
 (Dry - 10 min)

SOIL AUGER FINDING Hot shale rock in various spots.

TESTED BY R. Torr

REMARKS \_\_\_\_\_