

6/15/99  
2:00 C.O.  
11/16/99  
3:00 WPI  
1/18/00 1:00

# PERMIT

## SEWAGE DISPOSAL SYSTEM

### DEPARTMENT OF HEALTH AND MENTAL HYGIENE

P 572741

A 58533-C

DISTRICT \_\_\_\_\_

DATE 9-30-99

DATE SYSTEM APPROVED 1/18/00

INSPECTOR SRK

HOWARD COUNTY HEALTH DEPARTMENT  
BUREAU OF ENVIRONMENTAL HEALTH  
~~XXXXXXX~~ 410-313-2640

#325571  
**INDEXED**

HATF162D

MB Buckskin Lake Overlook LLC IS PERMITTED TO INSTALL  ALTER \_\_\_\_\_

ADDRESS 1686 East Gude Drive, Rockville, Maryland 20850 PHONE 301-854-1525

SUBDIVISION Buckskin Lake Overlook LOT 6 ROAD 13036 Folly Quarter Road

PROPERTY OWNER Mitchell & Best Homebuilders

ADDRESS \_\_\_\_\_

**TOP SEAMED TANK REQUIRED**  
SEPTIC TANK CAPACITY 1500 GALLONS

NUMBER OF BEDROOMS 5

180 SQUARE FEET PER BEDROOM

LINEAR FEET OF TRENCH REQUIRED 300

**PUMPED SEPTIC SYSTEM REQUIRED**

- INSTALL: - 1-1500 GALLON TOP SEAMED PUMP CHAMBER
- NOTES: - Septic pump detail to be provided by installer prior to issuance of septic permit.
- Pump performance test is necessary prior to Health Department approval of pump septic system.

TRENCHES - Trench to be 3 feet wide. Inlet 2.5 feet below original grade. Bottom maximum depth 4.5 feet below original grade. Effective area begins at 2.5 feet below original grade. 2 feet of stone below distribution pipe.

LOCATION - Beginning from the intersection of the 199.62' and 182.58' lot lines, begin trenches 70 feet up the 182.58' lot line and 10 feet off this same lot line. Run trenches on contour initially toward the left (320.86') lot line, then in both directions.

NOTES - No trench to exceed 100 feet in length. Provide 6" - 8" diameter cleanout and cap to grade or above on septic tank. OK 4/15/99 DS

PLANS APPROVED BY Amy McMillen DATE 04-09-1999

COVER NO WORK UNTIL INSPECTED AND APPROVED

NEITHER THE HOWARD COUNTY COUNCIL NOR THE HEALTH DEPARTMENT IS RESPONSIBLE FOR THE SUCCESSFUL OPERATION OF ANY SYSTEM

NOTE: CLEANOUT REQUIRED EVERY 70 FEET OF SEWER LINE AND/OR AT 90° SWEEPS IN LINES FROM HOUSE TO DRAIN FIELDS, 90° ELBOWS NOT ACCEPTABLE.

NOTE: ALL PARTS OF SEPTIC SYSTEMS (I.E. TANK, DISTRIBUTION BOX TRENCHES) TO BE 100 FEET FROM WELL (UNLESS OTHERWISE SPECIFICALLY AUTHORIZED)

NOTE: IF DEEP TRENCH(ES) ARE USED CALL FOR INSPECTION BEFORE AND AFTER PLACING GRAVEL IN TRENCH(ES)

300116941  
4/9/99

NOTE: NO DRY WELL SHALL EXCEED 15 FOOT IN DIAMETER NO ABSORPTION TRENCH TO EXCEED 100 FEET IN LENGTH

NOTE: ALL PIPE FROM HOUSE TO SEPTIC TANK MUST BE CAST IRON OR SCHEDULE 35/40 PVC OR ABS

PERMIT VOID AFTER TWO YEARS

**BUILDING PERMIT SIGNED AND RETURNED**


6/10/04 800145550-DEER

NOTE: INSTALL STAND PIPE ON SEPTIC TANK AND DRY WELL STAND PIPES MUST BE 6 INCHES IN DIAMETER CAST IRON, CONCRETE OR TERRA COTTA OR PVA OR ABS ACCEPTED. IF TOP OF SEPTIC TANK IS DEEPER THAN 3 FEET, MANHOLE TO GRADE REQUIRED.

NOTE: DISTRIBUTION BOXES MUST HAVE BAFFLES

**\*INSTALLER IS RESPONSIBLE FOR OBTAINING FINAL APPROVAL ON THIS PERMIT**

**\*CALL 461-9933 FOR INSPECTION OF SEPTIC SYSTEM.**

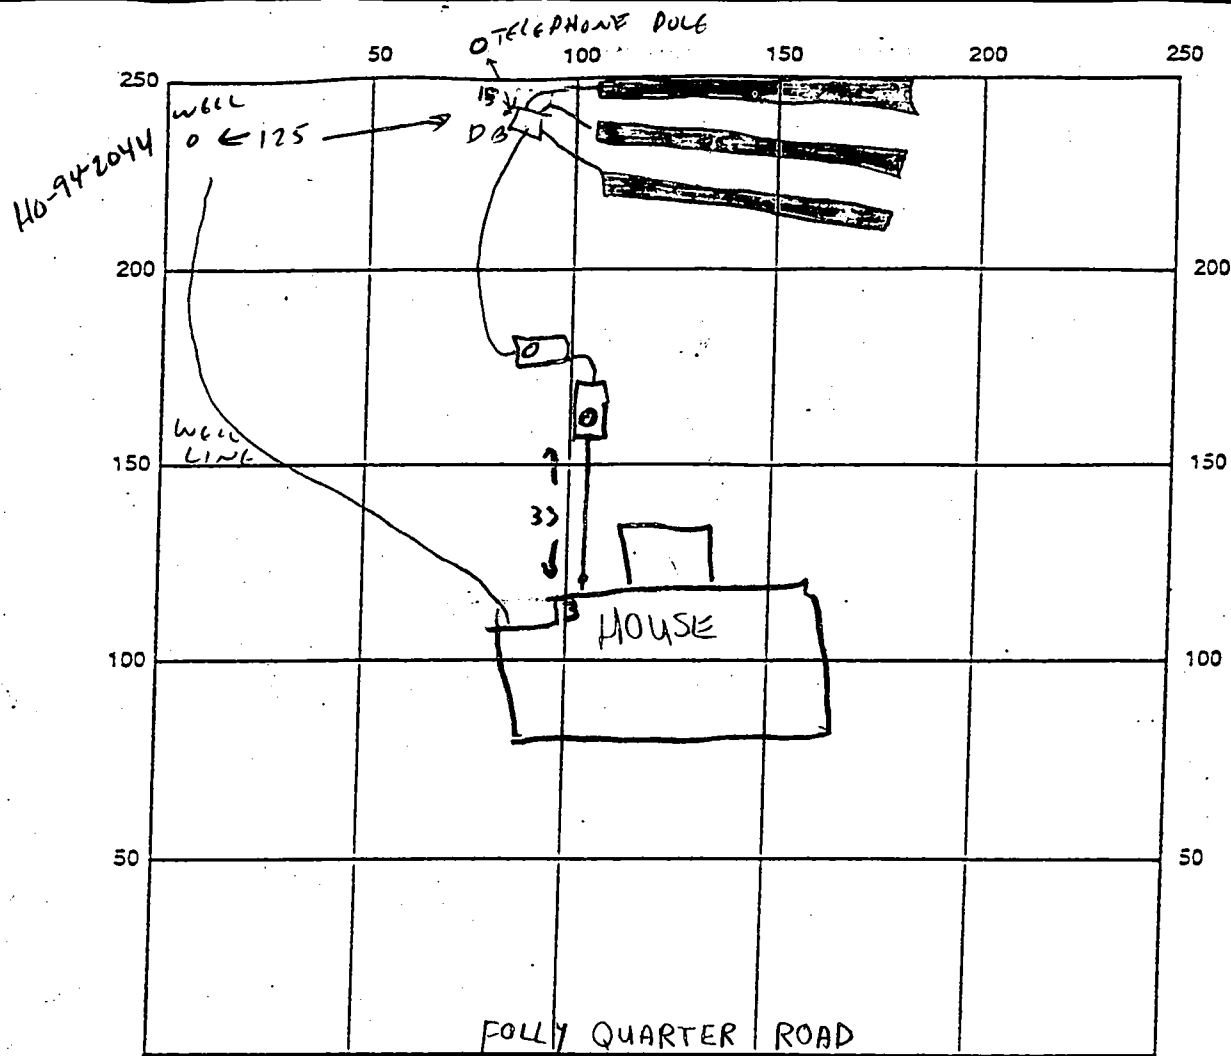

INDICATE NORTH - NAME ADJOINING ROADWAY AS BASE LINE

SEPTIC TANK LEVEL 1500 ✓ comp. 1500 PUMP PIT COMPARTMENT CLEANOUTS IN LINE (a) HOUSE, MANHOLE ON TANK & PUMP PIT.

DISTRIBUTION BOX LEVEL ✓

DRAIN FIELD/TITLE DEPTH 3.5 FT. TRENCH WIDTH 3' FT. INLET DEPTH 3 FT.

EFFECTIVE GRAVEL DEPTH 2 FT. TOTAL LENGTH 300 FT.

NUMBER OF TRENCHES 3 (5) 100' ONE SIDEWALL/BOTTOM AREA 900 SQ. FT.

DRYWALL INSIDE DIAMETER N/A FT. EFFECTIVE DEPTH BELOW INLET N/A FT.

ABSORBENT AREA N/A SQ. FT.

REMARKS: TRENCHES SLIGHTLY DEEPER THAN SPECIFIED - ACCEPTABLE, TANK - PUMP PIT -

DIST. BOX AND LINES COMPLETE. OK TO COVER ALL.

PUMP PIT PERFORMANCE STILL NEEDED. 11/15/99 CW

1/18/00 PUMP PIT HIGH WATER ALARM OK (SRK)

DATE SYSTEM APPROVED 1/18/00 INSPECTOR Steven R. Krieg

# APPLICATION

PERCOLATION TESTING

A 58533

P \_\_\_\_\_

HOWARD COUNTY HEALTH DEPARTMENT  
BUREAU OF ENVIRONMENTAL HEALTH  
3525-H ELLICOTT MILLS DRIVE/ELLICOTT CITY, MARYLAND 21043  
TELEPHONE: 313-2840

DISTRICT: \_\_\_\_\_

DATE \_\_\_\_\_

TO: THE COUNTY HEALTH OFFICER  
ELLICOTT CITY, MARYLAND

I HEREBY APPLY FOR THE NECESSARY TEST PRIOR TO APPLICATION FOR PERMIT TO CONSTRUCT (OR RECONSTRUCT) A SEWAGE DISPOSAL SYSTEM.

PROPERTY OWNER John Mullinix

ADDRESS P.O. Box 490 MINERAL BLUFF GA PHONE \_\_\_\_\_

AGENT OR PROSPECTIVE BUYER Land Source Development Corporation % creston catholic

ADDRESS 10480 LITTLE PATUXENT PARKWAY PHONE \_\_\_\_\_  
SUITE 500 COLUMBIA MARYLAND 21044

PROPERTY LOCATION:

SUBDIVISION Buckskin Lake Overlook LOTS 5-7 LOT NO. (6)

ROAD AND DESCRIPTION FOLLY QUARTER ROAD

TAX MAP 22 PARCEL # 73

SIZE OF LOT 1 AC. TYPE BLDG. S.F.D  
(SINGLE FAMILY DWELLING OR COMMERCIAL)

THE SYSTEM INSTALLED UNDER THIS APPLICATION IS ACCEPTABLE ONLY UNTIL PUBLIC FACILITIES BECOME AVAILABLE. I FULLY UNDERSTAND THE

FEE CONNECTED WITH THE FILING OF THIS PERC TEST APPLICATION IS NON-REFUNDABLE UNDER ANY CIRCUMSTANCES. I ALSO AGREE TO

COMPLY WITH ALL M.O.S.H.A. REQUIREMENTS IN TESTING THIS LOT. Eichmaria Y. Fisch (agent)  
(SIGNATURE OF APPLICANT)

APPROVED BY \_\_\_\_\_ FOR \_\_\_\_\_ DATE \_\_\_\_\_

DISAPPROVED BY \_\_\_\_\_ FOR \_\_\_\_\_ DATE \_\_\_\_\_

HOLD PENDING FURTHER TESTS \_\_\_\_\_

REASONS FOR REJECTION OR HOLDING \_\_\_\_\_

PERCOLATION TEST PLAT/PRELIMINARY PLAT - TITLE OR I.D. # \_\_\_\_\_ DATE \_\_\_\_\_

SITE DEVELOPMENT PLAN/FINAL PLAT - TITLE OR I.D. # \_\_\_\_\_ DATE \_\_\_\_\_

# THIS IS NOT A PERMIT


58533

COUNTY #

SOIL PROFILE

504/505

0' topsoil  
 1' org brn cl 1m  
 3' pale org brn sd 1m w/mica flecs  
 15% Rx  
 12'

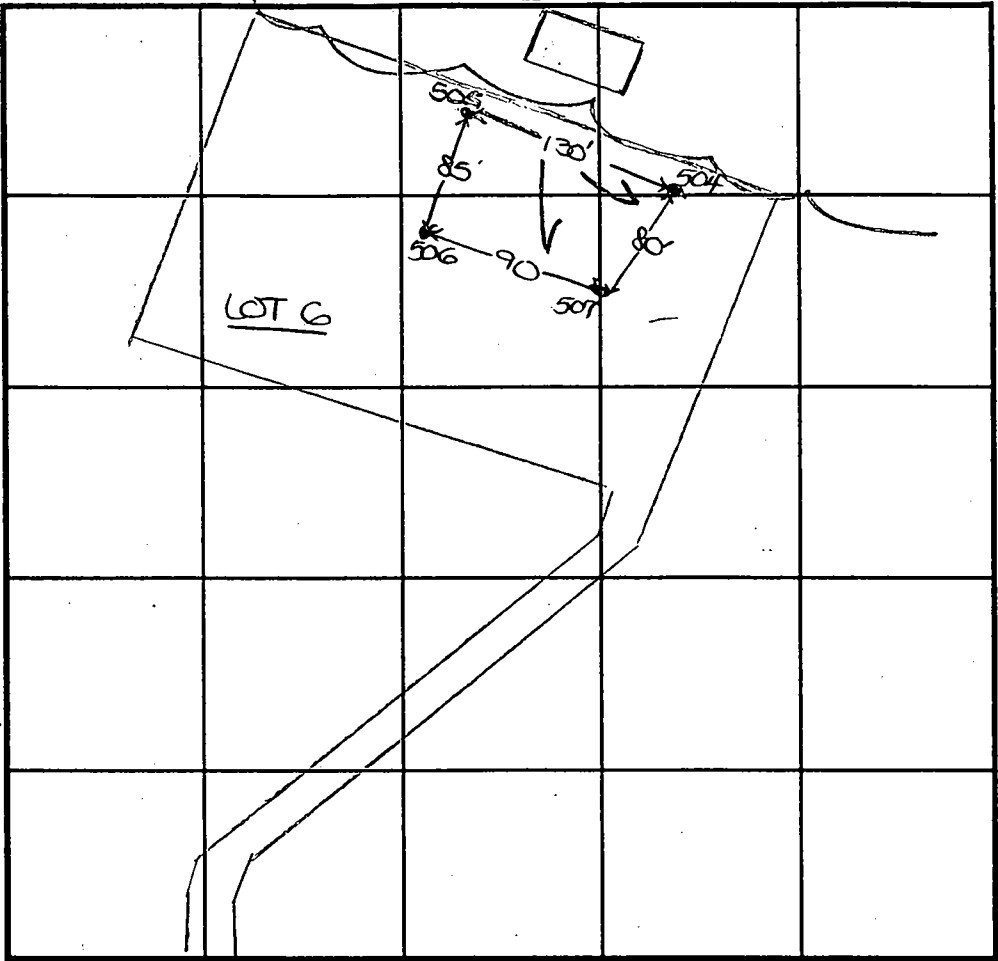

SOIL PROFILE

0'

506/507

0' topsoil  
 1' org red brn cl 1m  
 3' med to pale org brn sd 1m w/mica flecs  
 15% Rx

INDICATE NORTH - NAME ADJOINING ROADWAY AS BASE LINE.

Folly Quarter Road

DATE	TEST NO.	DEPTH	PRE-WET		TEST - 1" DROP		TIME
			START	STOP	START	STOP	
6-27-97	504	12.0'D	Visual	—	—	—	OK
	507	4.0'S	12:32	12:33	12:33	12:34	2
		12.0'D	Visual	OK			
	506	4.0'S	12:37	12:42	12:42	12:49	7
		11.0'D	Visual	OK			
	505	4.0'S	12:55	12:56	12:56	12:57	2
		7.5'M	12:53	12:54	12:54	12:57	3
		11'8" D	Visual	OK			

REMARKS holes tested as staked


TYPE OF SOIL

TESTED BY D. Soe ALSO PRESENT

TRENCH DESIGN DATA: AVERAGE PERCOLATION TIME 5 TRENCH WIDTH 3

INLET DEPTH 2.5 MAXIMUM BOTTOM DEPTH 4.5 SQ. FT./BEDROOM 180

Approved Septic System Plan  
Howard County Health Department

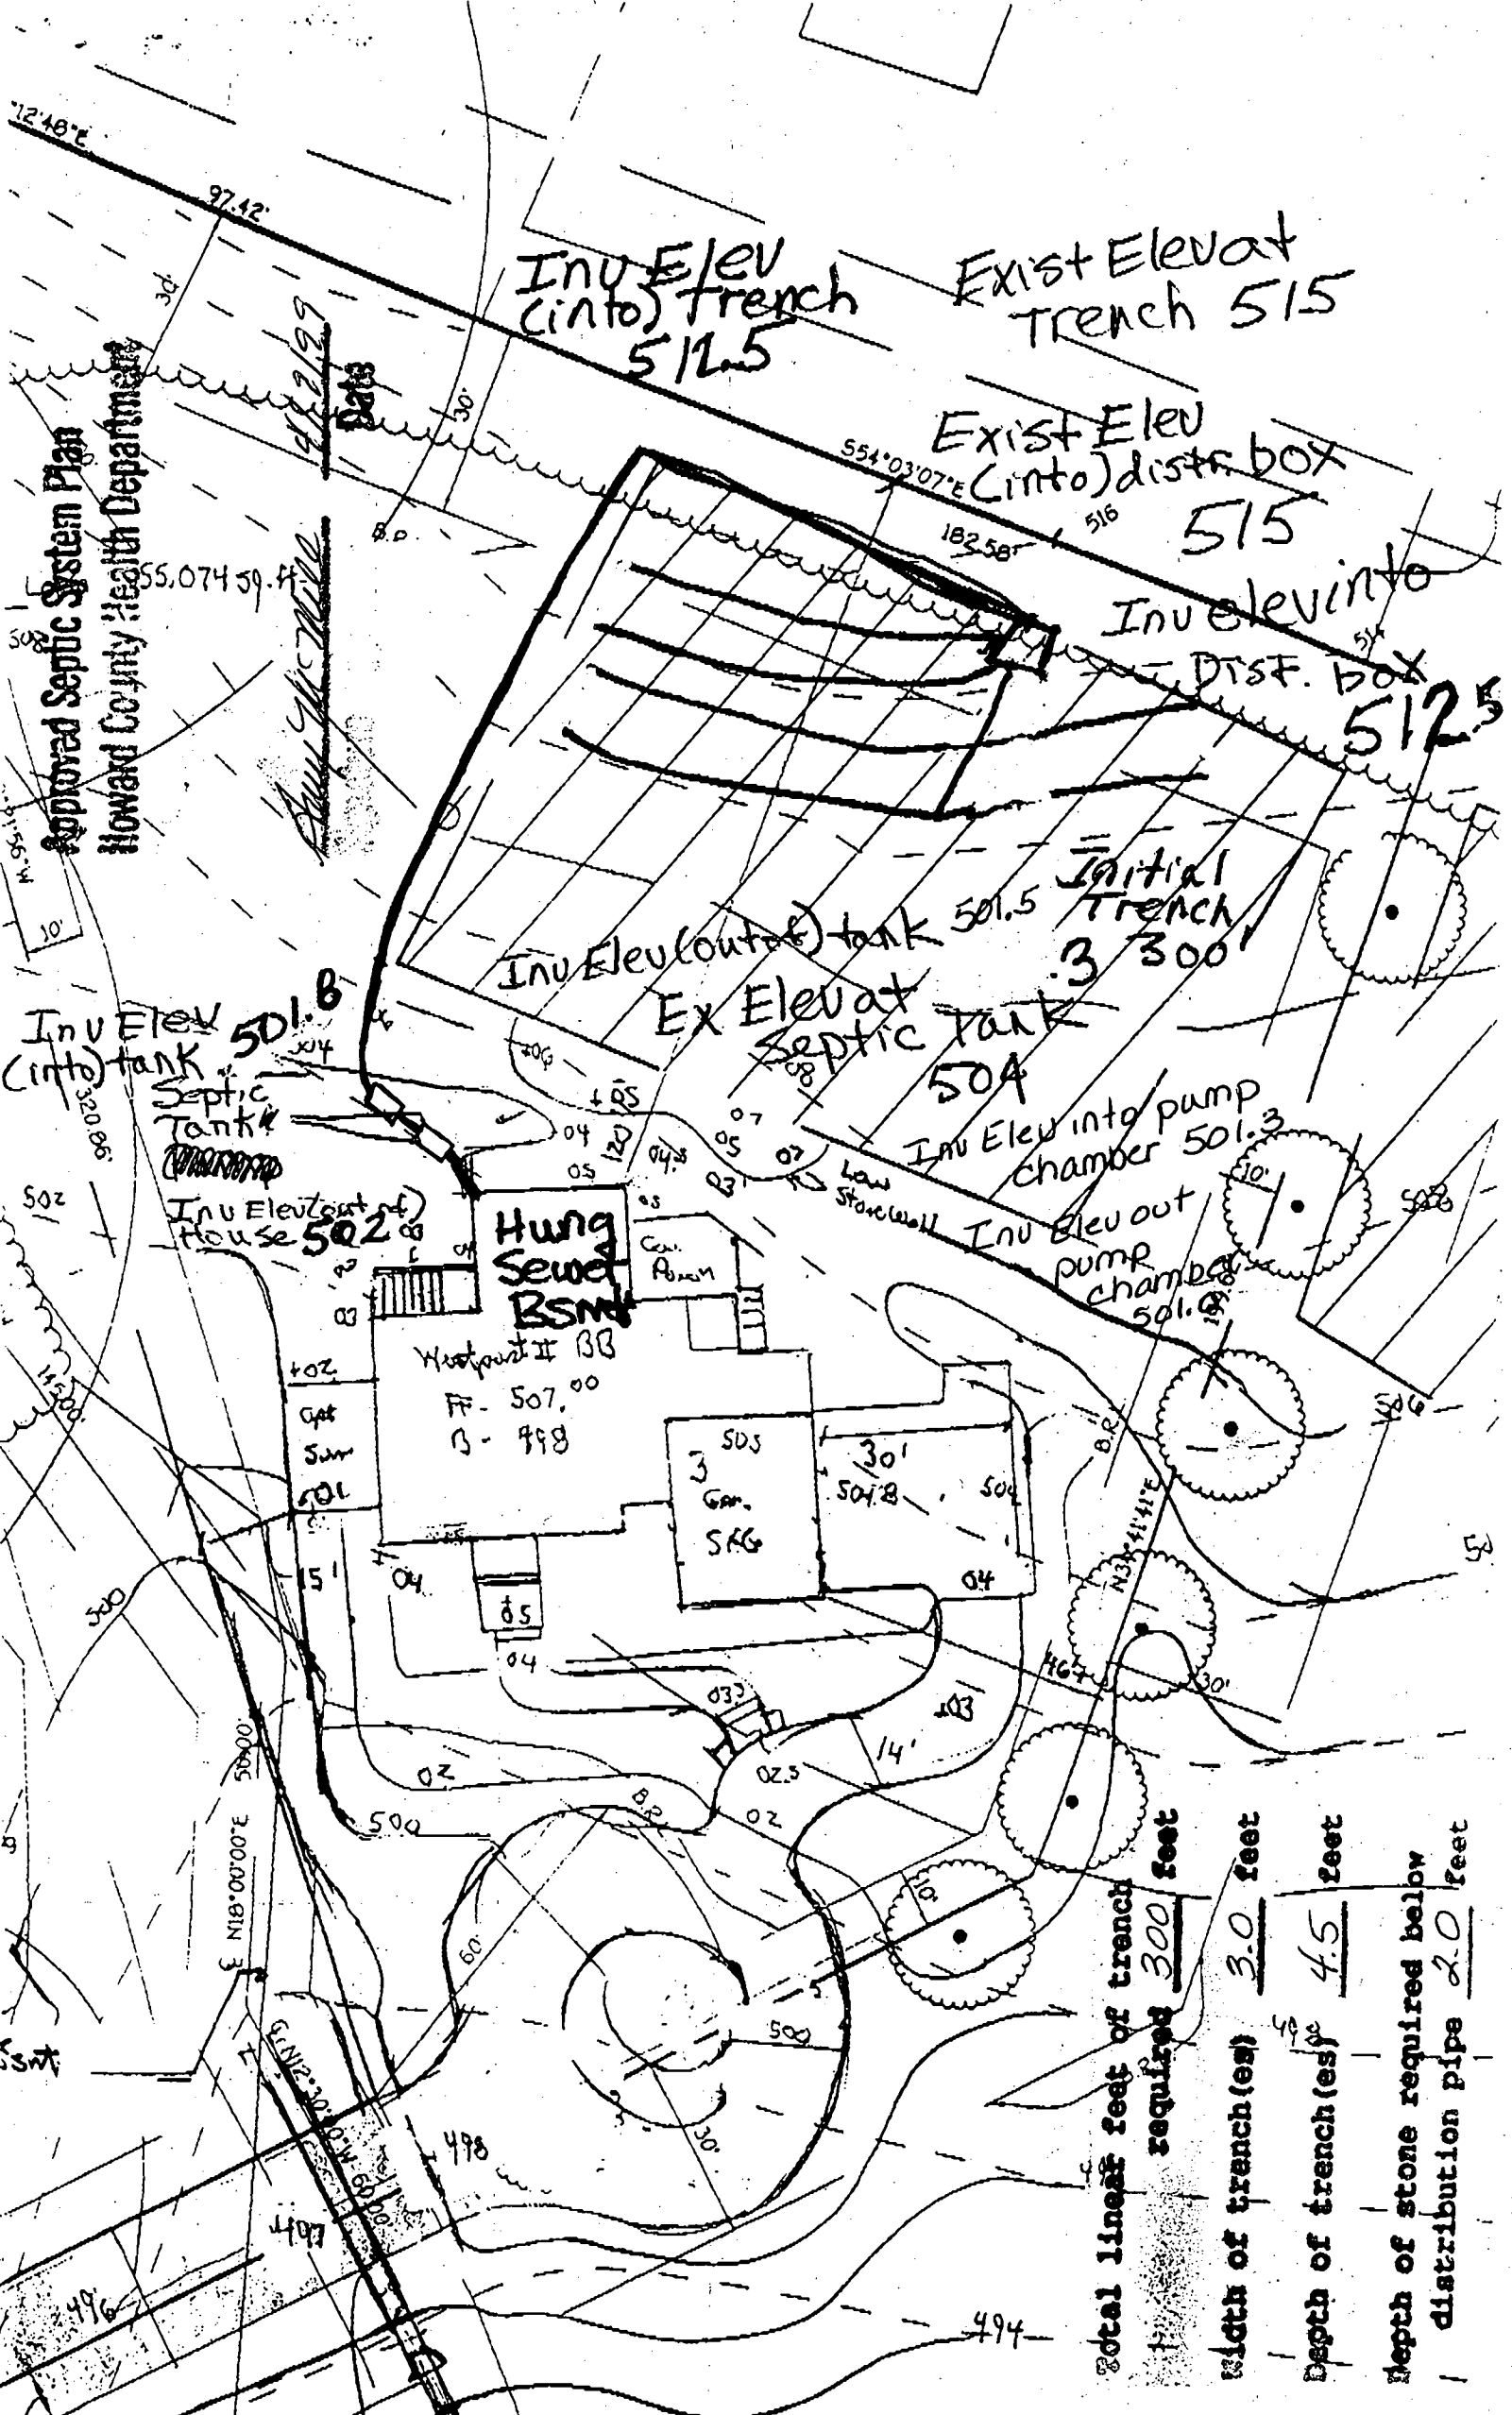

Total linear feet of trench required	300 feet
Width of trench(es)	3.0 feet
Depth of trench(es)	4.5 feet
Depth of stone required below distribution pipe	2.0 feet

MARYLAND DEPARTMENT OF THE ENVIRONMENT, WATER MANAGEMENT ADMINISTRATION  
2500 BROENING HIGHWAY, BALTIMORE, MARYLAND 21224, (410) 631-3784

WATER WELL ABANDONMENT-SEALING REPORT FORM

SUBMIT COPIES OF COMPLETED FORM TO:

- \* COUNTY ENVIRONMENT AGENCY (contact MDE, WMA if address needed)
- \* WELL OWNER
- \* MDE, WATER MANAGEMENT ADMINISTRATION, WELL PROGRAM

DATE WELL ABANDONED: 7/5/00 (month/day/year)

\* PERMIT NUMBER OF ABANDONED WELL (if any)

HO - 94 - 2044

\* PERMIT NUMBER OF REPLACEMENT WELL

HO - 94 - 2680

\* PERSON ABANDONING WELL: Matthew Best WELL DRILLERS LICENSE NUMBER: AWD611

CIRCLE: MWD/MSD/MGD

\* OWNER'S NAME: Mitchell Best

\* WELL LOCATION: 13036 Folly Quarter Road

COUNTY: Howard

NEAREST TOWN: Glenn


TAX MAP \_\_\_\_\_ BLOCK \_\_\_\_\_ PARCEL \_\_\_\_\_

SUBDIVISION: \_\_\_\_\_

SECTION: \_\_\_\_\_ LOT: \_\_\_\_\_

NEAREST ROAD: Folly Quarter Rd

SITE LOCATION MAP

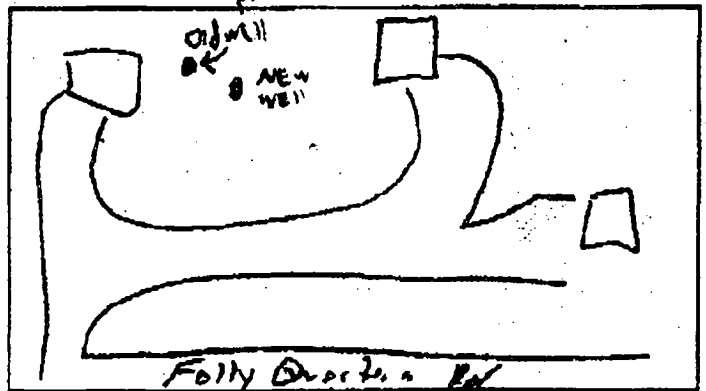

TYPE OF WELL BEING ABANDONED:

- DRILLED  JETTED
- BORED/AUGERED  HAND DUG
- OTHER (specify) \_\_\_\_\_

USE CODE:

- DOMESTIC  MUNICIPAL/PUBLIC
- IRRIGATION  INDUSTRIAL
- TEST/OBSERVATION  GEOTHERMAL

TYPE OF CASING:

- STEEL  PLASTIC
- CONCRETE  OTHER (specify) \_\_\_\_\_

\* SIZE OF CASING: 6 INCHES IN DIAMETER

\* DEPTH OF WELL: 800 FEET DEEP

WAS ANY CASING REMOVED?  YES  NO  
if yes, length removed, in feet: 3

WAS CASING RIPPED OR PERFORATED?  YES  NO

LOG OF SEALING MATERIAL

MATERIAL	FEET	
	FROM	TO
Gravel	800	82
Cement/Bent	82	3
Fill	3	0
VOLUME OF MATERIAL USED		

SIGNATURE-MASTER WELL DRILLER OR SUPERVISING SANITARIAN: Matthew Best

LICENSE # 269 MWD/MSD/MGD CIRCLE ONE

DATE 7-5-00

9838

SEQUENCE NO. (MDE USE ONLY)

STATE OF MARYLAND WELL COMPLETION REPORT

THIS REPORT MUST BE SUBMITTED AFTER WELL IS COMPLETED.

COUNTY NUMBER A58533

DATE RECEIVED MM 02 DD 04 YY 99

DATE WELL COMPLETED MM 02 DD 04 YY 99

DEPTH OF WELL 22 200 26 (TO NEAREST FOOT)

PERMIT NO. FROM "PERMIT TO DRILL WELL" HO 04-2044

OWNER Mitchell & Best STREET OR RFD Folly Quarter Rd TOWN ELICOTT CITY SUBDIVISION Buckraun Lake Overlook SECTION LOT 6

WELL LOG table with columns: DESCRIPTION, FEET (FROM, TO), check if water bearing. Includes entries for Top soil, red clay, Sand silt clay, Mica, Sandstone, Mica, Sandstone, Mica, Soft sand stone, Mica.

GROUTING RECORD form with fields for WELL HAS BEEN GROUTED, TYPE OF GROUTING MATERIAL (CEMENT, BENTONITE CLAY), NO. OF BAGS, NO. OF POUNDS, GALLONS OF WATER, DEPTH OF GROUT SEAL.

CASING RECORD form with fields for casing types (STEEL, CONCRETE, PLASTIC, OTHER), MAIN CASING TYPE, Nominal diameter, Total depth.

OTHER CASING (if used) form with fields for diameter, depth.

SCREEN RECORD form with fields for screen type or open hole, insert appropriate code below.

DEPTH (nearest ft.) table with columns for casing height and depth, including handwritten values like 140, 78, 200.

PUMPING TEST form with fields for HOURS PUMPED, PUMPING RATE, METHOD USED TO MEASURE PUMPING RATE, WATER LEVEL, TYPE OF PUMP USED.


PUMP INSTALLED form with fields for DRILLER INSTALLED PUMP, TYPE OF PUMP INSTALLED, PLACE, CAPACITY, PUMP HORSE POWER, PUMP COLUMN LENGTH, CASING HEIGHT.

WELL HYDROFRACTURED form with fields for NUMBER OF UNSUCCESSFUL WELLS, WELL HYDROFRACTURED status, and instructions for circle appropriate letter.

I HEREBY CERTIFY THAT THIS WELL HAS BEEN CONSTRUCTED IN ACCORDANCE WITH COMAR 26.04.04 "WELL CONSTRUCTION" AND IN CONFORMANCE WITH ALL CONDITIONS STATED IN THE ABOVE CAPTIONED PERMIT...

DRILLERS LIC. NO. MWD 040, DRILLERS SIGNATURE, LIC. NO. MWD 501, SITE SUPERVISOR.

GRAVEL PACK IF WELL DRILLED WAS FLOWING WELL, MDE USE ONLY (NOT TO BE FILLED IN BY DRILLER), TELESCOPE CASING, LOG INDICATOR.

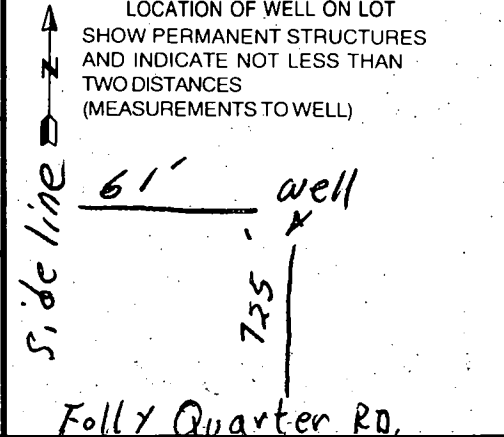

3641

SEQUENCE NO. (MDE USE ONLY)

STATE OF MARYLAND PERMIT TO DRILL WELL please print or type

STATE PERMIT NUMBER

HO-04-2044 fill in this form completely

Date Received (APA) 12/24/98

OWNER INFORMATION RN 7704

Howard

LOCATION OF WELL CCA

Mitchell & Best 1686 E. Gude Dr., Rockville, Md 20850


Buckskin Lake Overlook 23 SUBDIVISION SECTION 44 46 LOT 48 50 NEAREST TOWN ELICOTT CITY

DRILLER INFORMATION

George F. Easterday L. Franklin Easterday, Inc. 9265 Brown Church Rd., MT. Airy, Md. 21771

B 4

DIRECTION OF WELL FROM TOWN (CIRCLE BOX)

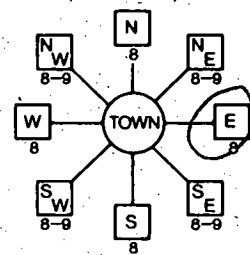

Folly Quarter Rd NEAR WHAT ROAD

ON WHICH SIDE OF ROAD (CIRCLE APPROPRIATE BOX)

725 DISTANCE FROM ROAD ENTER FT OR MI

TAX MAP: BLK: PARCEL

WELL INFORMATION

APPROX. PUMPING RATE (GAL. PER MIN.) 500 AVERAGE DAILY QUANTITY NEEDED (GAL. PER DAY) 500

USE FOR WATER (CIRCLE APPROPRIATE BOX)

- DOMESTIC POTABLE SUPPLY & RESIDENTIAL IRRIGATION (circled) FARMING (LIVESTOCK WATERING & AGRICULTURAL IRRIGATION) INDUSTRIAL, COMMERCIAL, DEWATERING PUBLIC WATER SUPPLY WELL TEST, OBSERVATION, MONITORING GEO-THERMAL

NOT TO BE FILLED IN BY DRILLER HEALTH DEPARTMENT APPROVAL

Howard A 58533 COUNTY NAME COUNTY NO

STATE SIGNATURE INSERT S.

DATE ISSUED 12/24/98 CO SIGNATURE EXP. DATE

NORTH GRID 518 000 EAST GRID 0810 000

APPROXIMATE DEPTH OF WELL 300 FEET

APPROXIMATE DIAMETER OF WELL 6 INCH NEAREST TOWN

METHOD OF DRILLING (circle one)

- BORED (or Augered) AIR-ROTary (circled) JETTED AIR-PERcussion ROTARY (Hydraulic Rotary) Jetted & DRIVEN Drive-POINT

REPLACEMENT OR DEEPEMED WELLS (CIRCLE APPROPRIATE BOX)

- THIS WELL WILL NOT REPLACE AN EXISTING WELL THIS WELL WILL REPLACE A WELL THAT WILL BE ABANDONED AND SEALED THIS WELL WILL REPLACE A WELL THAT WILL BE USED AS A STANDBY-CONTACT LOCAL APPROVING AUTHORITY FOR POLICY ON STANDBY WELLS THIS WELL WILL DEEPEM AN EXISTING WELL

PERMIT NUMBER OF WELL TO BE REPLACED OR DEEPEMED (IF AVAILABLE)

Not to be filled in by driller (MDE OR COUNTY USE ONLY)

APPROX. PERMIT NUMBER G A P 54 63

PERMIT No. HO-04-2044

SPECIAL CONDITIONS

NOTE: APPROVING AUTHORITIES SHOULD USE SEPARATE SHEET IF NEEDED

SHOW MAJOR FEATURES OF BOX & LOCATE WELL WITH AN X

- SOURCES OF DRILLING WATER 1. wells 2. 3.

WRITE THE BOX NUMBER FROM THE MAP HERE


106 800 E 510-8 N

2/1/99 1:00 Groot X

Handwritten signature

DRAW A SKETCH BELOW SHOWING LOCATION OF WELL IN RELATION TO NEARBY TOWNS AND ROADS AND GIVE DISTANCE FROM WELL TO NEAREST ROAD JUNCTION

MAP 10. A11

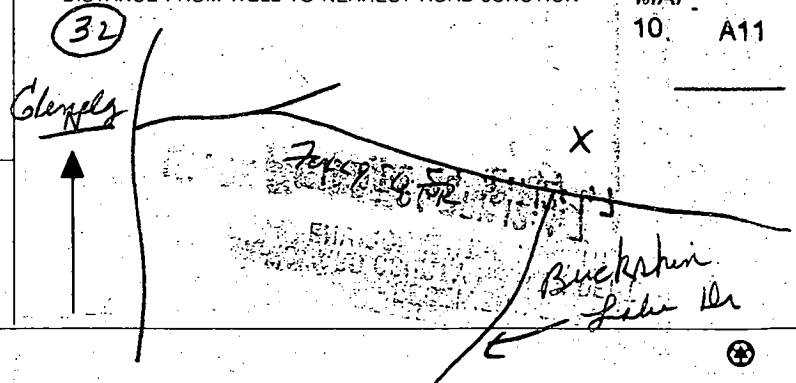

P.01

Ted,  
 Did the surveyor  
 put in both corner  
 stakes, and was he  
 lining up with the one  
 closest to the front to  
 determine the well location?  
 Mike


RE-DRILL well HERE  
 5/9/00  
 Well site O.K.  
 as marked.  
 (BB)


PLAT IS NOT INTENDED FOR USE  
 IN THE ESTABLISHMENT OF LOCUS  
 AS A RESULT, THIS PLAT DOES  
 NOT IDENTIFY ANY PROPERTY  
 SUBJECT PROPERTY IS SHOWN IN  
 DATE MAP OF HOWARD  
 DATE 10-1-1988  
 THE OFFSETS FROM BUILDING LN  
 PLUS OR MINUS 01

ABOUT 8' FT  
 OFF PROPERTY LINE

LOT 3  
 PUBLIC BUILDING PROPERTY  
 1000 S. 1000 S. 1000 S.  
 1000 S. 1000 S. 1000 S.  
 Private 24' Use-to-Common Access  
 Easement For The Use And Benefit  
 Of Lots 3, 5 And Preservation  
 Parcel 'A'.  
 Maintenance Agreement Recorded  
 Among The Land Records Of  
 Howard County, Maryland.  
 MAY-1-83-00 02:22P


Don't know  
 casing 2.5  
 open ends  
 (circled)  
 (circled)

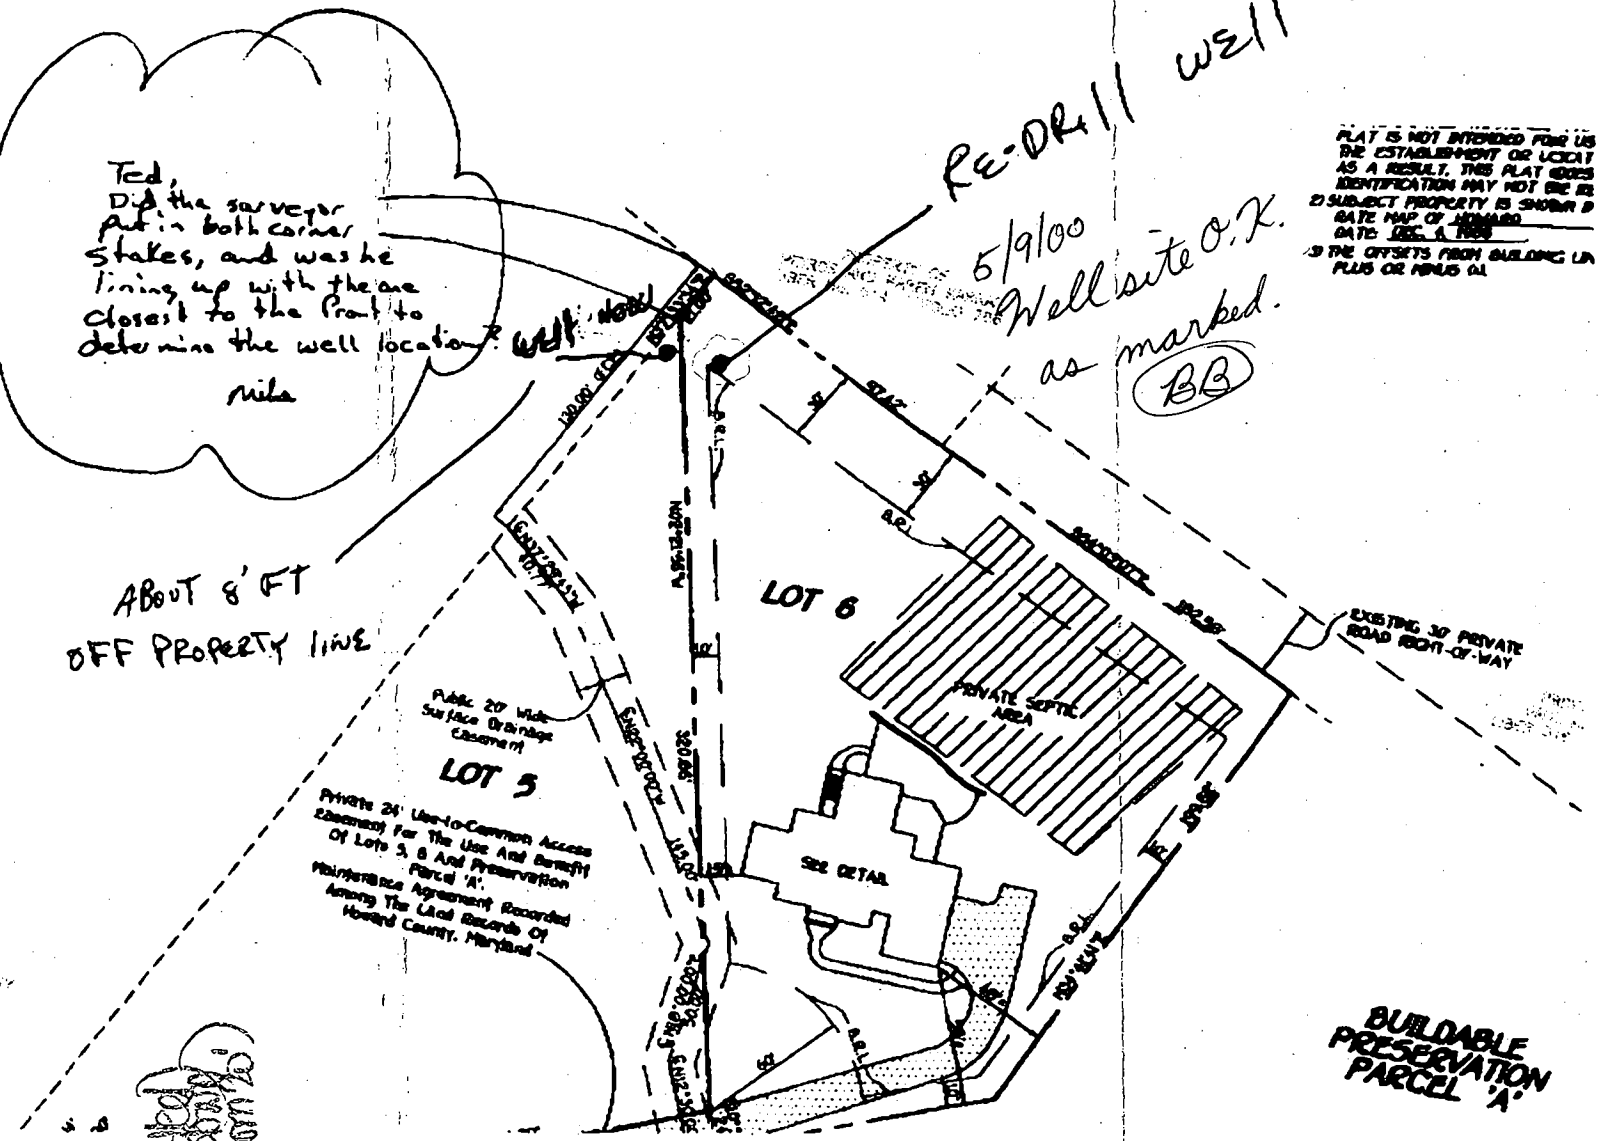

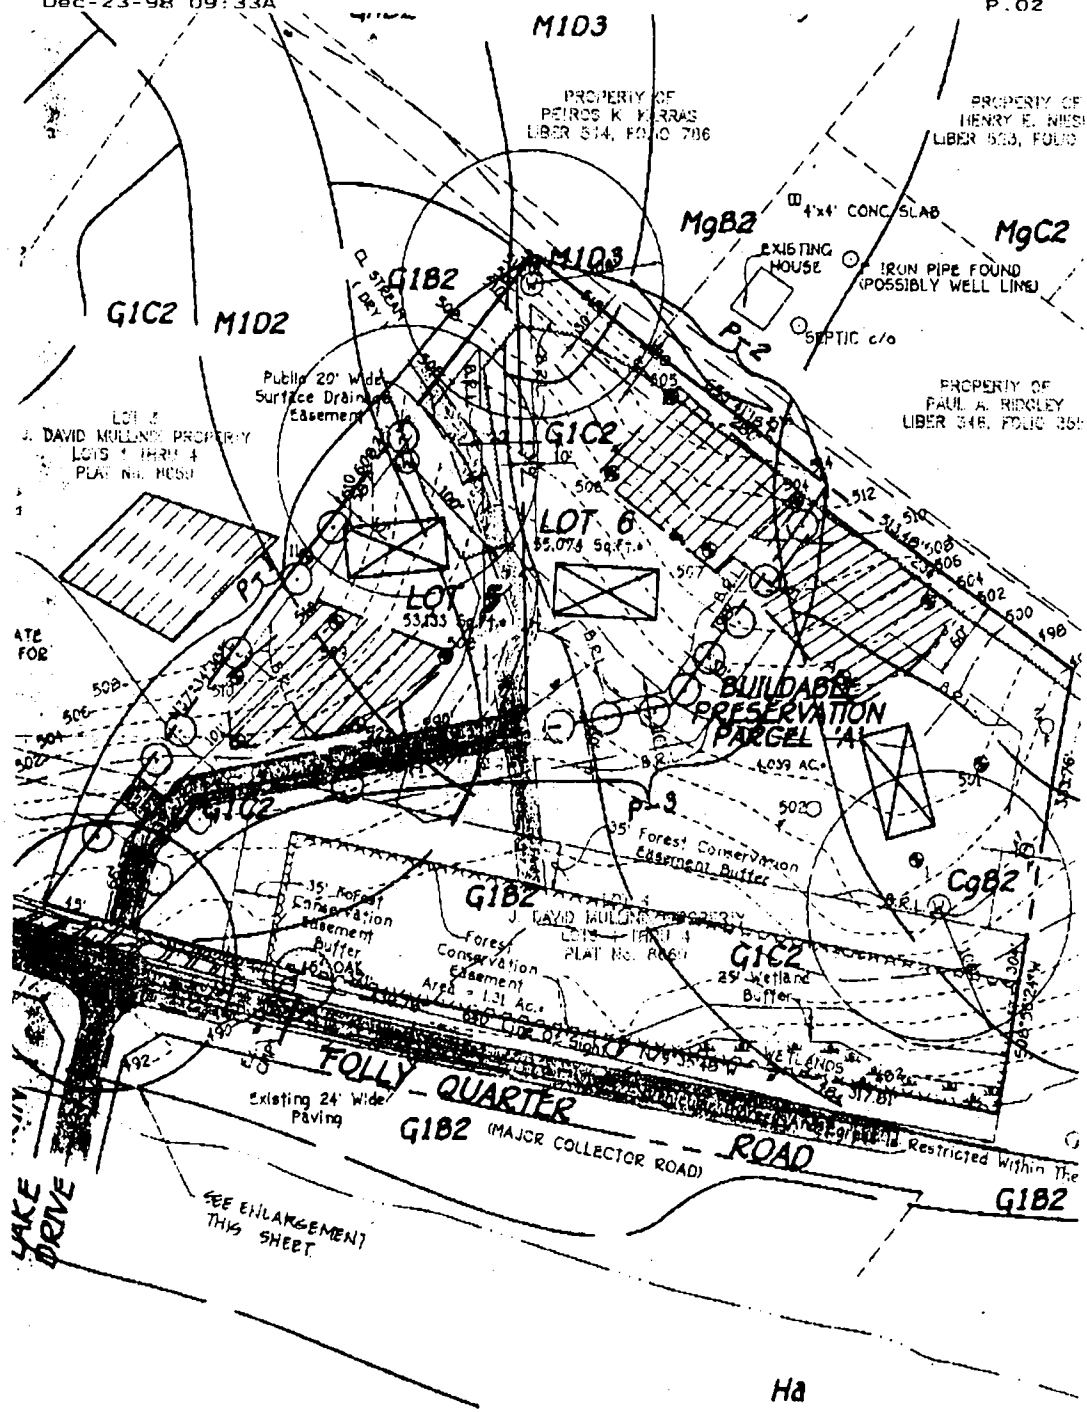

1/7/99  
 well site  
 OK as stated  
 (DKS)

E. Storday  
 fax 301-879-2667

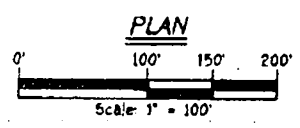

C1 07764

SEQUENCE NO. (MDE USE ONLY)

STATE OF MARYLAND WELL COMPLETION REPORT

THIS REPORT MUST BE SUBMITTED AFTER WELL IS COMPLETED.

COUNTY NUMBER A58533

ST/CO USE ONLY DATE RECEIVED

DATE WELL COMPLETED 05/17/00

DEPTH OF WELL 200 (TO NEAREST FOOT)

PERMIT NO. FROM "PERMIT TO DRILL WELL" HO-94-2680

OWNER Mitchell + Best STREET OR RD 13036 Folly Quarter Road TOWN Glenelg SUBDIVISION Buckskin Lake Overlook SECTION LOT 6

WELL LOG

Not required for driven wells

STATE THE KIND OF FORMATIONS PENETRATED, THEIR COLOR, DEPTH, THICKNESS AND IF WATER BEARING

Table with columns: DESCRIPTION, FEET (FROM, TO), check if water bearing. Rows include Topsoil, Shaley Clay, Sand, Sand Stone, boulders, Sand Stone, Mica, Sand Stone, Mica, Sand Stone, Mica.

GROUTING RECORD

WELL HAS BEEN GROUTED (Circle Appropriate Box) YES (Y) NO (N)

TYPE OF GROUTING MATERIAL (Circle one) CEMENT (CM) BENTONITE CLAY (BC)

NO. OF BAGS 42 NO. OF POUNDS 4200

GALLONS OF WATER 252

DEPTH OF GROUT SEAL (to nearest foot) 40

CASING RECORD

casings types insert appropriate code below: ST (STEEL), CO (CONCRETE), PL (PLASTIC), OT (OTHER)

MAIN CASING TYPE: ST 6 104

OTHER CASING (if used) diameter depth (feet)

SCREEN RECORD

screen type or open hole: ST (STEEL), BR (BRASS), HO (OPEN HOLE), PL (PLASTIC), OT (OTHER)

DEPTH (nearest ft.)

Table with columns: E, A, C, H, S, R, E, N. Rows for casing and screen depths.

GRAVEL PACK IF WELL DRILLED WAS FLOWING WELL INSERT F IN BOX 68

MDE USE ONLY (NOT TO BE FILLED IN BY DRILLER) (E.R.O.S.)

TELESCOPE CASING LOG INDICATOR OTHER DATA

PUMPING TEST

HOURS PUMPED (nearest hour) 3

PUMPING RATE (gal. per min.) 15

METHOD USED TO MEASURE PUMPING RATE Bucket

WATER LEVEL (distance from land surface)

BEFORE PUMPING 20 ft.

WHEN PUMPING 123 ft.

TYPE OF PUMP USED (for test)

Selections: A (air), P (piston), T (turbine), C (centrifugal), R (rotary), O (other), J (jet), S (submersible)

PUMP INSTALLED

DRILLER INSTALLED PUMP (CIRCLE) YES (NO)

IF DRILLER INSTALLS PUMP, THIS SECTION MUST BE COMPLETED FOR ALL WELLS.

TYPE OF PUMP INSTALLED PLACE (A,C,J,P,R,S,T,O) IN BOX 29

CAPACITY: GALLONS PER MINUTE (to nearest gallon) 31

PUMP HORSE POWER 37

PUMP COLUMN LENGTH (nearest ft.) 43


CASING HEIGHT (circle appropriate box and enter casing height)

LAND SURFACE

below 2 (nearest foot)

LOCATION OF WELL ON LOT

SHOW PERMANENT STRUCTURES AND INDICATE NOT LESS THAN TWO DISTANCES (MEASUREMENTS TO WELL)

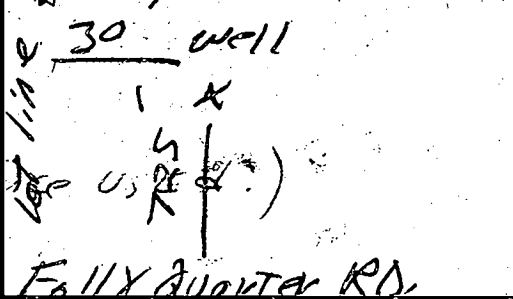

NUMBER OF UNSUCCESSFUL WELLS: 0

WELL HYDROFRACTURED YES (Y) NO (N)

CIRCLE APPROPRIATE LETTER: A (ABANDONED), E (ELECTRIC LOG), P (TEST WELL CONVERTED)

I HEREBY CERTIFY THAT THIS WELL HAS BEEN CONSTRUCTED IN ACCORDANCE WITH COMAR 26.04.04 "WELL CONSTRUCTION" AND IN CONFORMANCE WITH ALL CONDITIONS STATED IN THE ABOVE CAPTIONED PERMIT...

DRILLERS LIC. NO. MW0040 GEORGE F. HARTENBERG

LIC. NO. MW0501 CHARLES P. FELLER

SITE SUPERVISOR (sign. of driller or journeyman responsible for sitework if different from permittee)

B 1 14299

SEQUENCE NO. (MDE USE ONLY)

STATE OF MARYLAND PERMIT TO DRILL WELL please print or type

STATE PERMIT NUMBER

H0 - 94 - 2680 fill in this form completely

Date Received (APA)

OWNER INFORMATION RN 8208

B 3

LOCATION OF WELL

CC#

8 MM DD YY 13

Mitchell & Best

Howard

8 COUNTY

Buckskin Lake Overlook

15 Last Name Owner First Name 34

1686 E. Gude Dr.,

23 SUBDIVISION 42

36 Street or RFD 55

Rockville, Md 20850

SECTION 44 46 LOT 48 50

Glenelg

57 Town 70 State 72 Zip 76

52 NEAREST TOWN 71

MILES FROM TOWN (enter 0 if in town) 1 M 73 76 77 78

DRILLER INFORMATION

George F. Easterday M W 040

Driller's Name 76 License No. 81

L. Franklin Easterday, Inc.

Firm Name


9265 Brown Church Rd.. MT. Airv. Md. 21771

Address

Signature Date 3/29/2000

B 4

DIRECTION OF WELL FROM TOWN (CIRCLE BOX)

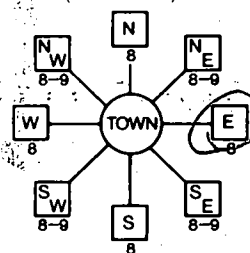

Folly Quarter Rd 11 NEAR WHAT ROAD 30

ON WHICH SIDE OF ROAD (CIRCLE APPROPRIATE BOX)



34 725 37 DISTANCE FROM ROAD ENTER FT OR MI 38 Ft 39

TAX MAP: 22 BLK: 16+22 PARCEL 73

B 2 WELL INFORMATION APPROX. PUMPING RATE (GAL. PER MIN.) 5

7 2 8 12

AVERAGE DAILY QUANTITY NEEDED (GAL. PER DAY) 500 14 20

USE FOR WATER (CIRCLE APPROPRIATE BOX)

- D DOMESTIC POTABLE SUPPLY & RESIDENTIAL IRRIGATION
F FARMING (LIVESTOCK WATERING & AGRICULTURAL IRRIGATION
I INDUSTRIAL, COMMERCIAL, DEWATERING
P PUBLIC WATER SUPPLY WELL
T TEST, OBSERVATION, MONITORING
G GEO-THERMAL

NOT TO BE FILLED IN BY DRILLER HEALTH DEPARTMENT APPROVAL

Howard A58533 COUNTY NAME COUNTY NO.

STATE SIGNATURE INSERT S 41

DATE ISSUED 5-9-00 Brian Baker 5-9-01

43 MM DD YY 48 CO SIGNATURE EXP. DATE

NORTH GRID 519 0 0 0 EAST GRID 809 0 0 0

APPROXIMATE DEPTH OF WELL 300 FEET 24 28

APPROXIMATE DIAMETER OF WELL 6 NEAREST INCH

METHOD OF DRILLING (circle one)

- BORED (or Augered) JETTED Jettled & DRIVEN
AIR-ROTARY AIR-PERCussion ROTARY (Hydraulic Rotary)
CABLE REVerse-ROTARY DRive-POINT
other

REPLACEMENT OR DEEPEINED WELLS (CIRCLE APPROPRIATE BOX)

- N THIS WELL WILL NOT REPLACE AN EXISTING WELL
Y THIS WELL WILL REPLACE A WELL THAT WILL BE ABANDONED AND SEALED
S THIS WELL WILL REPLACE A WELL THAT WILL BE USED AS A STANDBY-CONTACT LOCAL APPROVING AUTHORITY FOR POLICY ON STANDBY WELLS
D THIS WELL WILL DEEPEIN AN EXISTING WELL
PERMIT NUMBER OF WELL TO BE REPLACED OR DEEPEINED (IF AVAILABLE) 41 52

SHOW MAJOR FEATURES OF BOX & LOCATE WELL WITH AN X

SOURCES OF DRILLING WATER

- 1. wells
2.
3.

WRITE THE BOX NUMBER FROM THE MAP HERE

E 809

N 519

DRAW A SKETCH BELOW SHOWING LOCATION OF WELL IN RELATION TO NEARBY TOWNS AND ROADS AND GIVE DISTANCE FROM WELL TO NEAREST ROAD JUNCTION

MAP 10 A11 10 A 11


Not to be filled in by driller (MDE OR COUNTY USE ONLY)


APPROP. PERMIT NUMBER 54 GAP 63

PERMIT No. H0-94-2680 70 71 72 73 74 75 76 77 78 79

SPECIAL CONDITIONS

NOTE - APPROVING AUTHORITIES SHOULD USE SEPARATE SHEET IF NEEDED -

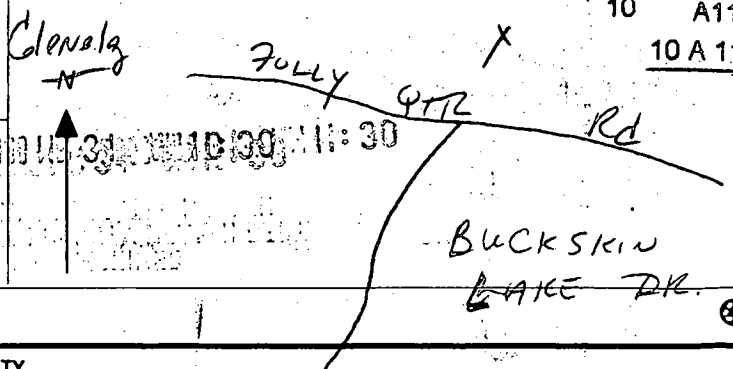

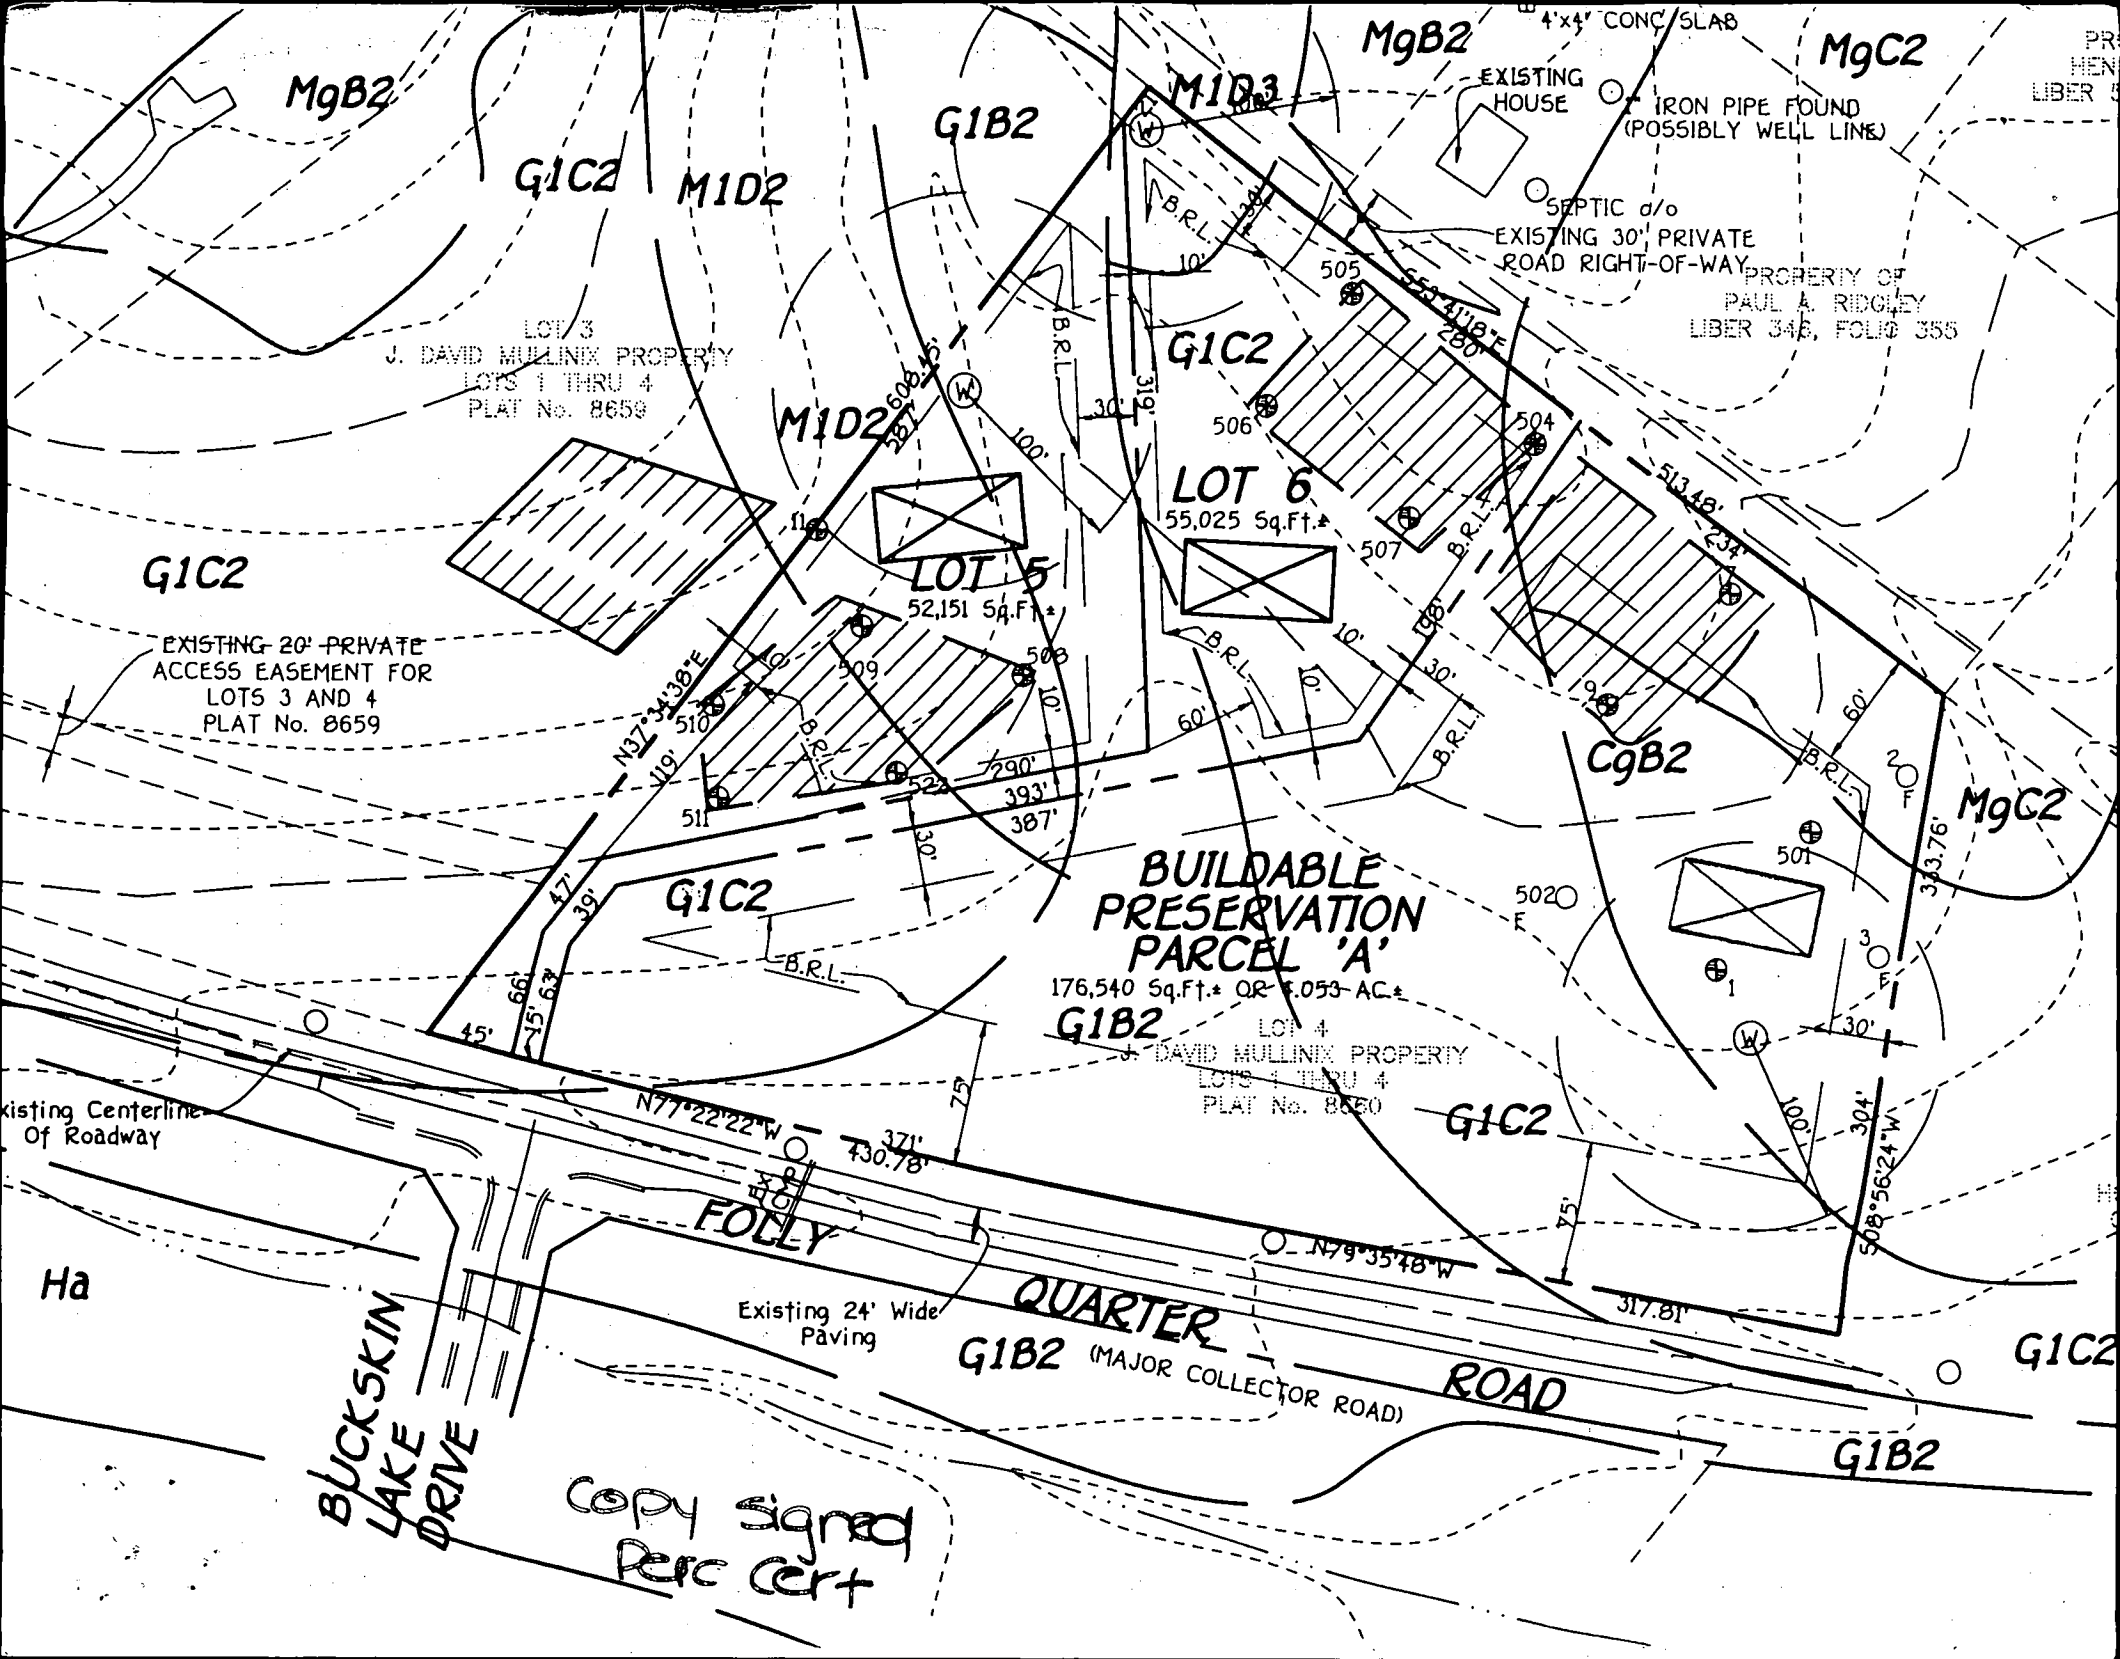

M9B2

G1C2 M1D2

G1B2

M1D3

M9B2

M9C2

LOT 3  
J. DAVID MULLINX PROPERTY  
LOTS 1 THRU 4  
PLAT No. 8659

EXISTING HOUSE  
SEPTIC d/o  
EXISTING 30' PRIVATE ROAD RIGHT-OF-WAY  
PROPERTY OF PAUL A. RIDGLEY  
LIBER 348, FOLIO 355

G1C2

EXISTING 20' PRIVATE ACCESS EASEMENT FOR LOTS 3 AND 4  
PLAT No. 8659

M1D2

LOT 5  
52,151 Sq.Ft.\*

LOT 6  
55,025 Sq.Ft.\*

**BUILDABLE PRESERVATION PARCEL 'A'**  
176,540 Sq.Ft.\* OR 4.053-AC\*  
G1B2

LOT 4  
J. DAVID MULLINX PROPERTY  
LOTS 1 THRU 4  
PLAT No. 8659

C9B2

M9C2

G1C2

G1C2

Existing Centerline Of Roadway

Ha

BUCKSKIN LAKE DRIVE

COPY signed Perc Cert

FOLLY


QUARTER

G1B2 (MAJOR COLLECTOR ROAD)

ROAD

G1B2

G1C2

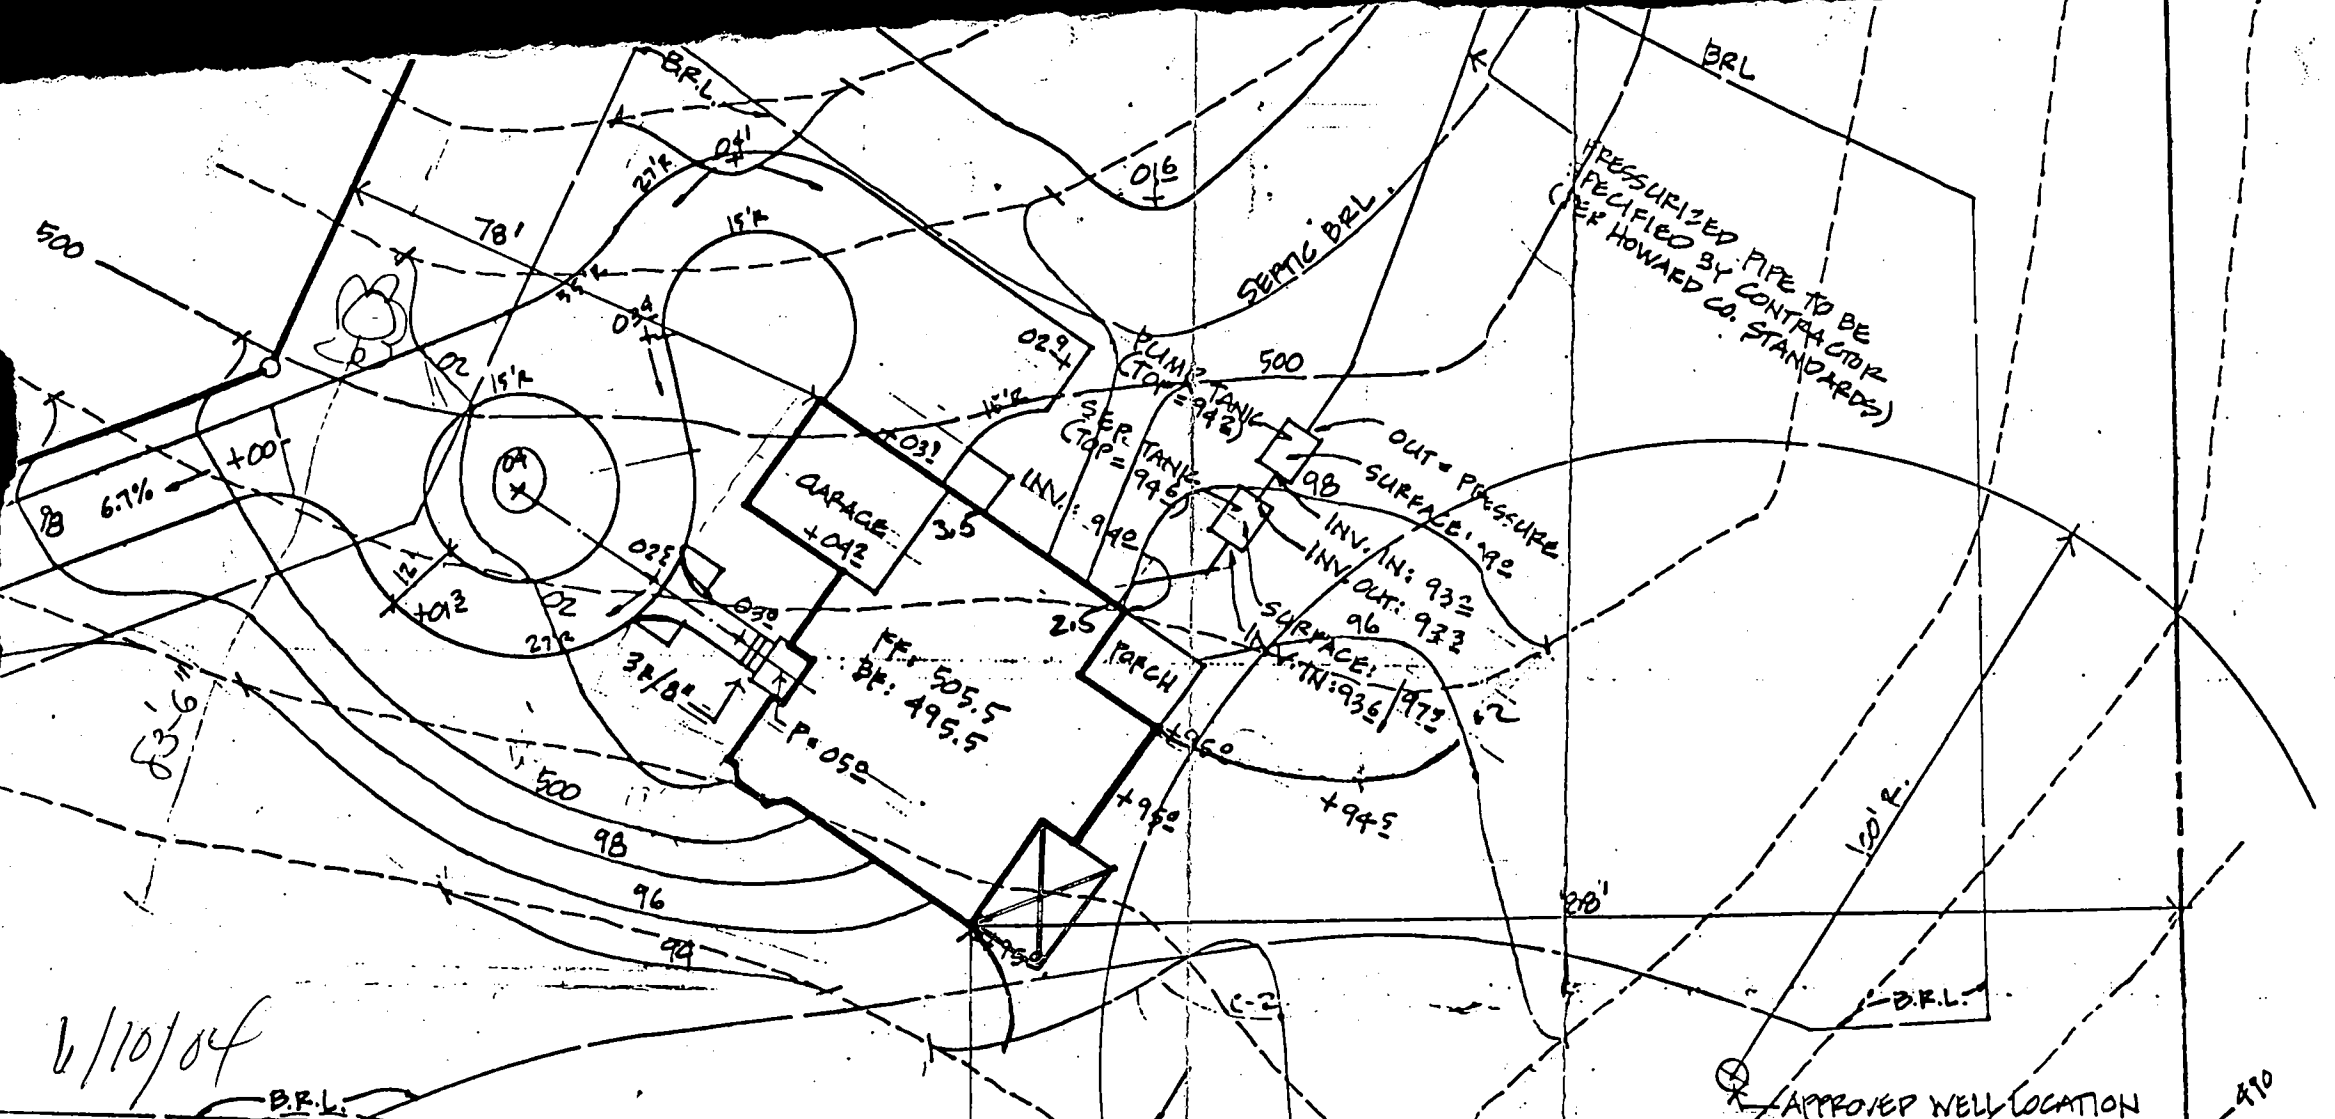

6/10/04

13036 Folly Quarter  
 BPO0048850 OK

No well or septic  
 issues  
 proposed deck  
 OK

Kacie  
 Moran

FOREST CONSERVATION ESMT.

APPROVED WELL LOCATION  
 SURFACE E.L.: 494.5

100' WETLAND BUFFER

167'