

# APPLICATION

A 16330

P \_\_\_\_\_

SEWAGE DISPOSAL TESTING

MARYLAND STATE DEPARTMENT OF HEALTH

HOWARD COUNTY

ELLICOTT CITY

DISTRICT 4

DATE 9/24/71

TO: THE COUNTY HEALTH OFFICER  
ELLICOTT CITY, MARYLAND

I, HEREBY, APPLY FOR THE NECESSARY TESTS IN ORDER TO CONSTRUCT (OR RECONSTRUCT) A SEWAGE DISPOSAL SYSTEM.

PROPERTY OWNER Clarence E. Bassler

ADDRESS 1894 Daisy Road, Woodbine, Md., 21797 PHONE 489-4461

PROPERTY LOCATION:

SUBDIVISION \_\_\_\_\_ LOT NO. 8

ROAD AND DESCRIPTION Daisy Rd., lml. on right off Rt. 144 (barn sits right beside road)

OCCUPANT \_\_\_\_\_ PHONE \_\_\_\_\_

PERSON TO CONSTRUCT SYSTEM William Hopkins  
Jennings Chapel Rd.

ADDRESS Woodbine, Md. PHONE \_\_\_\_\_

SIZE OF LOT 5.5712 acres TYPE BLDG. 3 NUMBER OF BEDROOMS \_\_\_\_\_

IF NOT SINGLE RESIDENCE DESCRIBE Single Family Dwlg.

SIGNATURE OF APPLICANT Clarence E. Bassler

APPROVED BY \_\_\_\_\_ FOR \_\_\_\_\_ (KIND OF SYSTEM) \_\_\_\_\_ DATE \_\_\_\_\_

REJECTED BY \_\_\_\_\_ FOR \_\_\_\_\_ (KIND OF SYSTEM) \_\_\_\_\_ DATE \_\_\_\_\_

HOLD PENDING FURTHER TESTS \_\_\_\_\_ DATE \_\_\_\_\_

REASONS FOR REJECTION OR HOLDING \_\_\_\_\_


ORIGINATED BY \_\_\_\_\_

FILED IN \_\_\_\_\_

# THIS IS NOT A PERMIT

00331 A

APPLICANT  
1685

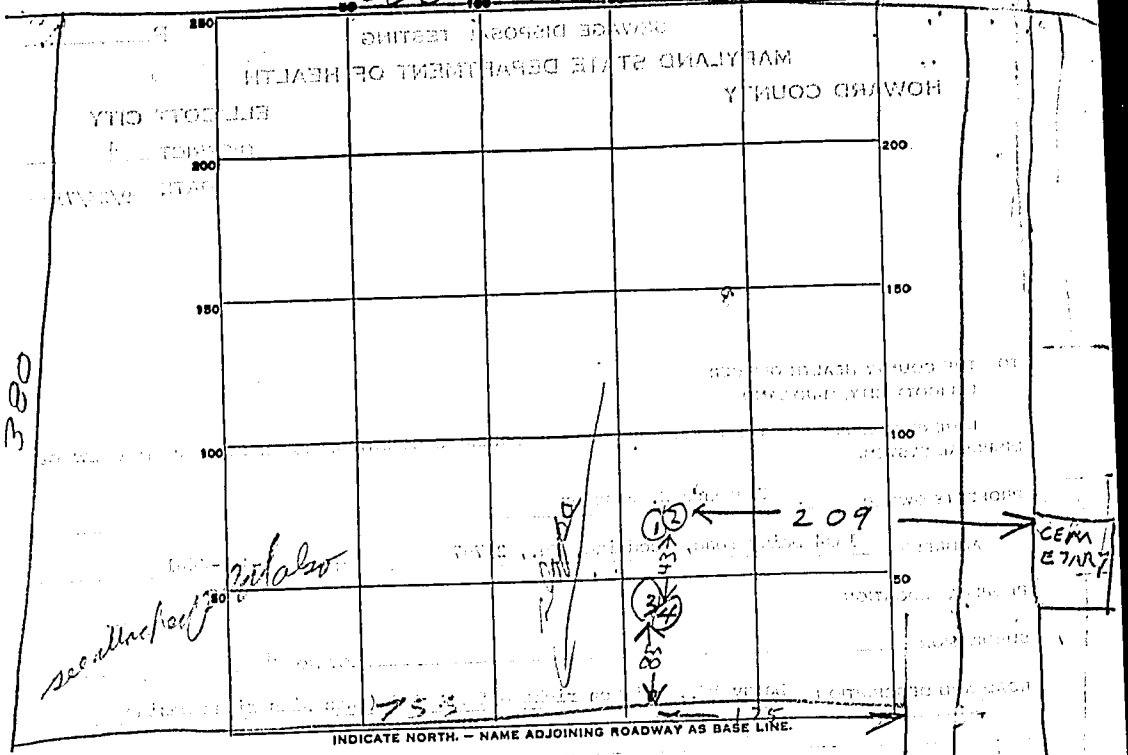

INDICATE NORTH. - NAME ADJOINING ROADWAY AS BASE LINE.

DATE	TEST NO.	DEPTH	PRE-WET		TEST - 1" DROP		TIME
			START	STOP	START	STOP	
10/27/71	1	11	1020	1022	1022	1026	4
	2	5	1021	1028	1028	1034	6
	3	11 1/2	1024	1025	1025	1029	2
	4	5	1029	1034	1034	1037	3

SOIL AUGER FINDING

TESTED BY *B. Hodge*

REMARKS *Baseline Testing shows does not have overflowing system*