

Permit of J.H. 8-4-70c

check out
Permit 8/14/70
AM.

PERMIT

SEWAGE DISPOSAL SYSTEM

P 15414
58905-B
A 13006

MARYLAND STATE DEPARTMENT OF HEALTH

HOWARD COUNTY

03-295044

ELLICOTT CITY

DISTRICT 3

INDEXED

DATE 7/20/70

Paul Gregor IS PERMITTED TO INSTALL ALTER

ADDRESS Wright Road, Hanover, Md. PHONE 796-0952

A SEWAGE DISPOSAL SYSTEM LOCATED AT _____

SUBDIVISION Woodmark, Inc. ROAD Fawnhaven Court LOT 28, Blk. B,
Sec. 2

PROPERTY OWNER Mr. and Mrs. Robert F. Sandosky

ADDRESS _____

SPECIFICATIONS - 3 or 4 bedrooms

DRAIN FIELD _____ DEPTH _____ FEET, BOTTOM AREA _____ SQ. FT.

SEEPAGE PITS _____ ABSORBENT SIDE-WALL AREA _____ SQ. FT.

SEPTIC TANK CAPACITY 750 GALLONS for 3 bedrooms
1,000 " " 4 "

FOR GARBAGE GRINDER, INCREASE DISPOSAL AREA 22% & TANK CAPACITY 50%.

OTHER Dry well - 112 sq. ft. absorbent sidewall area per bedroom to begin below the first 6 ft. of non-absorbent ground. Max. depth of dry well below original grade is 15 ft. Place dry well 40 ft. from front line and 120 ft. from right side line as seen when facing from Fawnhaven Court.

NOTE: ALL PIPE FROM HOUSE TO SEPTIC TANK MUST BE CAST IRON.

PERMIT VOID AFTER THREE YEARS.

PLANS APPROVED BY D. W. Monaghan DATE 3/12/68


FILL SEPTIC TANK AND DISTRIBUTION BOX WITH WATER BEFORE CALLING FOR AN INSPECTION. COVER NO WORK UNTIL INSPECTED AND APPROVED.

NEITHER THE HOWARD COUNTY COMMISSIONERS NOR THE HEALTH DEPARTMENT IS RESPONSIBLE FOR THE SUCCESSFUL OPERATION OF ANY SYSTEM.

A
58905-B
13006

13

60
7.5
420
30

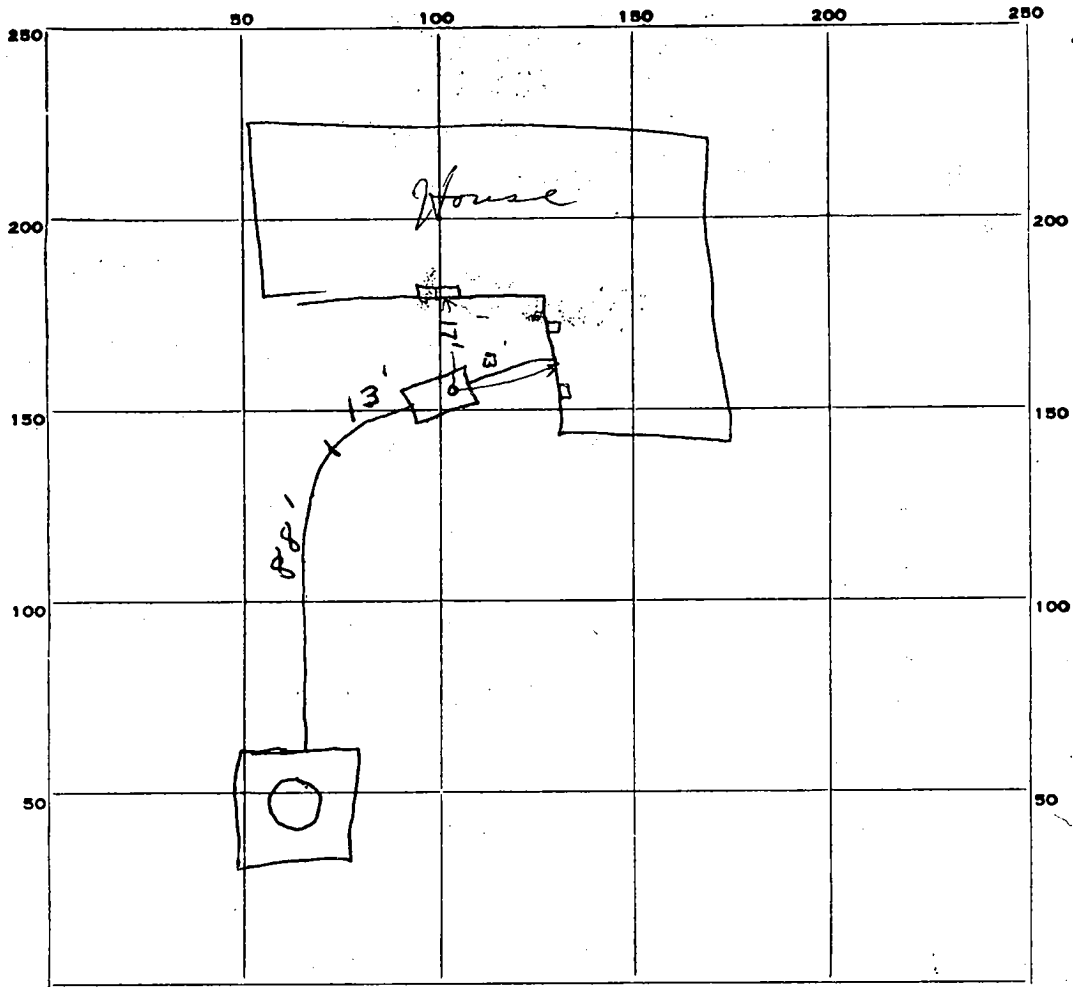

INDICATE NORTH. - NAME ADJOINING ROADWAY AS BASE LINE.

PERMIT CARD Leaverton road

SEPTIC TANK, LEVEL CLEANOUTS _____

DISTRIBUTION BOX, LEVEL _____

TILE FIELD, DEPTH _____ FT. TRENCH WIDTH _____ FT.

GRAVEL DEPTH _____ IN. TOTAL LENGTH _____ FT.


NUMBER OF TRENCHES _____ TOTAL BOTTOM AREA _____

SEEPAGE PITS, INSIDE DIAMETER Perimeter 60 FT. DEPTH BELOW INLET 7 1/2 FT.

ABSORBENT AREA 450 SQ. FT.

REMARKS _____

DATE SYSTEM APPROVED 8-4-70. INSPECTOR Fromme Lt

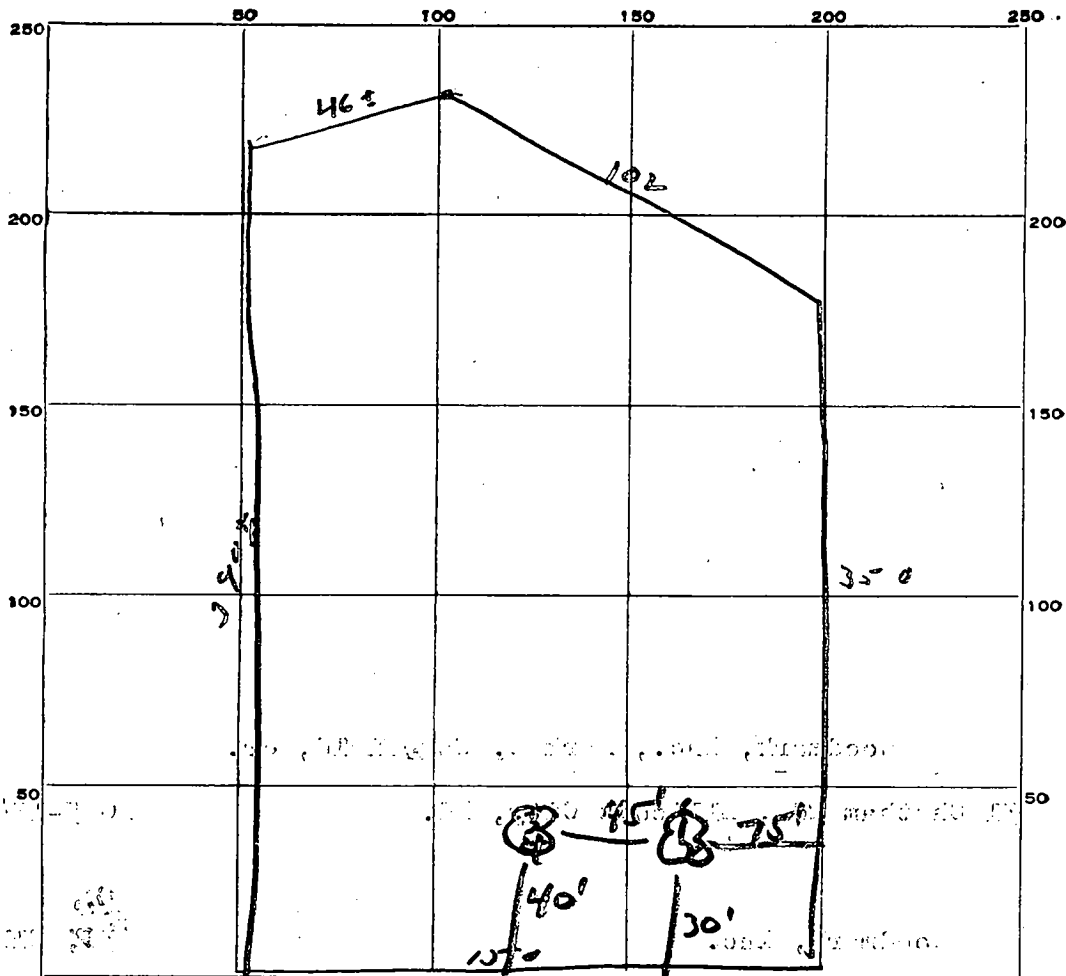

INDICATE NORTH. - NAME ADJOINING ROADWAY AS BASE LINE.

Court D

DATE	TEST NO.	DEPTH	PRE-WET		TEST - 1" DROP		TIME
			START	STOP	START	STOP	
8/15/67	1	6'	11:37	slow pour	30 min		
	2	15'	11:38	11:42	11:42	11:51	9 min
	3	4'	11:40	slow pour	30 min		
	4	11'	11:41	11:43	11:43	11:46	3 min

SOIL AUGER FINDING

TESTED BY JHK + DM

REMARKS

28
B

WR-W 43569
 C 1 87.56
 1 2 3 (SEQ. NO.) 6
 (THIS NUMBER IS TO BE PUNCHED IN COLS. 3-6 ON ALL CARDS)

SEQUENCE NO. (DWR USE ONLY)

STATE OF MARYLAND
 DEPARTMENT OF WATER RESOURCES
 STATE OFFICE BLDG., ANNAPOLIS, MARYLAND 21401
WELL COMPLETION REPORT

THIS REPORT MUST BE SUBMITTED WITHIN 30 DAYS AFTER COMPLETION OF THE WELL
FILL IN THIS FORM COMPLETELY

DATE RECEIVED (DWR USE ONLY)
 DATE WELL COMPLETED
 August 11, 1970

DEPTH OF WELL
 156
 22 (TO NEAREST FOOT) 26

PERMIT NO. FROM PERMIT TO DRILL WELL
 40-70-0181
 28 29 30 31 32 33 34 35 36 37
 DRILLERS IDENTIFICATION NO. 256

OWNER *Sandosky* LAST NAME *Robert F.* FIRST NAME
 STREET OR RFD *9212 Gorman Ave* POST OFFICE *Laurel, Md*

WELL LOG

STATE THE KIND OF FORMATIONS PENETRATED, THEIR COLOR, DEPTH, THICKNESS AND IF WATER BEARING

DESCRIPTION (USE ADDITIONAL SHEETS IF NECESSARY)	FEET		CHECK IF WATER BEARING
	FROM	TO	
<i>dirt</i>	0	2	
<i>Sand</i>	2	50	
<i>Hard Br Sandstone</i>	50	67	
<i>Flint</i>	67	68	✓
<i>Hard Black Granite</i>	68	80	
<i>Flint</i>	80	81	✓
<i>Hard Black Granite</i>	81	156	

WELL DESCRIPTION

GROUTING RECORD
 WELL HAS BEEN GROUTED (CIRCLE APPROPRIATE BOX)
 YES Y 46 NO N 46

DEPTH OF GROUT SEAL (TO NEAREST FOOT)
 FROM 0 FT. TO 52 FT.
 (ENTER 0 IF FROM SURFACE)

CASING RECORD
 INSERT APPROPRIATE CODE BELOW
 S STEEL C CONCRETE
 P PLASTIC O OTHER

MAIN CASING TYPE S T
 NOMINAL DIAMETER TOP (MAIN) CASING (NEAREST INCH) 6"
 TOTAL DEPTH OF MAIN CASING (NEAREST FOOT) 54'

OTHER CASING (IF USED)
 E A C H C A S I N G
 DIAMETER (INCH) DEPTH (FEET) FROM TO

SCREEN RECORD
 SCREEN TYPE OR OPEN HOLE
 INSERT APPROPRIATE CODE BELOW
 S STEEL B BRASS OR BRONZE H OPEN HOLE
 P PLASTIC O OTHER

C 2 (SEQ. NO.)
 1 2 3 (SEQ. NO.) 6
 DEPTH (NEAREST WHOLE FOOT)
 FROM TO
 E A C H S C R E E N
 8 9 11 15 17 21
 23 24 26 30 32 36
 38 39 41 45 47 51
 53 54 56 60 62 66

SLOTS SIZE 1. 2. 3. 4.
 IF WELL DRILLED WAS A FLOWING WELL CIRCLE BOX F

DWR USE ONLY (NOT TO BE FILLED IN BY DRILLER) (E.R.O.)
 70 TELESCOPE CASING LOG INDICATOR
 W Q OTHER DATA AVAILABLE
 74 75 76

C 3 (SEQ. NO.) 6
 PUMPING TEST
 HOURS PUMPED (TO NEAREST HOUR) 8
 8 9
 PUMPING RATE (GALLONS PER MINUTE TO NEAREST GALLON) 6
 11 15

METHOD USED TO MEASURE PUMPING RATE *Flowmeter*
 WATER LEVEL: (DISTANCE FROM LAND SURFACE)
 BEFORE PUMPING 60 (NEAREST FOOT) 17 20
 WHEN PUMPING 150 (NEAREST FOOT) 22 25

TYPE OF PUMPED USED (CIRCLE APPROPRIATE BOX)
 A AIR P PISTON T TURBINE
 C CENTRIFUGAL R ROTARY O OTHER (DESCRIBE BELOW)
 J JET S SUBMERSIBLE

PUMP INSTALLED
 TYPE OF PUMP (WRITE APPROPRIATE LETTER IN BOX - SEE ABOVE: A, C, J, P, R, S, T, O)
 29
 CAPACITY:
 GALLONS PER MINUTE (TO NEAREST GALLON) 31 35
 PUMP HORSE POWER 37 41
 PUMP COLUMN LENGTH (NEAREST FOOT) 43 47

CASING HEIGHT (CIRCLE APPROPRIATE BOX AND ENTER CASING HEIGHT)
 + ABOVE - BELOW
 LAND SURFACE (NEAREST FOOT) 2 51

LOCATION OF WELL ON LOT
 SHOW PERMANENT STRUCTURE SUCH AS BUILDINGS, SEPTIC TANKS, AND/OR OTHER LAND MARKS AND INDICATE NOT LESS THAN TWO DISTANCES (MEASUREMENTS TO WELL).
well
46

CIRCLE APPROPRIATE BOXES
 A A WELL WAS ABANDONED AND SEALED WHEN THIS WELL WAS COMPLETED
 E ELECTRIC LOG OBTAINED
 C COPY OF ELECTRIC LOG ATTACHED

I HEREBY CERTIFY THAT I HAVE COMPLIED WITH ALL CONDITIONS STATED ON THE ABOVE-CAPTIONED "PERMIT TO DRILL WELL", AND THAT INFORMATION CONTAINED IN THIS REPORT IS TRUE, ACCURATE, AND COMPLETE TO THE BEST OF MY KNOWLEDGE, INFORMATION, AND BELIEF.

DRILLERS NAME
 (PLEASE PRINT) *DANA KYBERT II*
 SIGNATURE *Dana Kybert II*

