

SEQUENCE NO. **0520**
1 2 3 (SEQ. NO.) 4
(THIS NUMBER IS TO BE PUNCHED IN COPS. 3-8 ON ALL CARDS)

STATE OF MARYLAND
WATER RESOURCES ADMINISTRATION
TAWES STATE OFFICE BLDG., ANNAPOLIS, MD. 21401
WELL COMPLETION REPORT *A16330*

THIS REPORT MUST BE SUBMITTED WITHIN 30 DAYS AFTER WELL COMPLETION

FILL IN THIS FORM COMPLETELY
COUNTY NUMBER *W19566*

DATE RECEIVED (WRA USE ONLY)
3-11-74
DATE WELL COMPLETED
8-13

DEPTH OF WELL
115
22 (TO NEAREST FOOT) 20

PERMIT NO. FROM "PERMIT TO DRILL WELL"
48-15-1-0-0-0
28 29 30 31 32 33 34 35 36 37
DRILLERS IDENTIFICATION NO. *1111*

OWNER *WRIGHT EDWARDS*
LAST NAME
STREET OR RFD *19 ST AGNES RD* POST OFFICE *GREEN BAYVIEW MD 21061*

WELL LOG
STATE THE KIND OF FORMATIONS PENETRATED, THEIR COLOR, DEPTH, THICKNESS AND IF WATER BEARING

DESCRIPTION (USE ADDITIONAL SHEETS IF NECESSARY)	FEET		CHECK IF WATER BEARING
	FROM	TO	
<i>DIRT</i>	<i>0</i>	<i>12</i>	
<i>SLATE</i>	<i>12</i>	<i>115</i>	<input checked="" type="checkbox"/>

GROUTING RECORD
WELL HAS BEEN GROUTED (CIRCLE APPROPRIATE BOX) Y N
TYPE OF GROUTING MATERIAL (CIRCLE BOX)
CEMENT C M BENTONITE CLAY B C
NO. OF BAGS *13* NO. OF POUNDS *1333*
GALLONS OF WATER *65*
DEPTH OF GROUT SEAL (TO NEAREST FOOT)
FROM *0* FT. TO *63* FT.
(ENTER 0 IF FROM SURFACE)

CASING RECORD
CASING TYPES (INSERT APPROPRIATE CODE BELOW)
STEEL S T CONCRETE C O
PLASTIC P L OTHER O T
MAIN CASING TYPE NOMINAL DIAMETER TOP (MAIN) CASING (NEAREST INCH) TOTAL DEPTH OF MAIN CASING (NEAREST FOOT)
S T *6* *65*

OTHER CASING (IF USED)
DIAMETER (INCH) DEPTH (FEET) FROM TO

SCREEN RECORD
SCREEN TYPE OR OPEN HOLE (INSERT APPROPRIATE CODE BELOW)
STEEL S T BRASS B R OPEN HOLE H O
PLASTIC P L OTHER O T

DEPTH (NEAREST WHOLE FOOT)
FROM TO
1 *40* *63* *115*
2 *23* *24* *26* *30* *32* *36*
3 *38* *39* *41* *45* *47* *51*
SLOTSIZE 1. 2. 3.

DIAMETER OF SCREEN (NEAREST INCH) FROM TO


GRAVEL PACK
IF WELL DRILLED WAS A FLOWING WELL CIRCLE BOX F

WRA USE ONLY (NOT TO BE FILLED IN BY DRILLER) (E.R.O.S.)
TELESCOPE CASING T LOG INDICATOR L
74 75 76 OTHER DATA AVAILABLE W O

PUMPING TEST
C 3
1 2 3 (SEQ. NO.) 6
HOURS PUMPED (TO NEAREST HOUR) *1*
PUMPING RATE (GALLONS PER MINUTE TO NEAREST GALLON) *15*
METHOD USED TO MEASURE PUMPING RATE *MLR*
WATER LEVEL: (DISTANCE FROM LAND SURFACE) BEFORE PUMPING *50* (NEAREST FOOT)
WHEN PUMPING *17* (NEAREST FOOT) *20*
TYPE OF PUMPED USED (CIRCLE APPROPRIATE BOX) (FOR PUMPING TEST)
 A CENTRIFUGAL P PISTON T TURBINE
 C CENTRIFUGAL R ROTARY O OTHER (DESCRIBE BELOW)
 J JET S SUBMERSIBLE

PUMP INSTALLED
TYPE OF PUMP (WRITE APPROPRIATE LETTER IN BOX - SEE ABOVE: A, C, J, P, R, S, T, O) 29
DRILLER WILL INSTALL PUMP (CIRCLE APPROPRIATE BOX) YES NO
CAPACITY: GALLONS PER MINUTE (TO NEAREST GALLON) *31* *35*
PUMP HORSE POWER *37* *41*
PUMP COLUMN LENGTH (NEAREST FOOT) *43* *47*
CASING HEIGHT (CIRCLE APPROPRIATE BOX AND ENTER CASING HEIGHT)
 ABOVE LAND SURFACE BELOW
2 (NEAREST FOOT)

LOCATION OF WELL ON LOT
SHOW PERMANENT STRUCTURE SUCH AS BUILDINGS, SEPTIC TANKS, AND/OR OTHER LAND MARKS AND INDICATE NOT LESS THAN TWO DISTANCES (MEASUREMENTS TO WELL).

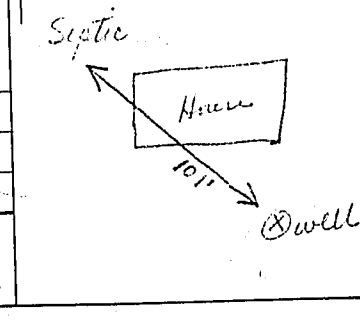

CIRCLE APPROPRIATE BOXES
 A WELL WAS ABANDONED AND SEALED WHEN THIS WELL WAS COMPLETED
 E ELECTRIC LOG OBTAINED
 P TEST WELL CONVERTED TO PRODUCTION WELL
I HEREBY CERTIFY THAT I HAVE COMPLIED WITH ALL CONDITIONS STATED ON THE ABOVE-CAPTIONED "PERMIT TO DRILL WELL", AND THAT INFORMATION CONTAINED IN THIS REPORT IS TRUE, ACCURATE, AND COMPLETE TO THE BEST OF MY KNOWLEDGE, INFORMATION AND BELIEF.
DRILLERS NAME *HEUSER-CARVER WELL DRILLING, INC.*
(PLEASE PRINT)
SIGNATURE *Ouston A. Carver*