

3/24/97
A.M.
4:17/97
(to follow
(to arc)
5/16/97
ASAP
5/5/97
C.O.
noon

PERMIT

SEWAGE DISPOSAL SYSTEM

DEPARTMENT OF HEALTH AND MENTAL HYGIENE

P 58053B

A REPAIR

DISTRICT _____

DATE 3/28/97

DATE SYSTEM APPROVED 5/10/97

INSPECTOR DKS/KCM

371139

INDEXED

HOWARD COUNTY HEALTH DEPARTMENT
BUREAU OF ENVIRONMENTAL HEALTH
~~XXXXXXX~~ 313-2640

Jack Fyock Septic Services _____ IS PERMITTED TO INSTALL _____ ALTER X

ADDRESS 13775 Triadelphia Road, Glenelg, Maryland 21737 PHONE 988-9270

SUBDIVISION Greenwood Farms LOT 45 ROAD 7541 Greenwood Drive

PROPERTY OWNER Gueritot
7541 Greenwood Drive

ADDRESS _____

SEPTIC TANK CAPACITY 1000 ^(existing) GALLONS 1000gal Top Seamed Pump Chamber and Pump Required
(Replacement of existing 1000 septic tank with a top seamed unit
is strongly recommended)

NUMBER OF BEDROOMS 3

125 SQUARE FEET PER BEDROOM (Below 2 ft depth soils very sandy loam; free water seepage
and caving below 9 ft; grey bottles below 6 ft).

LINEAR FEET OF TRENCH REQUIRED 125

REPAIR - PURPOSE - SEPTIC SYSTEM HAS FAILED
Call for inspection when ground is opened so sanitarian can recommend repair.
03/24/97

Shallow septic repair system only. 3ft wide trenches, 2ft stone fill; Maximum depth
4 1/2 ft, install 125 ft of trench (if 4 or 5 ft trench widths are used -> 375 square
foot of bottom trench or bed is minimum requirement). Install trenches on contour
toward back of property; keep at highest elevation possible and at least 60 ft from owner's well.
Call for open trench inspection before proceeding. JJP 4/18/97


PLANS APPROVED BY _____ DATE _____

- COVER NO WORK UNTIL INSPECTED AND APPROVED
- NEITHER THE HOWARD COUNTY COUNCIL NOR THE HEALTH DEPARTMENT IS RESPONSIBLE FOR THE SUCCESSFUL OPERATION OF ANY SYSTEM
- NOTE: CLEANOUT REQUIRED EVERY 70 FEET OF SEWER LINE AND/OR AT 90° SWEEPS IN LINES FROM HOUSE TO DRAIN FIELDS, 90° ELBOWS NOT ACCEPTABLE.
- NOTE: ALL PARTS OF SEPTIC SYSTEMS (I.E. TANK, DISTRIBUTION BOX TRENCHES) TO BE 100 FEET FROM WELL (UNLESS OTHERWISE SPECIFICALLY AUTHORIZED)
- NOTE: IF DEEP TRENCH(ES) ARE USED CALL FOR INSPECTION BEFORE AND AFTER PLACING GRAVEL IN TRENCH(ES)
- NOTE: NO DRY WELL SHALL EXCEED 15 FOOT IN DIAMETER NO ABSORPTION TRENCH TO EXCEED 100 FEET IN LENGTH
- NOTE: ALL PIPE FROM HOUSE TO SEPTIC TANK MUST BE CAST IRON OR SCHEDULE 35/40 PVC OR ABS
- PERMIT VOID AFTER TWO YEARS
- NOTE: INSTALL STAND PIPE ON SEPTIC TANK AND DRY WELL STAND PIPES MUST BE 6 INCHES IN DIAMETER CAST IRON. CONCRETE OR TERRA COTTA OR PVA OR ABS ACCEPTED. IF TOP OF SEPTIC TANK IS DEEPER THAN 3 FEET. MANHOLE TO GRADE REQUIRED.
- NOTE: DISTRIBUTION BOXES MUST HAVE BAFFLES

***INSTALLER IS RESPONSIBLE FOR OBTAINING FINAL APPROVAL ON THIS PERMIT**

P 58053-B

0.0' **(B)** topsoil
 1.0' heavy loam sandy clay orange
 2.5' loamy sand or tan grey
 6.0' grey loamy sand
 9.0' WATER

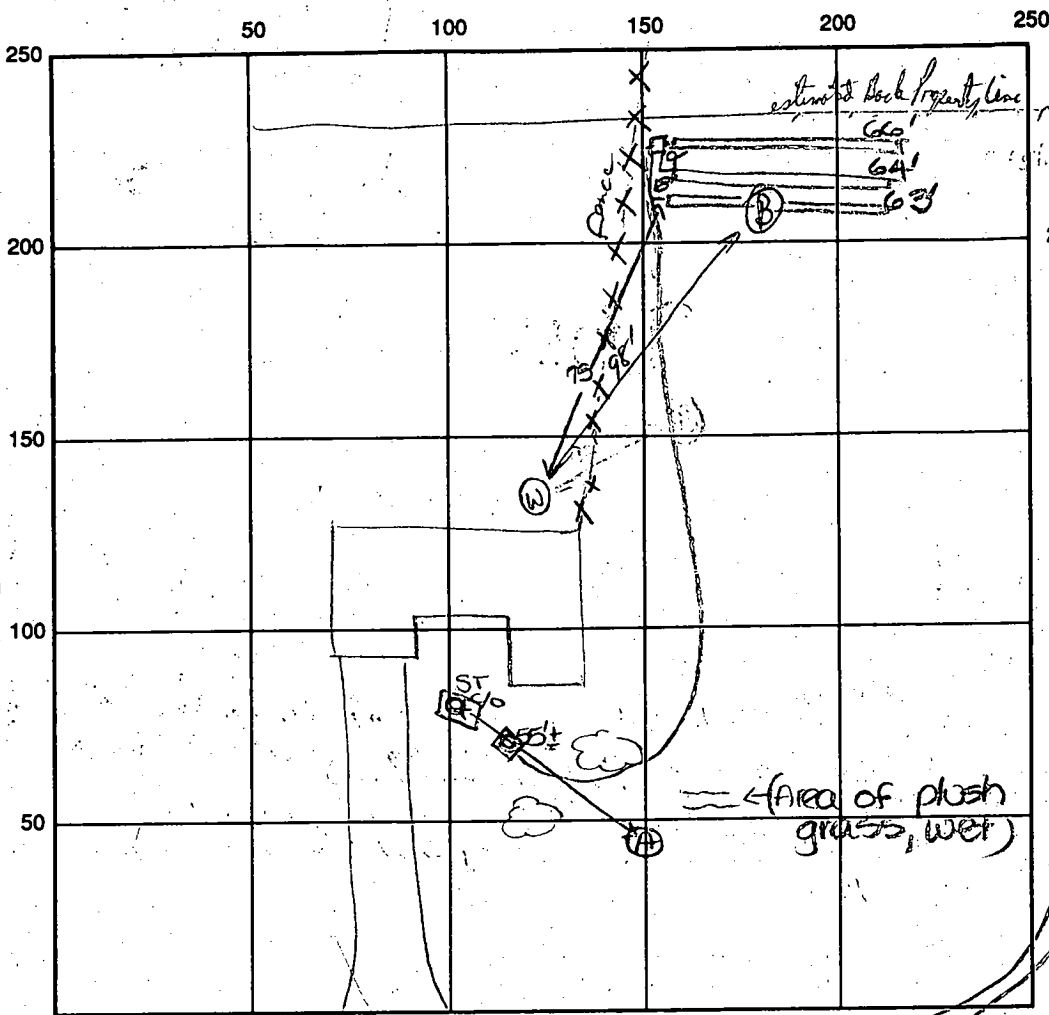

(A)
 topsoil
 org brn clim
 4'
 6' water seepage
 WATER
 CAVE

INDICATE NORTH - NAME ADJOINING ROADWAY AS BASE LINE

Greenwood Drive

SEPTIC TANK LEVEL _____ CLEANOUTS _____
 DISTRIBUTION BOX LEVEL _____
 DRAIN FIELD/TITLE DEPTH 5 FT. TRENCH WIDTH 3 FT. INLET DEPTH 2 FT.
 EFFECTIVE GRAVEL DEPTH 3 FT. TOTAL LENGTH 193 FT. (106' @ 63' → 193'
 NUMBER OF TRENCHES 3 ONE SIDEWALL/BOTTOM AREA 579 SQ. FT.
 DRYWALL INSIDE DIAMETER _____ FT. EFFECTIVE DEPTH BELOW INLET _____ FT.
 ABSORBENT AREA 579 SQ. FT.

REMARKS: 3/24/97 Perc hole (A) fails. Homeowner not present.
R. Fyock and I were unable to locate well or property markers. No further work done today. DKS
5/5/97 OK to cover trenches and continue. DKS
5/6/97 OK to cover pump pit and line to dist. box. DKS
Pump to be installed 5/10/97 at P11111
 DATE SYSTEM APPROVED 5/16/97 INSPECTOR [Signature]
5/16/97 FINAL INSP - Pump check OK. DKS / KAM

9/24/60 9:30 - school?
9/29/60 - check
approved

PERMIT

SEWAGE DISPOSAL SYSTEM

MARYLAND STATE DEPARTMENT OF HEALTH

HOWARD COUNTY

ELLICOTT CITY

DISTRICT 3

INDEXED

DATE 9/24/60

P. 08303
A. 08320

Tattrie & Levy IS PERMITTED TO INSTALL ALTER
ADDRESS Simpsonville PHONE Atlas 6-3046

A SEWAGE DISPOSAL SYSTEM LOCATED AT _____

SUBDIVISION Greenwood Farms, Inc. ROAD Greenwood Ave. LOT 48

PROPERTY OWNER Dutwiler, Frank

ADDRESS 10,424 Edgewood Ave., Silver Spring

SPECIFICATIONS

DRAIN FIELD 3 DEPTH _____ FEET. BOTTOM AREA _____ SQ. FT.

SEWAGE PITS _____ ABSORBENT SIDEWALL AREA _____ SQ. FT.

SEPTIC TANK CAPACITY 300 GALLONS

FOR GARBAGE GRINDER, INCREASE DISPOSAL AREA 25% & TANK CAPACITY 50%

OTHER System must be installed in area that passed perc. tests.

9/21/60 300 sq. FT. of drywell sidewall area
below the inlet. 5 feet 3 FT of ground
included in area. locate dry well 45 FT behind
house and 5 FT off right side corner of house. J.H.

PLANS APPROVED BY James E. Hennigan DATE 6/20/60

FILL SEPTIC TANK AND DISTRIBUTION BOX WITH WATER BEFORE CALLING FOR AN INSPECTION. COVER NO WORK UNTIL INSPECTED AND APPROVED.

NEITHER THE HOWARD COUNTY COMMISSIONERS NOR THE HEALTH DEPARTMENT IS RESPONSIBLE FOR THE SUCCESSFUL OPERATION OF ANY SYSTEM.

AD 517

