




①  
 bronze  
 el  
 3/2-4  
 bronze  
 10%  
 frags

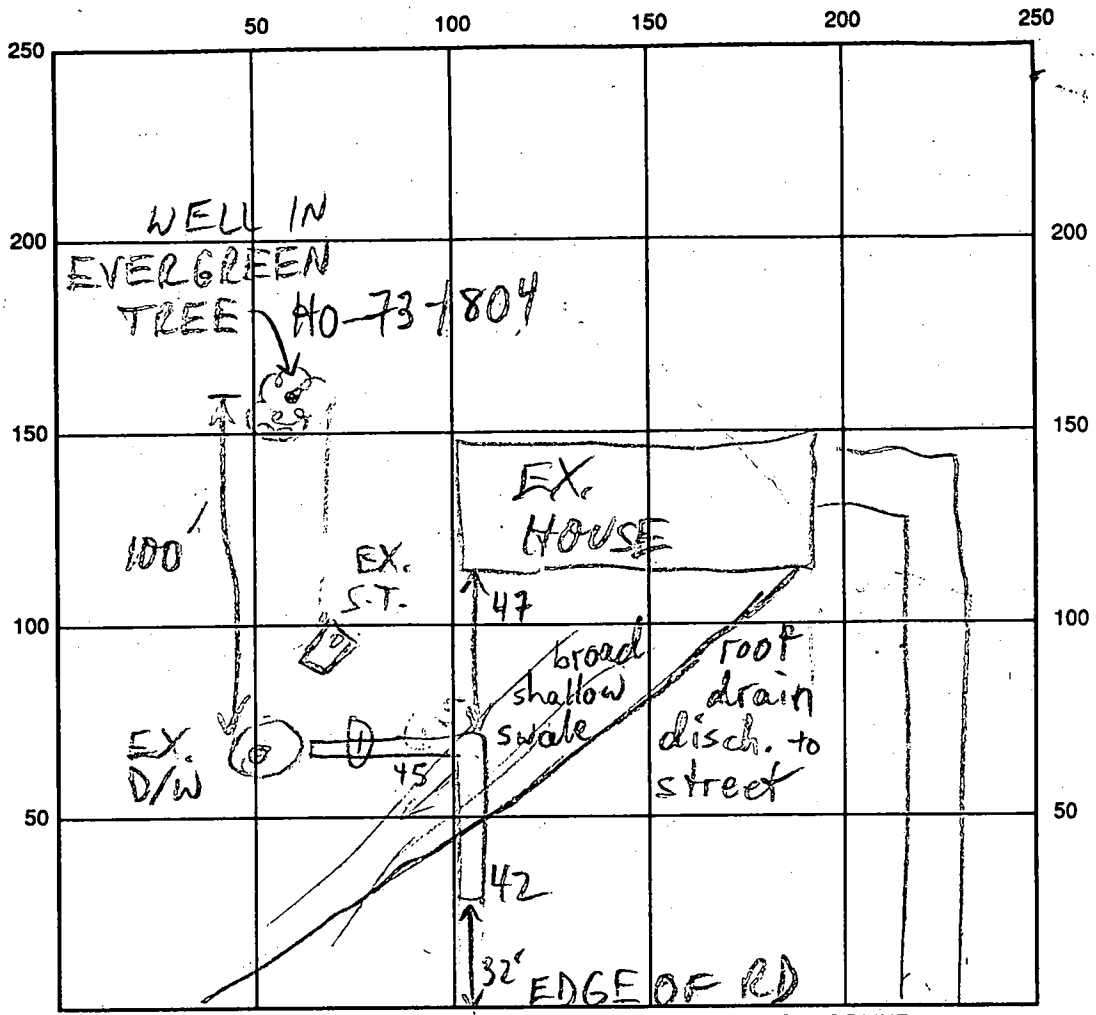

ETCHISON RD INDICATE NORTH - NAME ADJOINING ROADWAY AS BASE LINE

SEPTIC TANK LEVEL EX. 1250 OK CLEANOUTS EX-OK

DISTRIBUTION BOX LEVEL                     

DRAIN FIELD/TITLE DEPTH 9 FT. TRENCH WIDTH 2 FT. INLET DEPTH 3 FT.

EFFECTIVE GRAVEL DEPTH 6 FT. TOTAL LENGTH 87 FT.

NUMBER OF TRENCHES 1 ONE SIDEWALL/BOTTOM AREA 522 SQ. FT.

DRYWALL INSIDE DIAMETER                      FT. EFFECTIVE DEPTH BELOW INLET                      FT.

ABSORBENT AREA 522 SQ. FT.

REMARKS: 4/4/97 #1 OK TO START MR  
4/4/97 #2 OK TO COVER MR

DATE SYSTEM APPROVED 4/4/97 INSPECTOR M. Ritkin

8/24/77

SEWAGE DISPOSAL SYSTEM

MARYLAND STATE DEPARTMENT OF HEALTH

HOWARD COUNTY

ELLCOTT CITY

DISTRICT 24

DATE 8/24/77

INDEXED

Joseph E. Widmayer

IS PERMITTED TO INSTALL & ALTER

ADDRESS 102 Calder Street, Under Marlboro, Md. 20670 PHONE 336-4402

A SEWAGE DISPOSAL SYSTEM LOCATED AT

SUBDIVISION Woodmark ROAD 12207 Station Road LOT 29, Blk. E, Sec. 11

PROPERTY OWNER Joseph E. Widmayer

ADDRESS SAME AS ABOVE

SPECIFICATIONS 4 bedrooms

DRAIN FIELD DEPTH FEET, BOTTOM AREA SQ. FT.

SEEPAGE PITS ABSORBENT SIDE-WALL AREA SQ. FT.

SEPTIC TANK CAPACITY 1250 GALLONS

FOR GARbage GRINDER, INCREASE DISPOSAL AREA AND TANK CAPACITY 50%.

OTHER DRY WELL - 480 sq. ft. sidewall area below top 2 ft. of well. Maximum depth permitted for dry well is 12 ft. below original grade at time of work. Place the dry well 80 ft. from the front lot line and 20 ft. from the left side of the lot as seen when facing the lot from Station Road. Lot is also suitable for deep ditch. Call Sanitarian if ditch is desired.

NOTE: ALL PIPE FROM HOUSE TO DISPOSAL AREA MUST BE CAST IRON. PERMIT VOID AFTER THREE YEARS.

NOTE: INSTALL STAND PIPE ON SEPTIC TANK AND DRY WELL. STAND PIPE MUST BE 4 INCHES IN DIAMETER. CAST IRON, CONCRETE OR TERRAZO ACCEPTED.


PLANS APPROVED BY Raymond Hodges DATE 8/3/78

FILL SEPTIC TANK AND DISTRIBUTION BOX WITH WATER BEFORE CALLING FOR AN INSPECTION. COVER NO WORK UNTIL INSPECTED AND APPROVED.

NEITHER THE HOWARD COUNTY COMMISSIONERS NOR THE HEALTH DEPARTMENT IS RESPONSIBLE FOR THE SUCCESSFUL OPERATION OF ANY SYSTEM.

BLDG. PERMIT SIGNED AND RETURNED 8/10/78 Serial # 4632

18929

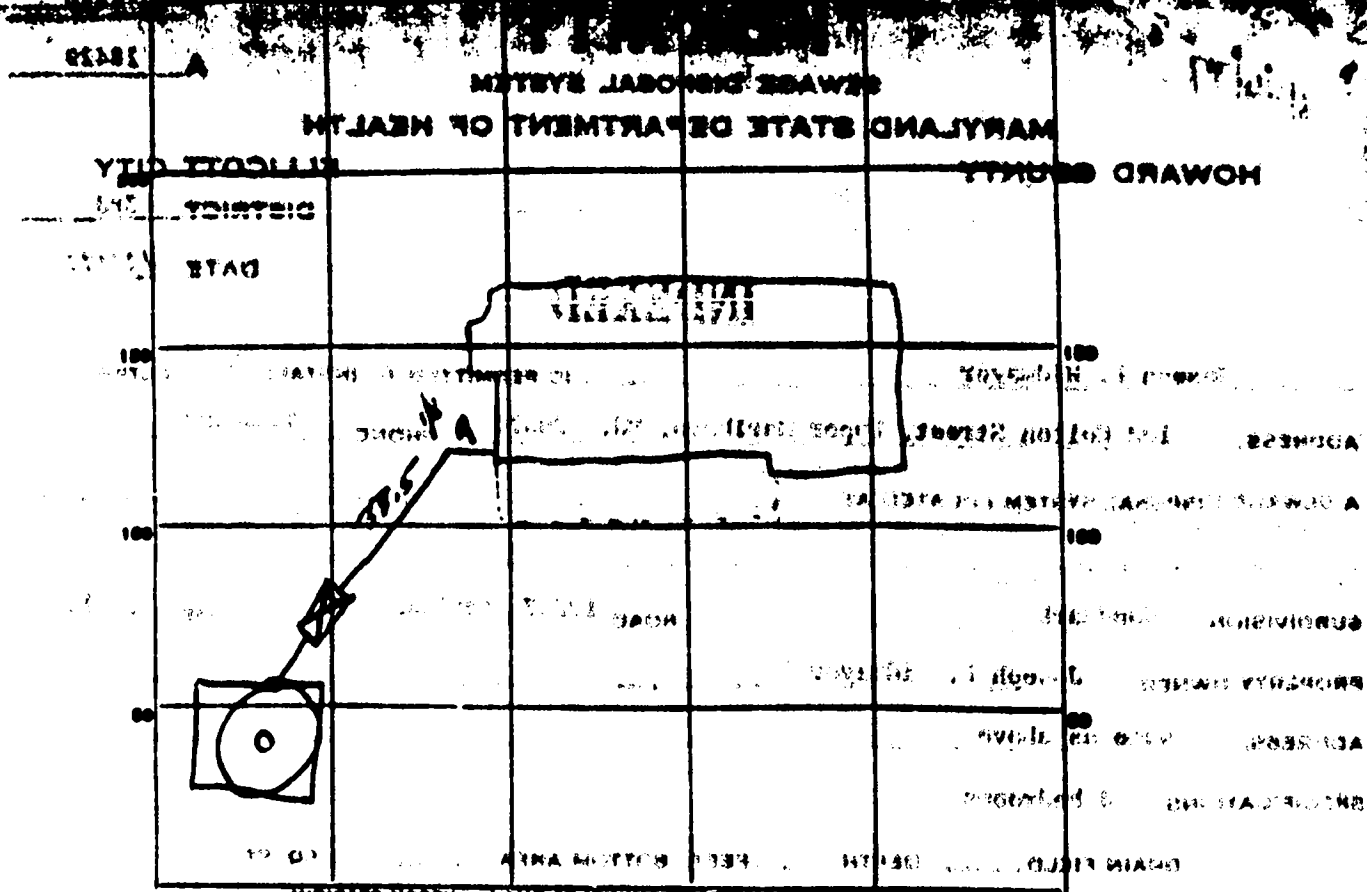

PERMIT CARD    
 SEPTIC TANK, LEVEL  CLEANOUTS DW ST   
 DISTRIBUTION BOX, LEVEL N/A   
 TILE FIELD, DEPTH N/A FT. TRENCH WIDTH N/A FT.   
 GRAVEL DEPTH N/A IN. TOTAL LENGTH N/A FT.   
 NUMBER OF TRENCHES N/A TOTAL BOTTOM AREA N/A   
 SEEPAGE PITS, INSIDE DIAMETER 52 FT. DEPTH BELOW INLET 10 FT.   
 ABSORBENT AREA 520 SQ. FT.

REMARKS \_\_\_\_\_

\_\_\_\_\_

\_\_\_\_\_

\_\_\_\_\_

\_\_\_\_\_

DATE SYSTEM APPROVED 26 Aug 77 INSPECTOR Richard R. [Signature]



IDENTIFY THE MEASUREMENTS AND ELEVATIONS SHOWN ARE ACTUAL AND CORRECT FOR THIS PROPERTY.

SIGNED Joseph E. Widmayer  
 DATE 2-14-77

Lot 29, Blk. E, Etchison Rd. S.W.S.  
 Woodmark, Mo. 6411  
 Ellicott City

142'

100'

115'

290'

40'

EXISTING WATER WELL EXIST. ELEV 380'

FF 380'  
 BASE 371'

INV. ELEV. 373.50

480' SIDE WALL

INV. ELEV. 374.70

INV. ELEV. 379.20

2.50 GULLY TANK

20' WELL

ELEV. AT PERC. TEST

375.25  
 373.50

80'

400' 8 333 49 70

