

Repaired pipe

APPLICATION

15606

A _____
P _____

SEWAGE DISPOSAL TESTING

MARYLAND STATE DEPARTMENT OF HEALTH

HOWARD COUNTY

ELLICOTT CITY

Septic Tank 1500 gal.

DISTRICT 2

Deep trench - 50 ~~ft~~ ft. long - 4ft deep -
minimum 5ft gravel under pipe - located in rear of house

DATE 10/28/70

TO: THE COUNTY HEALTH OFFICER
ELLICOTT CITY, MARYLAND

I, HEREBY, APPLY FOR THE NECESSARY TESTS IN ORDER TO CONSTRUCT (OR RECONSTRUCT) A SEWAGE DISPOSAL SYSTEM.

PROPERTY OWNER Clarence Cook

ADDRESS 3949 Cook's Lane, E.C.

PHONE 465-6659

PROPERTY LOCATION:

SUBDIVISION _____

LOT NO. _____

ROAD AND DESCRIPTION 3949 Cook's Lane

OCCUPANT _____

PHONE _____

PERSON TO CONSTRUCT SYSTEM _____

ADDRESS _____

PHONE _____

SIZE OF LOT ?

TYPE BLDG. Existing house
single 1/2 family
NUMBER OF BEDROOMS

IF NOT SINGLE RESIDENCE DESCRIBE _____

SIGNATURE OF APPLICANT Jack Fryck

APPROVED BY DW. Marzetta

FOR Deep Trench
(KIND OF SYSTEM)

DATE 11-10-70

REJECTED BY _____

FOR _____
(KIND OF SYSTEM)

DATE _____

HOLD PENDING FURTHER TESTS _____

DATE _____


REASONS FOR REJECTION OR HOLDING _____

DIRIGIT DESPUS JICQ

NO 021811

THIS IS NOT A PERMIT

19/12/2

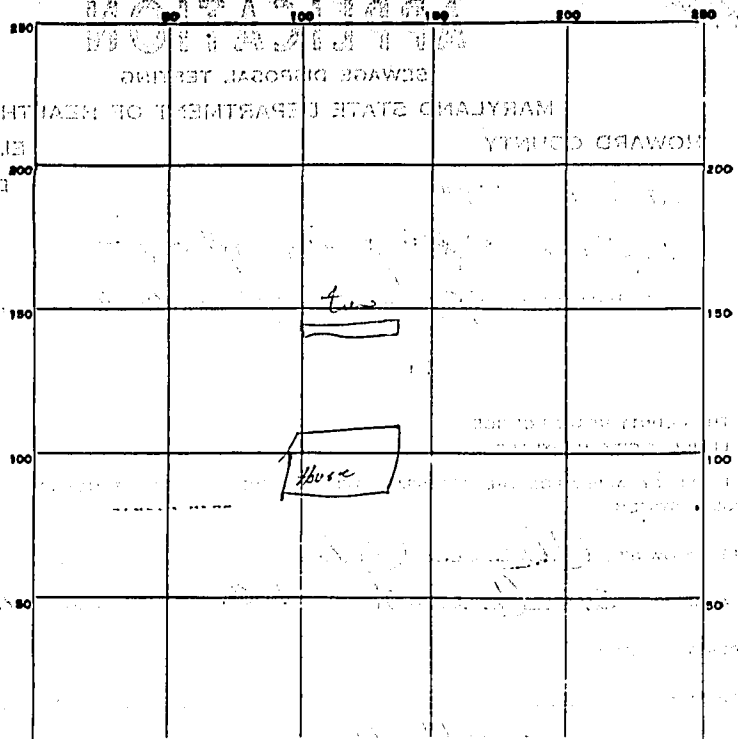

INDICATE NORTH - NAME ADJOINING ROADWAY AS BASE LINE.

DATE	TEST NO.	DEPTH	PRE-WET		TEST - 1" DROP		TIME
			START	STOP	START	STOP	
19/12/2	1	9ft	sand - rather rock - some mica - 3ft				

SOIL AUGER FINDING _____

TESTED BY AW

REMARKS _____

THOMAS A. PORTER & SONS