

# APPLICATION

SEWAGE DISPOSAL TESTING

A 03558

P 03558

MARYLAND STATE DEPARTMENT OF HEALTH

HOWARD COUNTY

ELLICOTT CITY

*See Mr. Hennigan before any permit is issued.*

DISTRICT 225 ft long  
DATE 4-11-61

*Sanitary bed located 20 ft. from side wall and 58 ft. behind rear wall of house. This will place the bed on that side of the lot which is closest to College Ave. 1000 gal. styri Tank.*

TO: THE COUNTY HEALTH OFFICER  
ELLICOTT CITY, MARYLAND

I, HEREBY, APPLY FOR THE NECESSARY TESTS IN ORDER TO CONSTRUCT (OR RECONSTRUCT) A SEWAGE DISPOSAL SYSTEM.

PROPERTY OWNER Taylor Manor Hospital

ADDRESS Ellicott City PHONE Ho. 5-3322

PROPERTY LOCATION:

SUBDIVISION \_\_\_\_\_ LOT NO. \_\_\_\_\_

ROAD AND DESCRIPTION College Avenue -

OCCUPANT \_\_\_\_\_ PHONE \_\_\_\_\_

PERSON TO CONSTRUCT SYSTEM \_\_\_\_\_

ADDRESS \_\_\_\_\_ PHONE \_\_\_\_\_

SIZE OF LOT \_\_\_\_\_ TYPE BLDG. 4 - 2 apt.  
NUMBER OF BEDROOMS

IF NOT SINGLE RESIDENCE DESCRIBE \_\_\_\_\_

SIGNATURE OF APPLICANT *James Scott*


APPROVED BY *J. Hennigan* FOR *Sanitary Bed* DATE 4-12-61  
(KIND OF SYSTEM)

REJECTED BY \_\_\_\_\_ FOR \_\_\_\_\_ DATE \_\_\_\_\_  
(KIND OF SYSTEM)

HOLD PENDING FURTHER TESTS \_\_\_\_\_ DATE \_\_\_\_\_

REASONS FOR REJECTION OR HOLDING \_\_\_\_\_

# THIS IS NOT A PERMIT

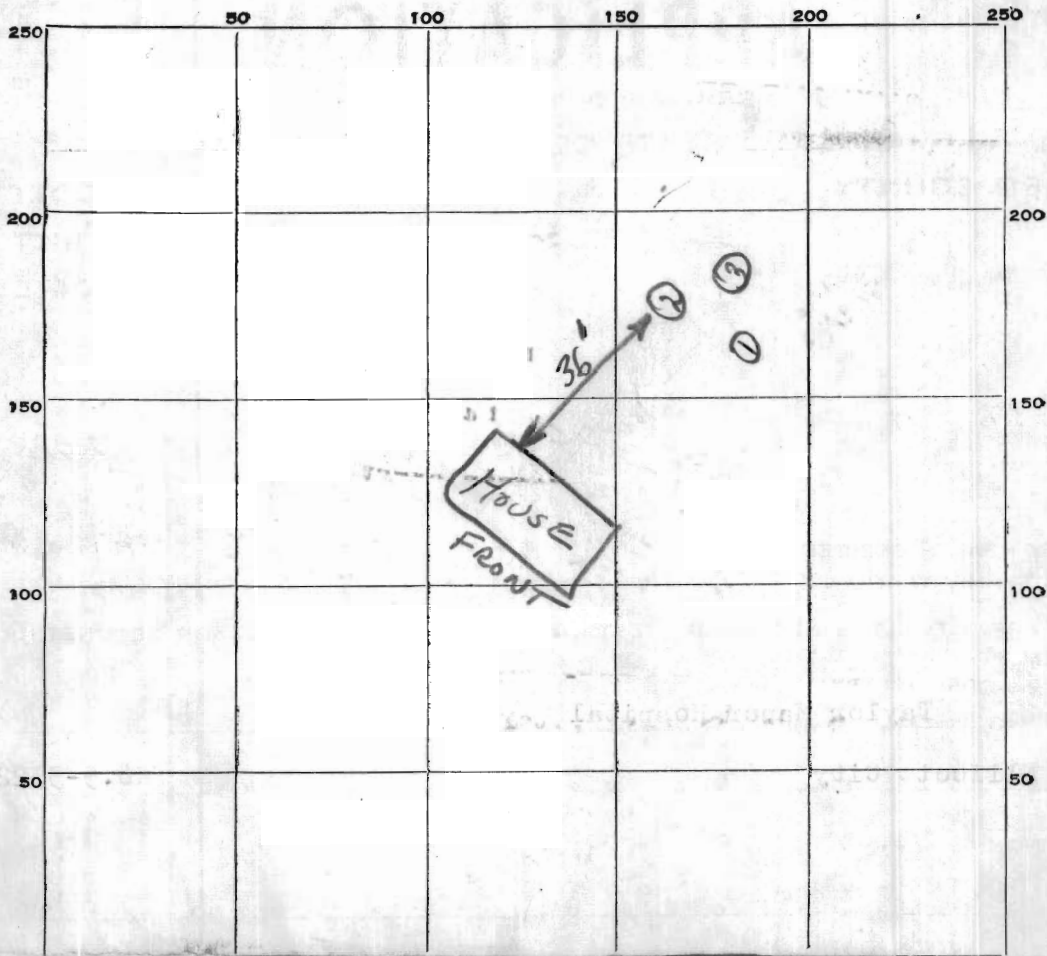

INDICATE NORTH. - NAME ADJOINING ROADWAY AS BASE LINE.

TAYLOR MANOR DRIVE

DATE	TEST NO.	DEPTH	PRE-WET		TEST - 1" DROP		TIME
			START	STOP	START	STOP	
4-12-61	1	6 FT	11:23	11:24	11:24	11:26	2 Minutes
1	2	1	11:25	11:32	11:32	11:44	12 Minutes
1	3	1	11:29	11:33	11:35	11:43	8 Minutes

SOIL AUGER FINDING \_\_\_\_\_

TESTED BY J. Hennigan

REMARKS Leaching Bed.

ALSO PRESENT 4-12-61 Robert Coffey

LOT NO. \_\_\_\_\_

7/21/61  
9:30

04026

# APPLICATION

A ~~03558~~  
P 03558

SEWAGE DISPOSAL TESTING

MARYLAND STATE DEPARTMENT OF HEALTH

HOWARD COUNTY

RETEST

ELLICOTT CITY

DISTRICT \_\_\_\_\_

Percolation Test aren't approved on the Retest

DATE 7-20-61

Septic system will be installed according to specification on the original application.

*7-21-61 Met Mr. E.H. Reider at building site, who agreed to put system in according to original specs + test run on 4-12-61. No retest run. JH.*

TO: THE COUNTY HEALTH OFFICER  
ELLICOTT CITY, MARYLAND

I, HEREBY, APPLY FOR THE NECESSARY TESTS IN ORDER TO CONSTRUCT (OR RECONSTRUCT) A SEWAGE DISPOSAL SYSTEM.

PROPERTY OWNER Taylor Manor Hospital

ADDRESS Ellicott City PHONE Ho 5-3322

PROPERTY LOCATION:

SUBDIVISION \_\_\_\_\_ LOT NO. \_\_\_\_\_

ROAD AND DESCRIPTION College Avenue

OCCUPANT \_\_\_\_\_ PHONE \_\_\_\_\_

PERSON TO CONSTRUCT SYSTEM \_\_\_\_\_

ADDRESS \_\_\_\_\_ PHONE \_\_\_\_\_

SIZE OF LOT \_\_\_\_\_ TYPE BLDG. 4 2 apts.  
NUMBER OF BEDROOMS

IF NOT SINGLE RESIDENCE DESCRIBE \_\_\_\_\_

SIGNATURE OF APPLICANT \_\_\_\_\_

APPROVED BY \_\_\_\_\_ FOR \_\_\_\_\_ DATE \_\_\_\_\_  
(KIND OF SYSTEM)

REJECTED BY \_\_\_\_\_ FOR \_\_\_\_\_ DATE \_\_\_\_\_  
(KIND OF SYSTEM)

HOLD PENDING FURTHER TESTS \_\_\_\_\_ DATE \_\_\_\_\_

REASONS FOR REJECTION OR HOLDING \_\_\_\_\_

# THIS IS NOT A PERMIT