

9/17/97 ASDP  
Fine @ 2:44

# PERMIT

## SEWAGE DISPOSAL SYSTEM

### DEPARTMENT OF HEALTH AND MENTAL HYGIENE

04-326490

P 58990-D

A REPAIR

DISTRICT \_\_\_\_\_

DATE 9-24-97

HOWARD COUNTY HEALTH DEPARTMENT

BUREAU OF ENVIRONMENTAL HEALTH

XXXXXXXX 410-313-2640

DATE SYSTEM APPROVED 9/24/97

INSPECTOR *[Signature]*

INDEXED

Jack Fyock Septic Services IS PERMITTED TO INSTALL ALTER

ADDRESS 13775 Triadelphia Road, Glenelg, Maryland 21737 PHONE 410-988-9270

SUBDIVISION \_\_\_\_\_ LOT \_\_\_\_\_ ROAD 13890 Forsythe Road

PROPERTY OWNER Steve Boesche

ADDRESS \_\_\_\_\_

SEPTIC TANK CAPACITY <sup>existing</sup> 1250 GALLONS

NUMBER OF BEDROOMS size for 4 (wood floor, carpet, only 4 rooms & residents)  
180 SQUARE FEET PER BEDROOM *(but verbal history per contractor not occupied 10 occupants)*

LINEAR FEET OF TRENCH REQUIRED 100

REPAIR - PURPOSE - SEPTIC SYSTEM HAS FAILED.  
Call for inspection when ground is opened so sanitarian can recommend repair.  
09/16/97

*This is a 2nd repair in 10 yrs; as previous system was too small, too much sewage generated  
and system repair tank (repaired in 12/87) failed in less than 10 years. I recommend disconnection from  
old dry well. Install 100ft long Trench, inlet at 2 1/2 ft, bottom @ 8 1/2 ft, 6 ft slope fill, 2 ft wide.*

PLANS APPROVED BY \_\_\_\_\_ DATE \_\_\_\_\_

COVER NO WORK UNTIL INSPECTED AND APPROVED

NEITHER THE HOWARD COUNTY COUNCIL NOR THE HEALTH DEPARTMENT IS RESPONSIBLE FOR THE SUCCESSFUL OPERATION OF ANY SYSTEM

NOTE: CLEANOUT REQUIRED EVERY 70 FEET OF SEWER LINE AND/OR AT 90° SWEEPS IN LINES FROM HOUSE TO DRAIN FIELDS, 90° ELBOWS NOT ACCEPTABLE.

NOTE: ALL PARTS OF SEPTIC SYSTEMS (I.E. TANK, DISTRIBUTION BOX TRENCHES) TO BE 100 FEET FROM WELL (UNLESS OTHERWISE SPECIFICALLY AUTHORIZED)

NOTE: IF DEEP TRENCH(ES) ARE USED CALL FOR INSPECTION BEFORE AND AFTER PLACING GRAVEL IN TRENCH(ES)

NOTE: NO DRY WELL SHALL EXCEED 15 FOOT IN DIAMETER NO ABSORPTION TRENCH TO EXCEED 100 FEET IN LENGTH

NOTE: ALL PIPE FROM HOUSE TO SEPTIC TANK MUST BE CAST IRON OR SCHEDULE 35/40 PVC OR ABS


PERMIT VOID AFTER TWO YEARS

NOTE: INSTALL STAND PIPE ON SEPTIC TANK AND DRY WELL STAND PIPES MUST BE 6 INCHES IN DIAMETER CAST IRON, CONCRETE OR TERRA COTTA OR PVA OR ABS ACCEPTED. IF TOP OF SEPTIC TANK IS DEEPER THAN 3 FEET, MANHOLE TO GRADE REQUIRED.

NOTE: DISTRIBUTION BOXES MUST HAVE BAFFLES

**\*INSTALLER IS RESPONSIBLE FOR OBTAINING FINAL APPROVAL ON THIS PERMIT**

58990-D

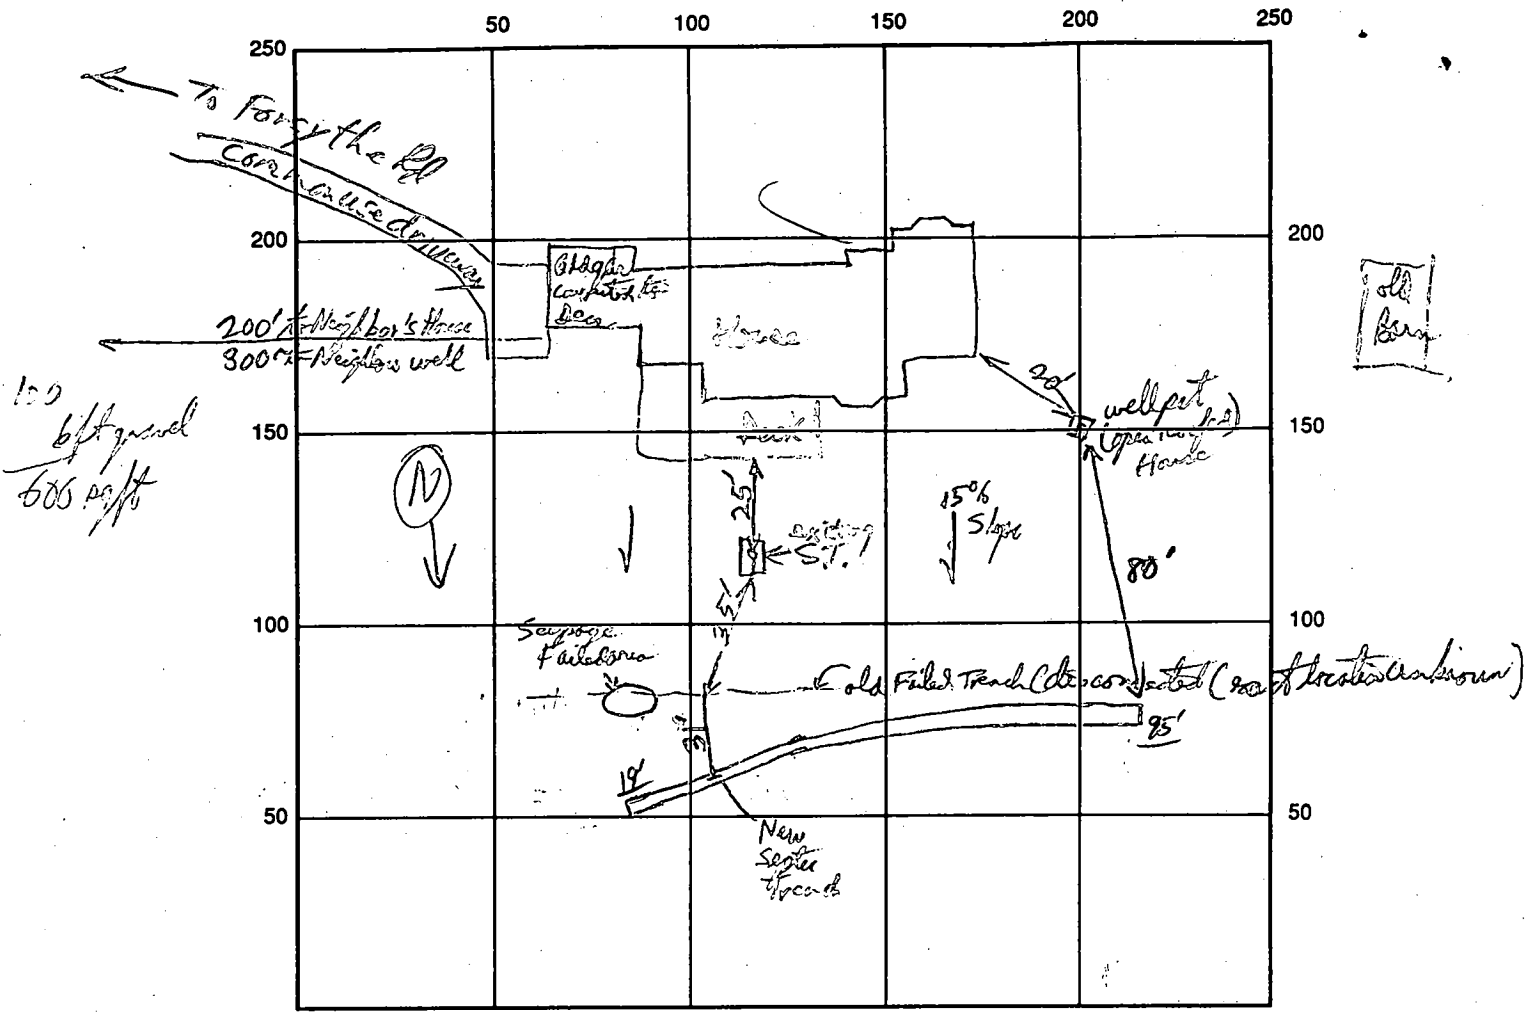

INDICATE NORTH - NAME ADJOINING ROADWAY AS BASE LINE

SEPTIC TANK LEVEL existing 1250 (contractor) CLEANOUTS old ST. only

DISTRIBUTION BOX LEVEL NA (disconnected from old filled trench)

DRAIN FIELD/TITLE DEPTH 8 1/2 FT. TRENCH WIDTH 2 FT. INLET DEPTH 2 1/2 FT.

EFFECTIVE GRAVEL DEPTH 6 FT. TOTAL LENGTH 114 FT.

NUMBER OF TRENCHES 1 ONE SIDEWALL/BOTTOM AREA 684' SQ. FT.

DRYWALL INSIDE DIAMETER    FT. EFFECTIVE DEPTH BELOW INLET    FT.

ABSORBENT AREA    SQ. FT.

REMARKS: I recommend + owner covered better to place full 100' of trench in at this time.  
OK to begin gravel filling but trench (only has 50' in at this time) can be disconnected from old filled trench  
which is draining below sewer down slope. are. PJP 9/17/97 Trench OK to cover PJP 9/17/97  
extra trench is to be covered per contractor.

DATE SYSTEM APPROVED 9/17/97 INSPECTOR PJP

# APPLICATION

1/18/87 9:30

PERCOLATION TESTING

A 40632

P \_\_\_\_\_

HOWARD COUNTY HEALTH DEPARTMENT  
BUREAU OF ENVIRONMENTAL HEALTH  
P.O. BOX 476 ELLICOTT CITY, MARYLAND 21043  
TELEPHONE 461-9933

DISTRICT \_\_\_\_\_

DATE 12/10/87

\$10 REPAIR FEE REQ'D

EXISTING HOUSE  
RECENT (1986) REPAIR

CW

TO: THE COUNTY HEALTH OFFICER  
ELLICOTT CITY, MARYLAND

I, HEREBY, APPLY FOR THE NECESSARY TEST IN ORDER TO CONSTRUCT (OR RECONSTRUCT) A SEWAGE DISPOSAL SYSTEM.

PROPERTY OWNER ~~B. ROME~~ RICKEN

ADDRESS 13890 FORSYTHE RD PHONE \_\_\_\_\_

PROSPECTIVE BUYER B. ROME

ADDRESS BOX 553 EC PHONE 465-1869

PROPERTY LOCATION:

SUBDIVISION RICKEN PROPERTY LOT NO NEW LOT 3

ROAD AND DESCRIPTION FORSYTHE RD

TAX MAP 9 PARCEL # 63

SIZE OF LOT \_\_\_\_\_ TYPE BLDG RES.  
(SINGLE FAMILY DWELLING OR COMMERCIAL)

THE SYSTEM INSTALLED UNDER THIS APPLICATION IS ACCEPTABLE ONLY UNTIL PUBLIC FACILITIES BECOME AVAILABLE. I FULLY UNDERSTAND THE FEE CONNECTED WITH THE FILING OF THIS PERC TEST APPLICATION IS NON-REFUNDABLE UNDER ANY CIRCUMSTANCES. I ALSO AGREE TO COMPLY WITH ALL M.O.S.H.A. REQUIREMENTS IN TESTING THIS LOT.

Bernard M. Ryan  
(SIGNATURE OF APPLICANT)

APPROVED BY \_\_\_\_\_ FOR \_\_\_\_\_ DATE \_\_\_\_\_

REJECTED BY \_\_\_\_\_ FOR \_\_\_\_\_ DATE \_\_\_\_\_


HOLD PENDING FURTHER TESTS \_\_\_\_\_ DATE \_\_\_\_\_

REASONS FOR REJECTION OR HOLDING 1/18/87 - EXISTING HOUSE OK

HOLD FOR PLAT RD

HD-216

# THIS IS NOT A PERMIT

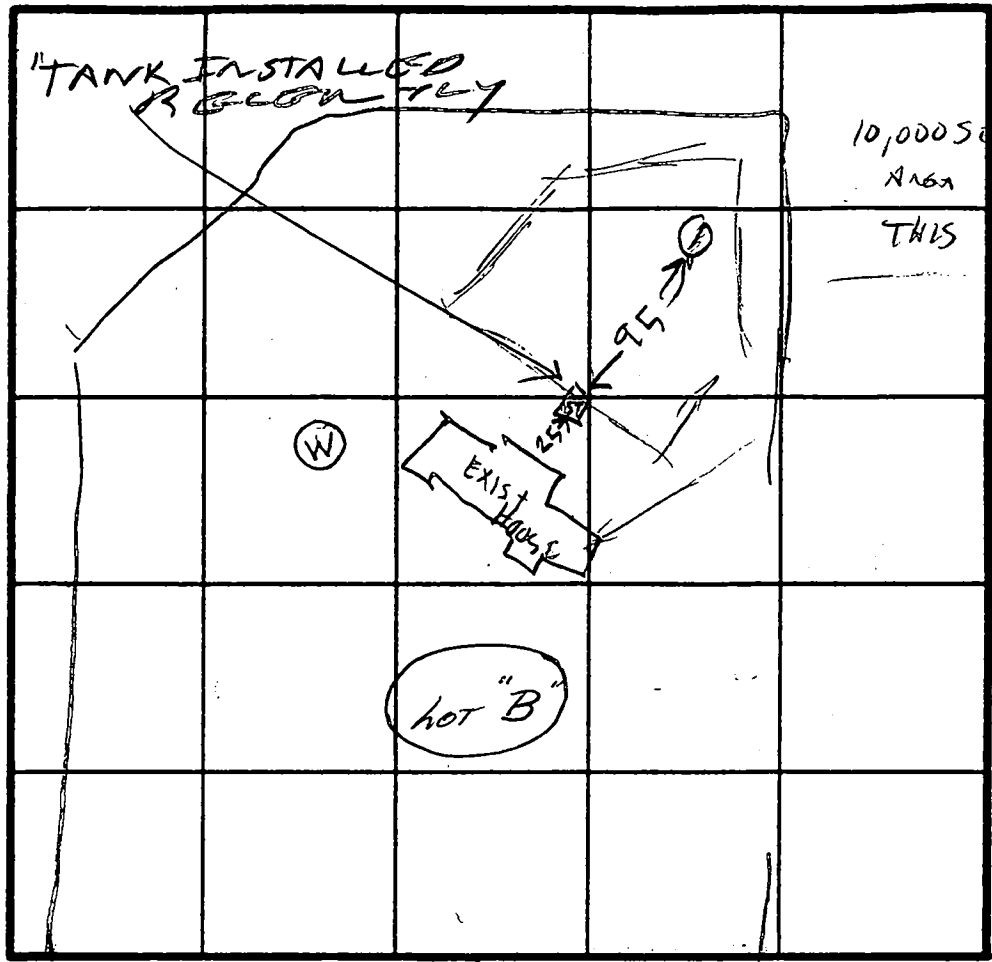

10,000 SQ FT  
AREA IN  
THIS VICINITY.

SOIL PROFILE  
 0  
 3  
 CLAY  
 PINK  
 BROWN  
 SAND  
 LOAM  
 FEW  
 ROCKS  
 12

INDICATE NORTH - NAME ADJOINING ROADWAY AS BASE LINE

DATE	TEST NO.	DEPTH	PRE-WET		TEST - 1" DROP		TIME
			START	STOP	START	STOP	

REMARKS \_\_\_\_\_


TYPE OF SOIL \_\_\_\_\_

TESTED BY B. Rodgers ALSO PRESENT OK STEPHEN B. ROME

LOT # 4  
5.99 Ac.

A\*40630

PROPERTY OF  
RUTH H. YOUNG  
1018 / 107

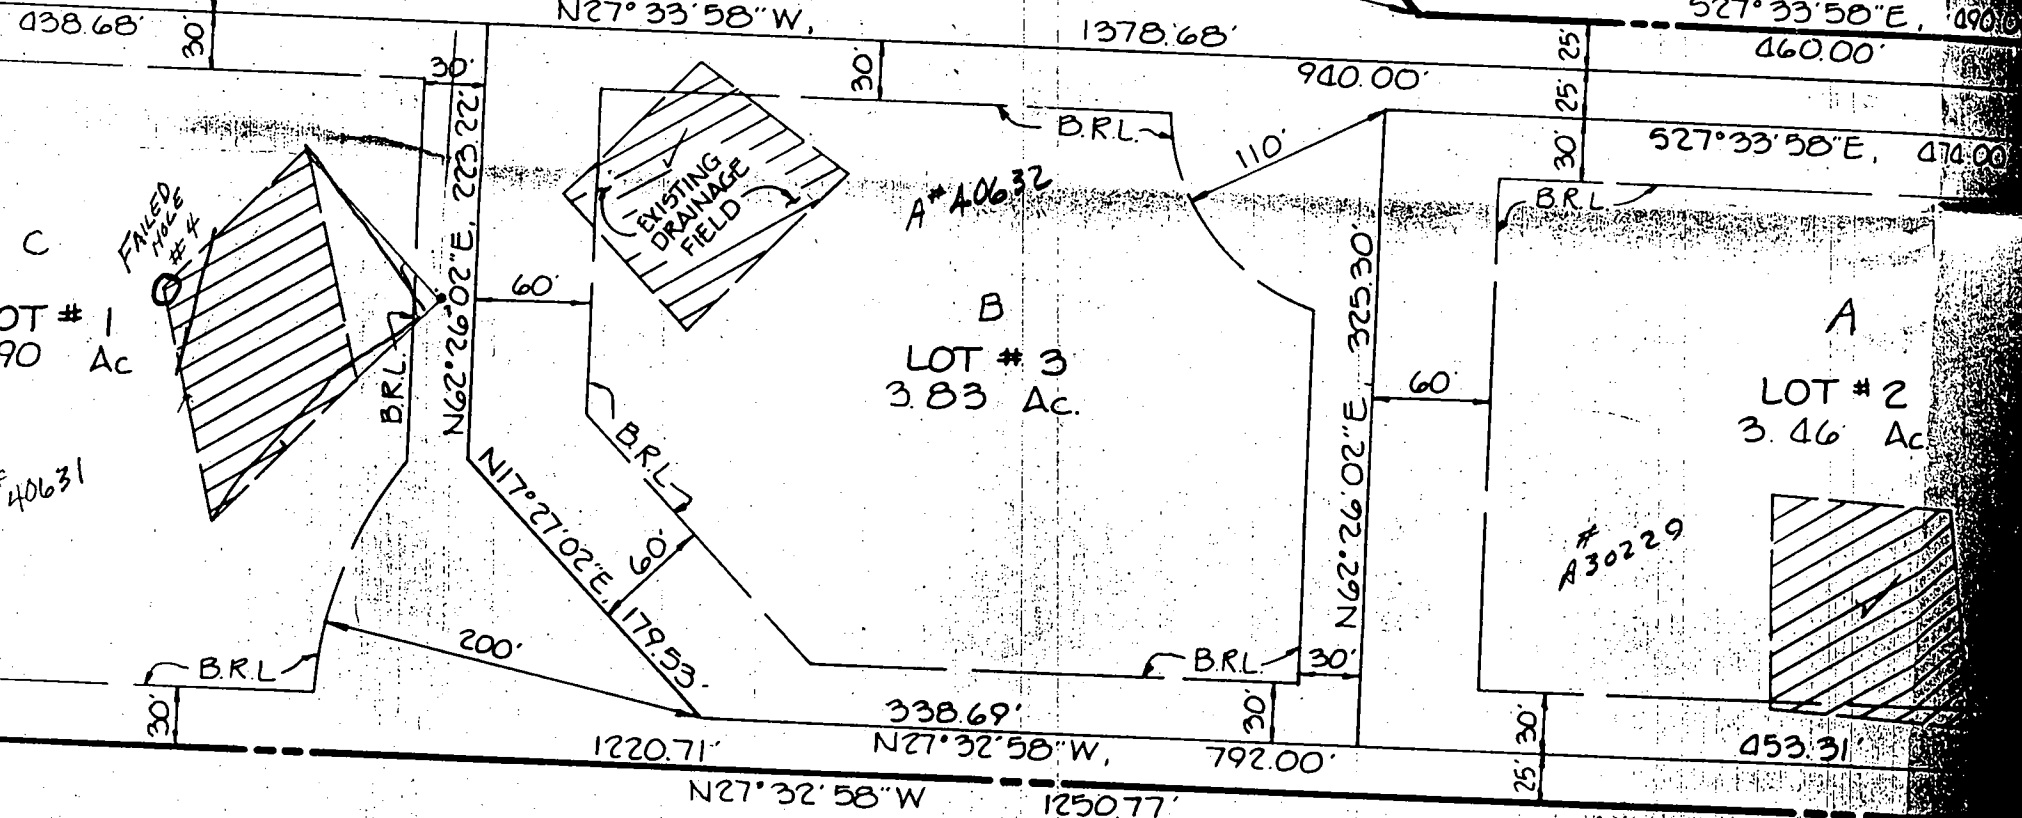

LOT # 1  
90 Ac

LOT # 3  
3.83 Ac

LOT # 2  
3.46 Ac

PROPERTY OF  
A.R. GROSS III  
624 / 671


- .....4
- .....17.195 Ac.
- .....0.276 Ac.
- .....17.472 Ac.

**SURVEYOR'S CERTIFICATE**

I HEREBY CERTIFY THAT THE FINAL PLAT SHOWN HEREON IS  
RECT; THAT IT IS ALL OF THE LAND OBTAINED BY LAWRENCE N.  
ER JR. AND BARBARA J. RICKER, HIS WIFE, FROM LEO J. WILL AND  
T. WILL, HIS WIFE, BY DEED DATED AUGUST 2, 1967 AND

**OWNER'S DEDICATION**

WE, LAWRENCE N. RICKER JR. AND BARBARA J. RICKER, OWNERS OF THE  
HEREON, HEREBY ADOPT THIS PLAN OF SUBDIVISION AND IN CONSIDER  
FINAL PLAT BY THE OFFICE OF PLANNING AND ZONING

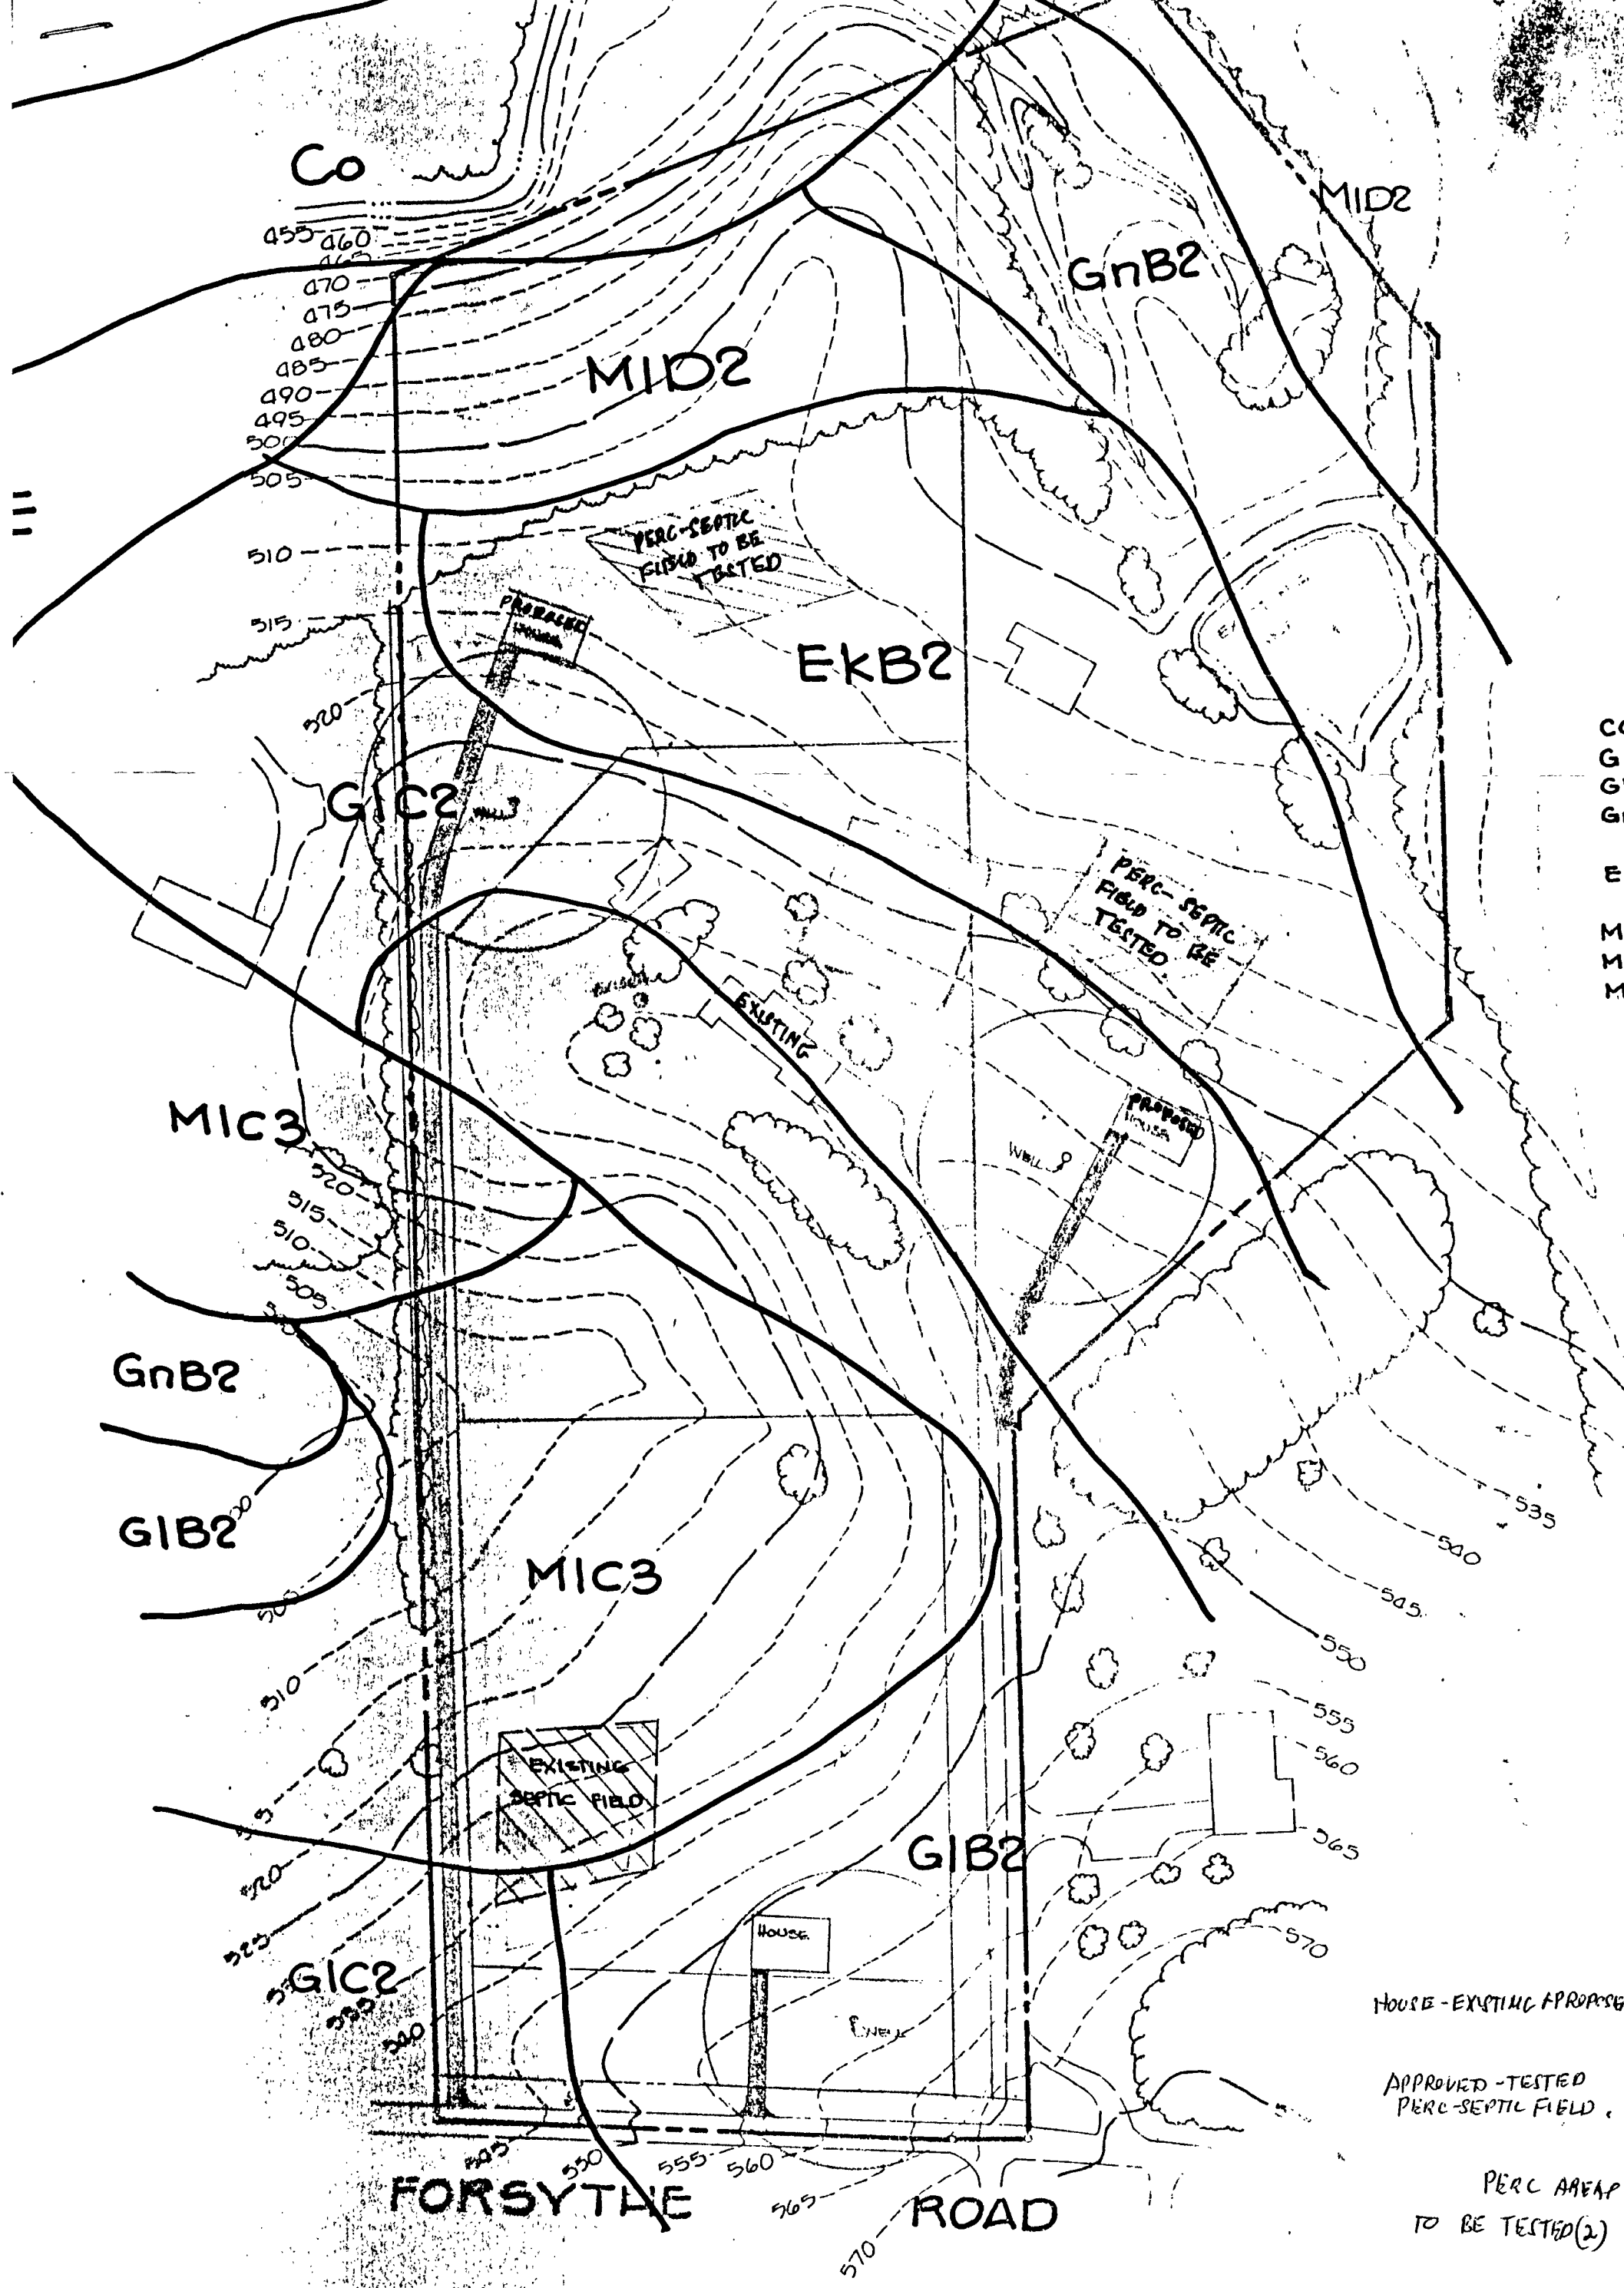

CC  
GG  
GG  
E  
M  
M  
M