

12/21/68
12/21/68
SEWAGE DISPOSAL SYSTEM
MARYLAND STATE DEPARTMENT OF HEALTH
HOWARD COUNTY

A. 19814

INDEXED

ELLICOTT CITY
DISTRICT 1

file

279803

DATE 11/27/68

Robert Rubin Co. IS PERMITTED TO INSTALL ALTER
ADDRESS Rt. 2, Clarksville, Md. PHONE 286-2829

A SEWAGE DISPOSAL SYSTEM LOCATED AT

SUBDIVISION Woodmark, Inc. 12241
ROAD Pointcharill Cr. LOT 17, B1
B2C

PROPERTY OWNER Mark J. Mahoffis, Inc. Kenneth R. & Wilma Berger

ADDRESS

SPECIFICATIONS - 3 bedrooms

DRAIN FIELD DEPTH FEET, BOTTOM AREA SQ. FT.

SEEPAGE PITS ABSORBENT SIDE-WALL AREA SQ. FT.

SEPTIC TANK CAPACITY 750 GALLONS

FOR GARBAGE GRINDER, INCREASE DISPOSAL AREA 25% & TANK CAPACITY 50%.

OTHER Dry wall - 146 sq. ft. absorbent sidewall area per bedroom. 1/2" dia. hole
pipe. Max. depth permitted for dry wall below original grade is 12 ft. Manhole
well 40 ft. from front lot line and 103 ft. from left side line as shown on plan
lot from Pointcharill Court.

NOTE: ALL PIPES FROM HOUSE TO SEPTIC TANK MUST BE CAST IRON.
PERMIT VOID AFTER FIVE YEARS.

PLANS APPROVED BY D. W. Monaghan DATE 11/12/68


FILL SEPTIC TANK AND DISTRIBUTION BOX WITH WATER BEFORE CALLING FOR AN INSPECTION. COVER NOT
UNTIL INSPECTED AND APPROVED.

NEITHER THE HOWARD COUNTY COMMISSIONERS NOR THE HEALTH DEPARTMENT IS RESPONSIBLE FOR
SUCCESSFUL OPERATION OF ANY SYSTEM.

BLDG. PERMIT SIGNED
AND RETURNED 11-30-68
Serial # 330108496
Addition - Bedroom

BLDG. PERMIT SIGNED
AND RETURNED 11/21/68
Serial # 37135
1 Story Addition

579614-13
579614-13

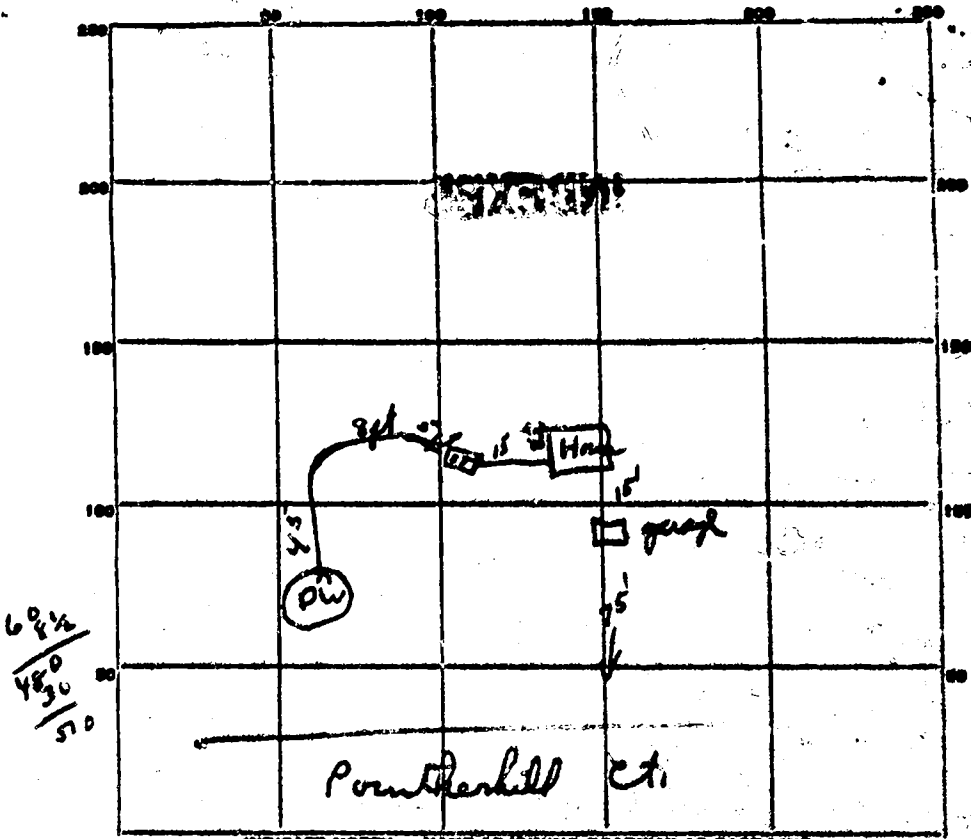

INDICATE NORTH - NAME ADJOINING ROADWAY AS BASE LINE.

PERMIT CARD Squid

SEPTIC TANK, LEVEL 100 gal 02

CLEANOUTS OK

DISTRIBUTION BOX, LEVEL _____

TILE FIELD, DEPTH _____ FT. TRENCH WIDTH _____ FT.

GRAVEL DEPTH _____ IN. TOTAL LENGTH _____ FT.

NUMBER OF TRENCHES _____ TOTAL BOTTOM AREA _____


SEEPAGE PITS, INSIDE PERIMETER outside perimeter 0.5 x 15 FT. DEPTH BELOW INLET 9ft FT.

ABSORBENT AREA 510 SQ. FT.

REMARKS _____

DATE SYSTEM APPROVED 72/24/70

INSPECTOR R.T + 7.7.

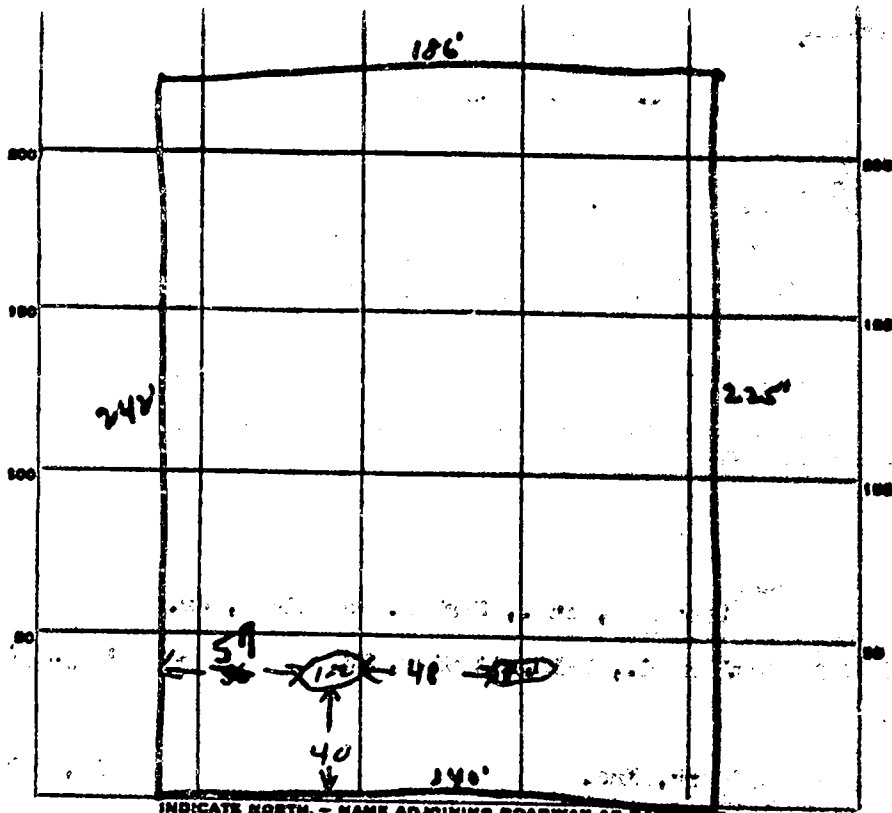

INDICATE NORTH - NAME ADJOINING ROADWAY AS BASE LINE

Court e

DATE	TEST NO.	DEPTH	PRE-WET		TEST - 1" DROP		TIME
			START	STOP	START	STOP	
8/13/67	1	4ft	10 02	10 09	10 09	10 26	12 min
	2	11ft	10 02	10 18	10 18	10 34	14 min
	3	4ft	10 03	10 04	10 04	10 10	6 min
	4	10ft	10 03	10 05	10 05	10 21	15 min

SOIL AUGER FINDING _____

TESTED BY DM _____

REMARKS _____

Lot 17B

DEPARTMENT OF WATER RESOURCES
STATE OFFICE BLDG., ANNAPOLIS, MARYLAND 21401
WELL COMPLETION REPORT

FILL IN THIS FORM COMPLETE

A13014

THIS NUMBER IS TO BE PUNCHED IN COLO. 5-0 ON ALL CARDS

DATE WELL COMPLETED 2-2-77

DEPTH OF WELL 355
(TO NEAREST FOOT)

PERMIT NO. FROM "PERMIT TO DRILL WELL" 70-17-0055

DRILLER'S IDENTIFICATION NO. 122

OWNER Blake, Daniel G. Jr.

STREET OR RFD 432 S. Carolina Ave.

POST OFFICE Parrish

STATE THE KIND OF FORMATIONS PENETRATED, THEIR COLOR, DEPTH, THICKNESS AND IF WATER BEARING

DESCRIPTION (USE APPROPRIATE SHEETS)	FEET		WATER BEARING
	FROM	TO	
Overburden	0	8	
Brown shale	8	28	
Gray rock	28	355	X

GRouting RECORD
WELL HAS BEEN GROUTED (CIRCLE APPROPRIATE BOX)
TYPE OF GROUTING MATERIAL (CIRCLE BOX)
CEMENT M BENTONITE CLAY BC

NO. OF BAGS 3 NO. OF POUNDS 300
GALLONS OF WATER 18
DEPTH OF GROUT SEAL (TO NEAREST FOOT)
FROM 0 FT. TO 30 FT.

CASING RECORD
INSERT APPROPRIATE CODE BELOW
STEEL ST CONCRETE CO
PLASTIC PL OTHER OT
MAIN CASING TYPE S T
DIAMETER (NEAREST INCH) 6
TOTAL DEPTH OF MAIN CASING (NEAREST FOOT) 30

OTHER CASING (IF USED)
DIAMETER (INCH) _____ DEPTH (FEET) FROM _____ TO _____

SCREEN RECORD
INSERT APPROPRIATE CODE BELOW
STEEL ST BRASS OR INCHES BR
PLASTIC PL OTHER OT
C 2

DEPTH (NEAREST WHOLE FOOT)
FROM 30 TO 355

DIAMETER OF SCREEN _____ (NEAREST INCH)
GRAVEL PACK _____
IF WELL DRILLED WAS A FLOWING WELL CIRCLE BOX F

OWNER USE ONLY (NOT TO BE FILLED IN BY DRILLER)
TELESCOPE CASING T LOG INDICATOR L OTHER DATA AVAILABLE O

PUMPING TEST
HOURS PUMPED (TO NEAREST HOUR) _____
PUMPING RATE (GALLONS PER MINUTE TO NEAREST GALLON) 11
METHOD USED TO MEASURE PUMPING RATE air


WATER LEVEL (DISTANCE FROM LAND SURFACE BEFORE PUMPING) 70 INCHES
WHEN PUMPING 345 FEET

TYPE OF PUMPS USED (CIRCLE APPROPRIATE)
AIR A PISTON P
CENTRIFUGAL C ROTARY R
JET J SUBMERSIBLE S

PUMP INSTALLED
TYPE OF PUMP (WRITE APPROPRIATE LETTER OR BOX - SEE ABOVE: A, C, P, R, S, J, B)
DRILLER WILL INSTALL PUMP (CIRCLE APPROPRIATE BOX) YES NO
CAPACITY: _____
GALLONS PER MINUTE (TO NEAREST GALLON) _____
PUMP HORSE POWER _____
PUMP COLUMN LENGTH (NEAREST FOOT) _____

CASING HEIGHT (CIRCLE APPROPRIATE AND ENTER CASING DI)
+ ABOVE } LAND SURFACE
- BELOW } _____ (NEAREST FOOT)

LOCATION OF WELL ON LOT
SHOW PERMANENT STRUCTURE SUCH AS SEPTIC TANKS, AND/OR OTHER LAND MARKS INDICATE NOT LESS THAN TWO DISTANCES (MEASUREMENTS TO WELL)

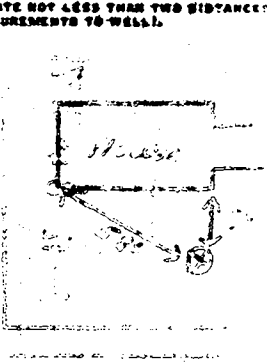

- CIRCLE APPROPRIATE BOXES**
- A A WELL WAS ABANDONED AND SEALED WHEN THIS WELL WAS COMPLETED
 - B ELECTRIC LOG OBTAINED
 - C COPY OF ELECTRIC LOG ATTACHED


I HEREBY CERTIFY THAT I HAVE COMPLIED WITH ALL CONDITIONS STATED ON THE ABOVE-CAPTIONED "PERMIT TO DRILL WELL", AND THAT INFORMATION CONTAINED IN THIS REPORT IS TRUE, ACCURATE, AND COMPLETE TO THE BEST OF MY KNOWLEDGE, INFORMATION AND BELIEF.

DRILLER'S NAME _____

(PLEASE PRINT) Daniel G. Blake, Jr.

SIGNATURE _____

10/29/07 3:00pm
 Site inspection conducted - well and septic locations verified. No sign of septic failure. Spoke to owner - BP is for extension of existing bedroom and bath. OK to proceed. (DKS)

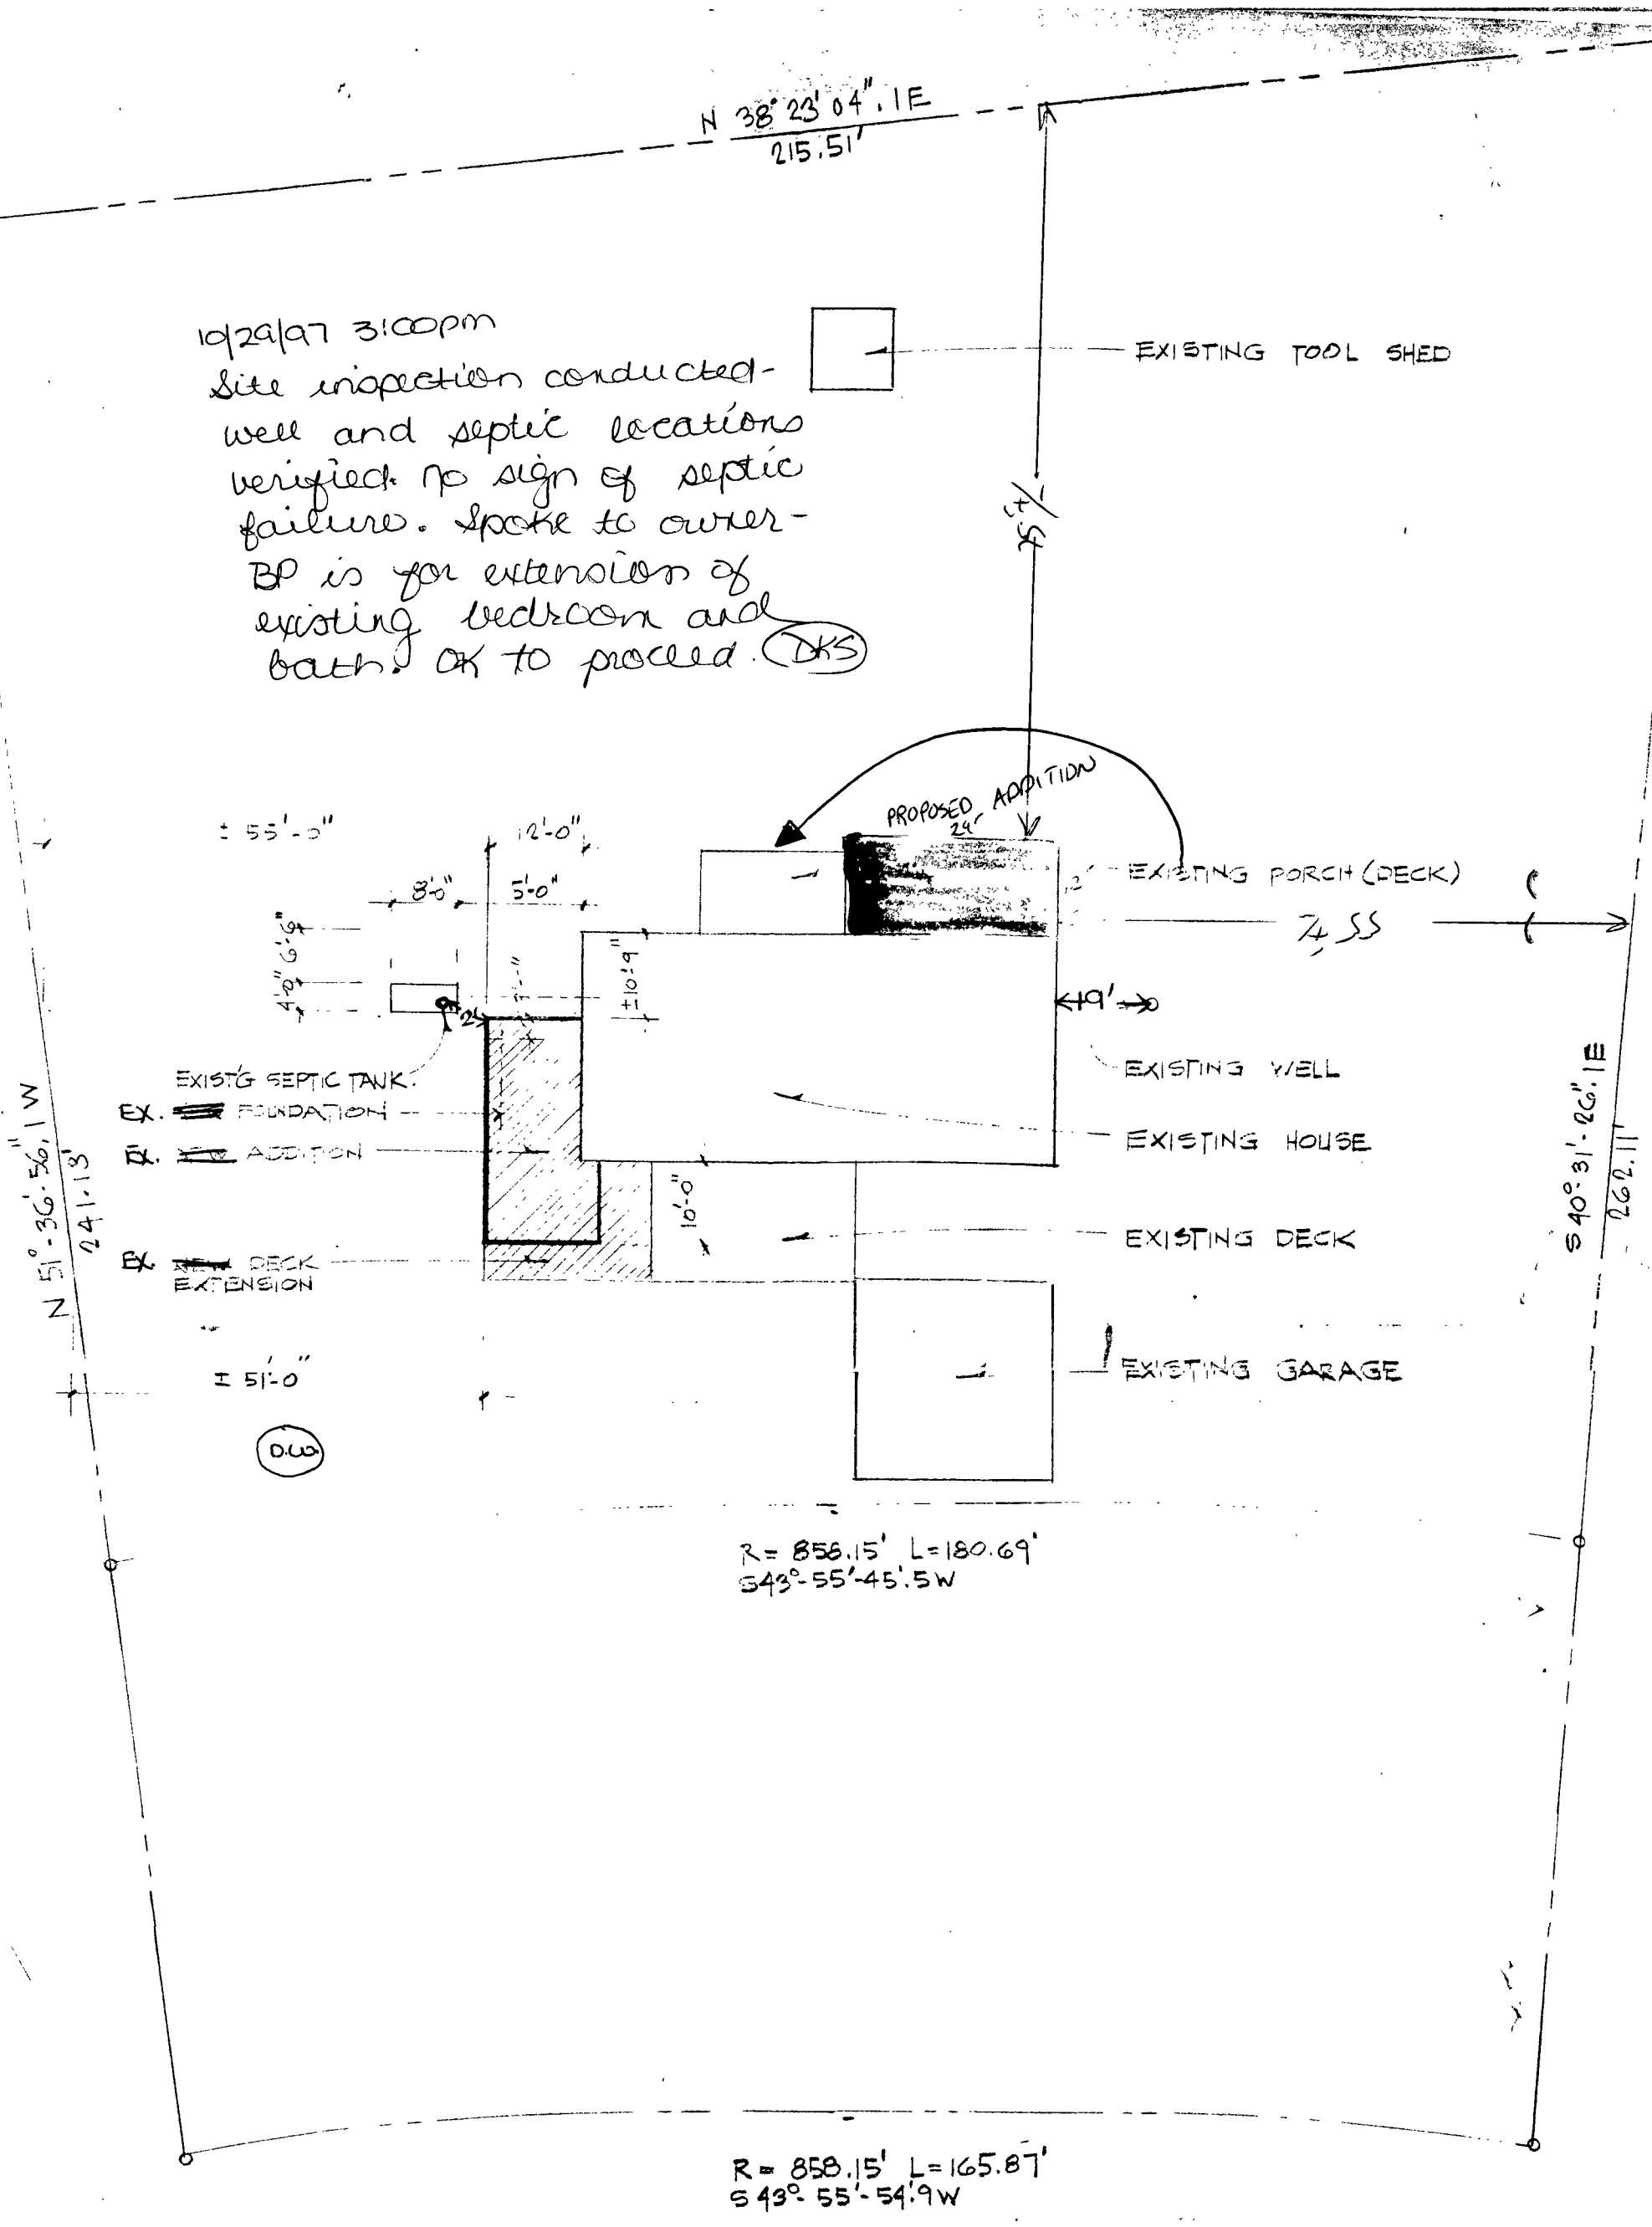

POINTER HILL COURT

SITE PLAN

SCALE $1" = 20'-0''$

