

ck out 7/28/61 - PM

# PERMIT

P 04029

SEWAGE DISPOSAL SYSTEM

A 03558

MARYLAND STATE DEPARTMENT OF HEALTH

HOWARD COUNTY

ELLICOTT CITY

DISTRICT 2

**INDEXED**

DATE 7-24-61

Marlo Disposal System Inc. IS PERMITTED TO INSTALL  ALTER

ADDRESS Post Office 132, White marsh Maryland PHONE Northfield 9-8523

A SEWAGE DISPOSAL-SYSTEM LOCATED AT College Avenue

SUBDIVISION \_\_\_\_\_ ROAD \_\_\_\_\_ LOT \_\_\_\_\_

PROPERTY OWNER Taylor Manor Hospital

ADDRESS Ellicott City

SPECIFICATIONS

DRAIN FIELD \_\_\_\_\_ DEPTH \_\_\_\_\_ FEET, BOTTOM AREA \_\_\_\_\_ SQ. FT.

SEEPAGE PITS \_\_\_\_\_ ABSORBENT SIDE-WALL AREA \_\_\_\_\_ SQ. FT.

SEPTIC TANK CAPACITY 1000 GALLONS

FOR GARBAGE GRINDER, INCREASE DISPOSAL AREA 22% & TANK CAPACITY 50%.


OTHER Leaching bed 20 ft. wide by 25 ft. long located 20 ft. from side wall and 58 ft. behind rear wall of house. This will place the bed on that side of the lot which is closest to College Ave.

PLANS APPROVED BY James E. Hennigan DATE 4-12-61

FILL SEPTIC TANK AND DISTRIBUTION BOX WITH WATER BEFORE CALLING FOR AN INSPECTION. COVER NO WORK UNTIL INSPECTED AND APPROVED.

NEITHER THE HOWARD COUNTY COMMISSIONERS NOR THE HEALTH DEPARTMENT IS RESPONSIBLE FOR THE SUCCESSFUL OPERATION OF ANY SYSTEM.

A 03558

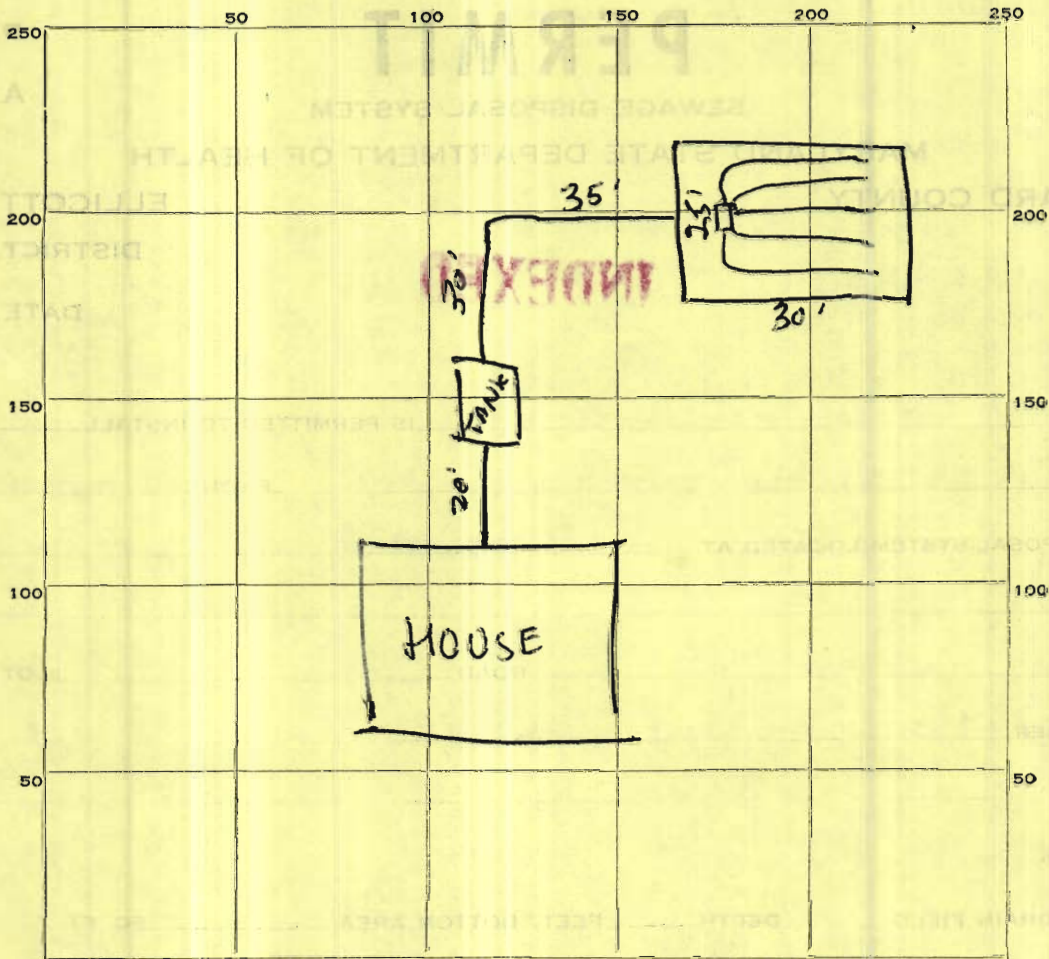

INDICATE NORTH. - NAME ADJOINING ROADWAY AS BASE LINE.

TAYLOR MANGER DR.

PERMIT CARD NO

SEPTIC TANK, LEVEL  concrete CLEANOUTS

DISTRIBUTION BOX, LEVEL \_\_\_\_\_

TILE FIELD, DEPTH \_\_\_\_\_ FT. TRENCH WIDTH \_\_\_\_\_ FT.

GRAVEL DEPTH \_\_\_\_\_ IN. TOTAL LENGTH \_\_\_\_\_ FT.

NUMBER OF TRENCHES \_\_\_\_\_ TOTAL BOTTOM AREA \_\_\_\_\_

SEEPAGE PITS, INSIDE DIAMETER \_\_\_\_\_ FT. DEPTH BELOW INLET \_\_\_\_\_ FT.

ABSORBENT AREA \_\_\_\_\_ SQ. FT.

REMARKS leaching bed 30' x 25' = 750 S.F.

7/28/61 - no distribution box apparent in bed at time of inspection, or, if present, under at least 1' of gravel. (w/c)

7/31/61 - saw distribution box. (w/c)

DATE SYSTEM APPROVED 7/31/61 INSPECTOR [Signature]