

PERMIT

SEWAGE DISPOSAL SYSTEM

P 07895

A 07894

MARYLAND STATE DEPARTMENT OF HEALTH

HOWARD COUNTY

ELLICOTT CITY

DISTRICT 2

INDEXED

DATE 12-27-63

Excavating Con.

IS PERMITTED TO INSTALL ALTER

ADDRESS _____ PHONE _____

A SEWAGE DISPOSAL-SYSTEM LOCATED AT College Ave - on Taylor Manor Hospital grounds

SUBDIVISION _____ ROAD _____ LOT _____

PROPERTY OWNER Taylor Manor Hospital

ADDRESS _____

SPECIFICATIONS for 3 bedrooms

DRAIN FIELD _____ DEPTH _____ FEET, BOTTOM AREA _____ SQ. FT.

SEEPAGE PITS NA ABSORBENT SIDE-WALL AREA 12' x 12' x 4-38 sq. ft. SQ. FT. below inlet, DNT to be

SEPTIC TANK CAPACITY 750 GALLONS 3ft below original grade

FOR GARBAGE GRINDER, INCREASE DISPOSAL AREA 22% & TANK CAPACITY 50%.

OTHER Locate 1st dry well 5ft from front and side walls of

building adjoining lot and 2nd dry well 36ft from front and 35ft


50ft from sidewall adjoining building. Retested 12-27-63 locate dry well in area tested. JH.

PLANS APPROVED BY J. Hennigan DATE 10-28-63

FILL SEPTIC TANK AND DISTRIBUTION BOX WITH WATER BEFORE CALLING FOR AN INSPECTION. COVER NO WORK UNTIL INSPECTED AND APPROVED.

NEITHER THE HOWARD COUNTY COMMISSIONERS NOR THE HEALTH DEPARTMENT IS RESPONSIBLE FOR THE SUCCESSFUL OPERATION OF ANY SYSTEM.

A 07894

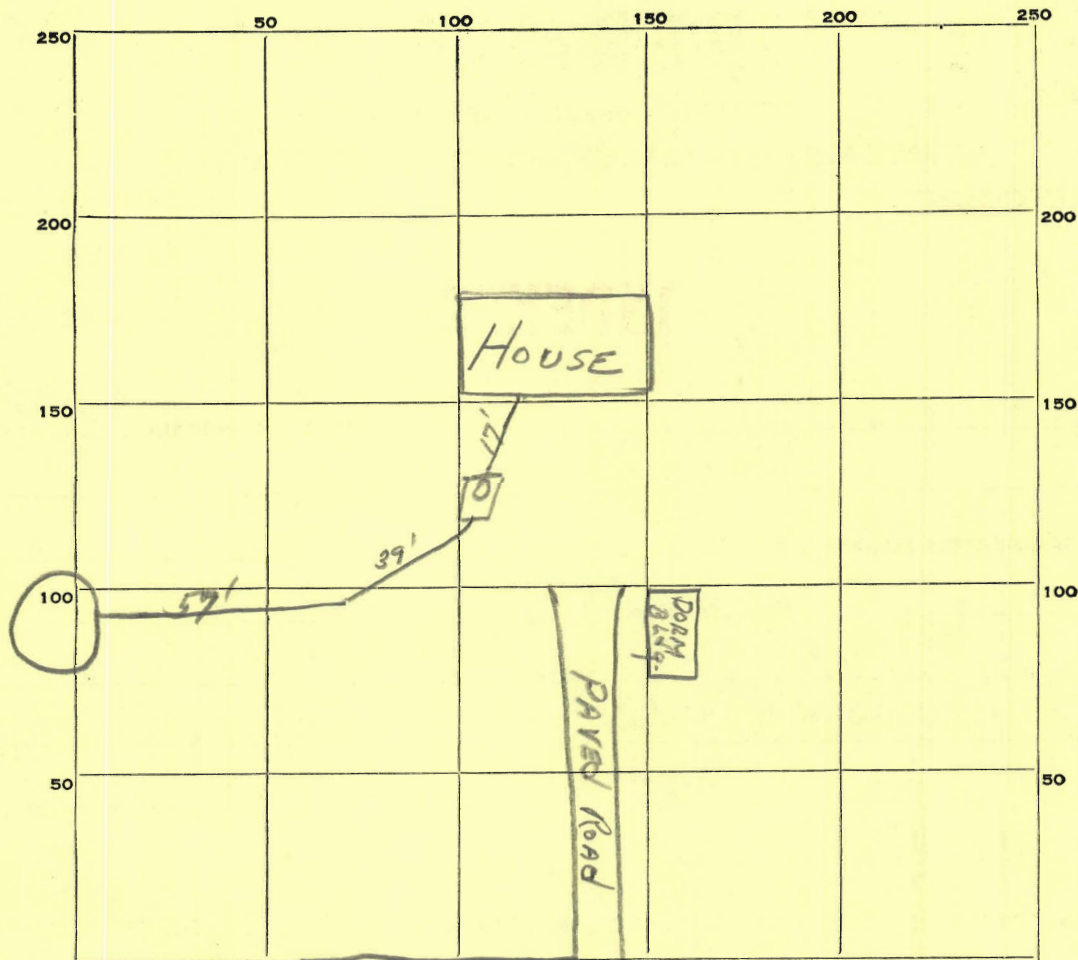

INDICATE NORTH. - NAME ADJOINING ROADWAY AS BASE LINE.

← TO COLLEGE

PERMIT CARD _____

SEPTIC TANK, LEVEL 750 gal concrete

CLEANOUTS 8" stand pipe

DISTRIBUTION BOX, LEVEL None

TILE FIELD, DEPTH _____ FT. TRENCH WIDTH _____ FT.

GRAVEL DEPTH _____ IN. TOTAL LENGTH _____ FT.

NUMBER OF TRENCHES _____ TOTAL BOTTOM AREA _____

SEEPAGE PITS, INSIDE DIAMETER 13 FT. DEPTH BELOW INLET 8 FT.

ABSORBENT AREA 414 SQ. FT. 4 sided (13x8) =

REMARKS _____

DATE SYSTEM APPROVED

12-30-63

INSPECTOR

J. Fleming

13
2