

APPLICATION

Not found

PERCOLATION TESTING

A 59281A

INDEXED

P _____

HOWARD COUNTY HEALTH DEPARTMENT
BUREAU OF ENVIRONMENTAL HEALTH
3525-H ELLICOTT MILLS DRIVE/ELLICOTT CITY, MARYLAND 21043
TELEPHONE: 313-2640

12/24/97

DISTRICT _____

Preview OK

DATE 12/24/97

no previous ALM.
record
(19)

TO: THE COUNTY HEALTH OFFICER
ELLICOTT CITY, MARYLAND

I HEREBY APPLY FOR THE NECESSARY TEST PRIOR TO APPLICATION FOR PERMIT TO CONSTRUCT (OR RECONSTRUCT) A SEWAGE DISPOSAL SYSTEM.

PROPERTY OWNER Betty Ann Franklin

ADDRESS 1838 Gun Rd Pobox 124 Woodbine Md 21797 PHONE 410-755-1829

AGENT OR PROSPECTIVE BUYER William J Franklin

ADDRESS Pobox 124 Woodbine Md 21797 PHONE 410-795-1832

PROPERTY LOCATION:

SUBDIVISION FRANKLIN PROP. LOT NO. Existing house

ROAD AND DESCRIPTION (On The Corner of Cells Mill And RT 144)
15407 Frederick Road

TAX MAP 8 PARCEL # 41

SIZE OF LOT 5.1 TYPE BLDG. Single Family
(SINGLE FAMILY DWELLING OR COMMERCIAL)

THE SYSTEM INSTALLED UNDER THIS APPLICATION IS ACCEPTABLE ONLY UNTIL PUBLIC FACILITIES BECOME AVAILABLE. I FULLY UNDERSTAND THE FEE CONNECTED WITH THE FILING OF THIS PERC TEST APPLICATION IS NON-REFUNDABLE UNDER ANY CIRCUMSTANCES. I ALSO AGREE TO COMPLY WITH ALL M.O.S.H.A. REQUIREMENTS IN TESTING THIS LOT. William J Franklin
(SIGNATURE OF APPLICANT)

APPROVED BY _____ FOR _____ DATE _____

DISAPPROVED BY _____ FOR _____ DATE _____

HOLD PENDING FURTHER TESTS _____

REASONS FOR REJECTION OR HOLDING _____

PERCOLATION TEST PLAT/PRELIMINARY PLAT - TITLE OR I.D. # _____ DATE _____

SITE DEVELOPMENT PLAN/FINAL PLAT - TITLE OR I.D. # _____ DATE _____

THIS IS NOT A PERMIT

A 59281-A

11/6/98 12:00


59281 A

COUNTY #

SOIL PROFILE

0' (5)
 1' topsoil
 red brn cl lm
 3' pale red brn si lm
 12' 20% sapr sh

CARRS MILL ROAD

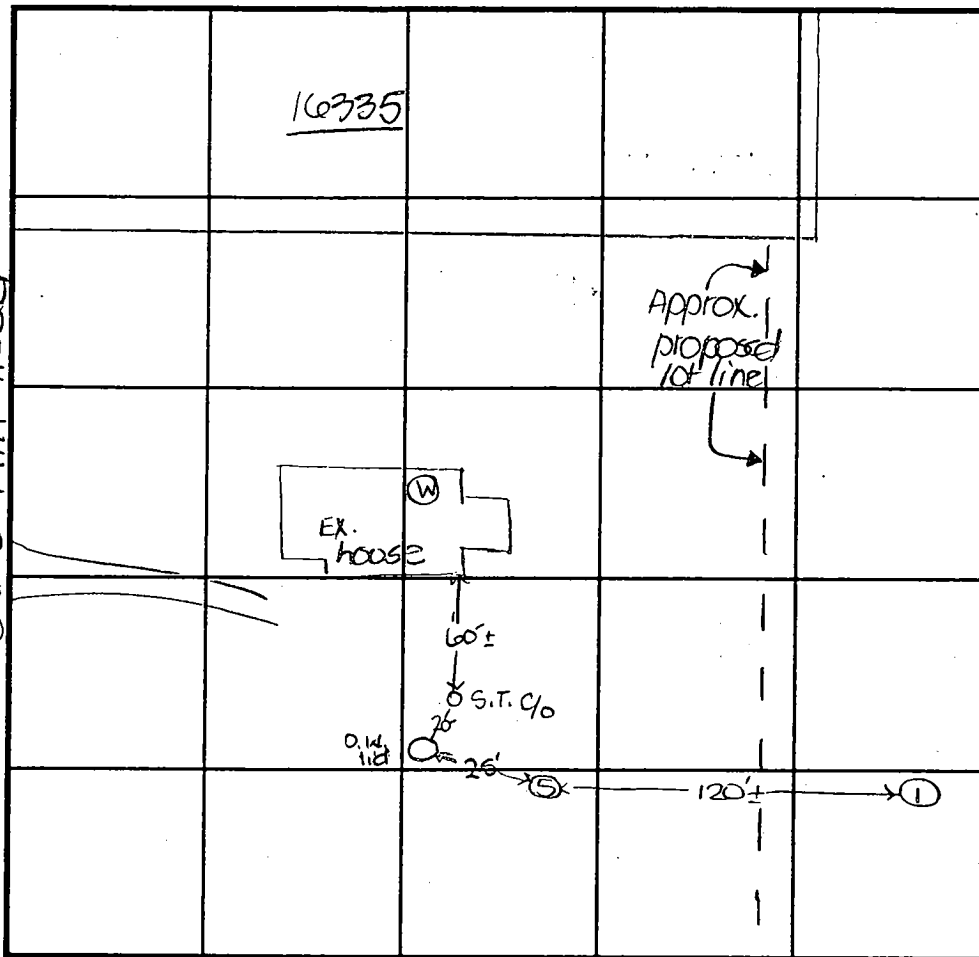

SOIL PROFILE

0'

INDICATE NORTH - NAME ADJOINING ROADWAY AS BASE LINE.

Frederick Road

0' (1)
 1' topsoil
 red brn cl lm
 3' pale red org brn si lm
 12' 25% sapr sh

| DATE | TEST NO. | DEPTH | PRE-WET | | TEST - 1" DROP | | TIME |
|--------|----------|--------|---------|-------|----------------|-------|------|
| | | | START | STOP | START | STOP | |
| 1-6-98 | 5 | 12.0'D | Visual | | | | OK |
| | 1 | 4.0'S | 12:31 | 12:34 | 12:34 | 12:40 | 6 |
| | | 8.0'M | 12:30 | 12:34 | 12:34 | 12:39 | 5 |
| | | 12.0'D | Visual | | | | OK |
| | | | | | | | |
| | | | | | | | |
REMARKS NO records for ex. house; well in basement per
 TYPE OF SOIL Mr. Franklin
 TESTED BY D. Soe ALSO PRESENT Fogle's
 TRENCH DESIGN DATA: AVERAGE PERCOLATION TIME 0 TRENCH WIDTH 2
 INLET DEPTH 3.0 MAXIMUM BOTTOM DEPTH 8.0 SQ. FT./BEDROOM 180


MD. ROUTE 144

MINOR ARTERIAL

Existing Roadway Centerline

Land Dedicated To State Of Maryland For The Purpose Of A Public Roadway (Area = 0.112 Ac.±)

Dr Ingress And Egress Is Restricted

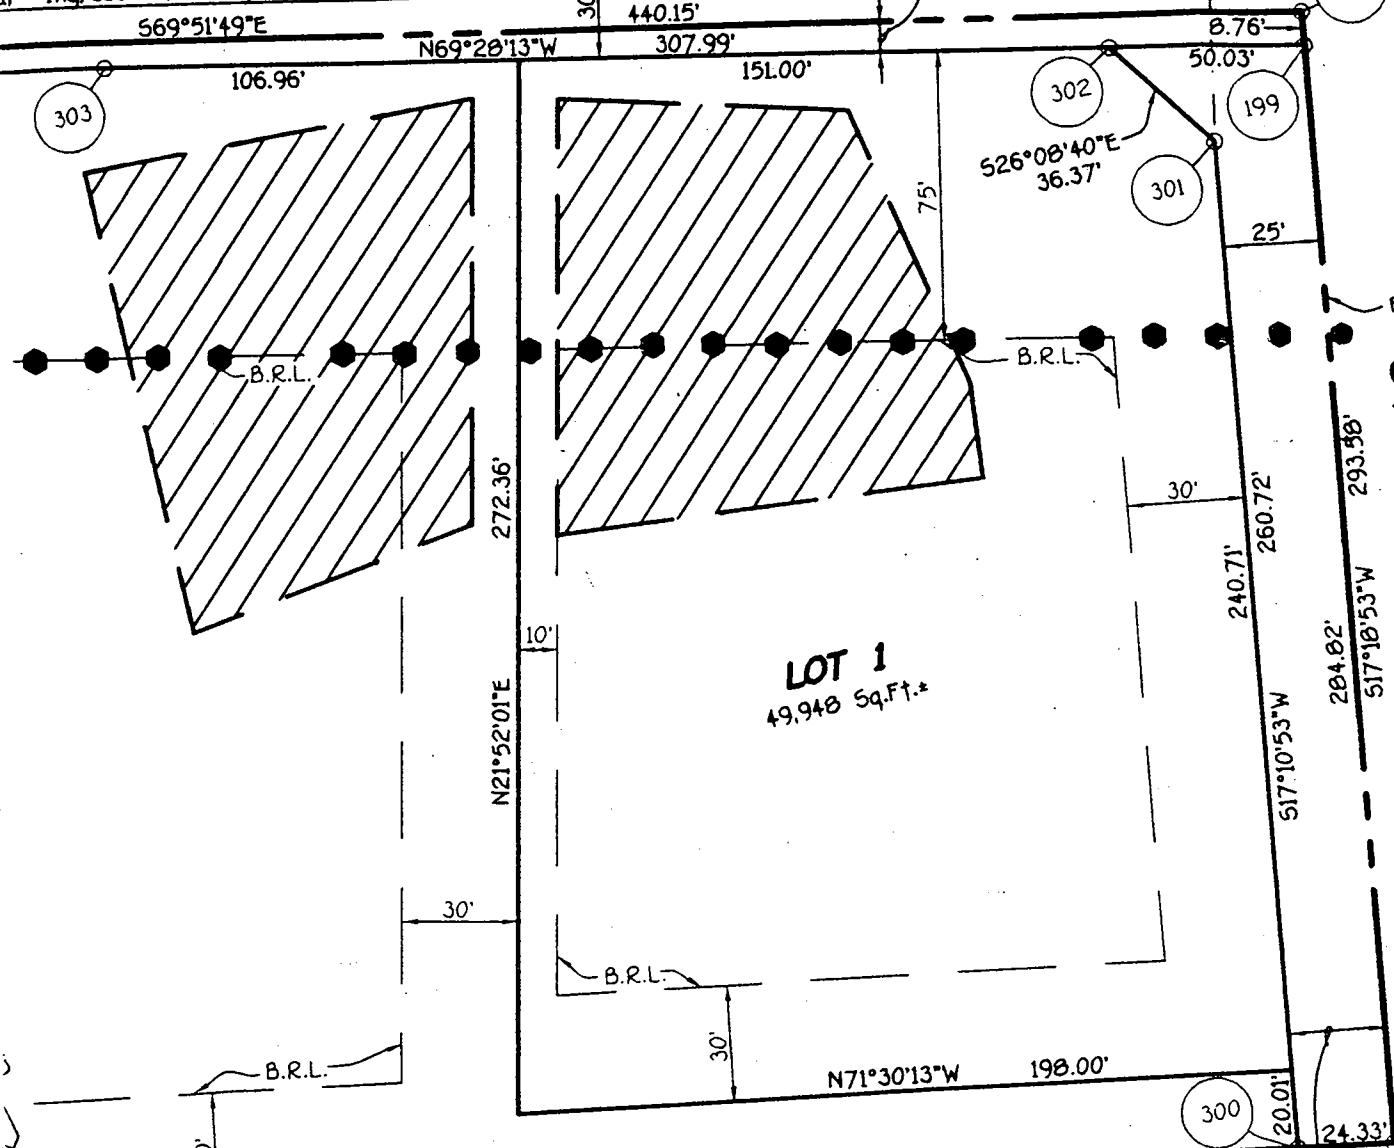

Existing Roadway Centerline

CARRS MILL ROAD (LOCAL ROAD)

- GEN**
1. Subject Compr. As Pr No. 02 08GF
 2. This Sur By B. C. 6. 7. 8. 9.

Land Dedicated To State Of Maryland And Howard County For The Purpose Of A Public Roadway (Area = 0.169 Ac.±)

GENERAL NOTES (Continued)

- f) Structure Clearances - Minimum 12 Feet;
- g) Maintenance - Sufficient To Insure All Weather Use.
15. Density Tabulation
 - A. Total Area Of Submission = 5.861 Acres.
 - B. Allowed Development Rights For Subdivision = 1 D.U. (5.861 Acres / 4.25 D.U./Acre = 1.38 D.U.)
 - C. Permitted Development Rights Under DEO = 2 (5.861 Acres / 2 D.U./Acre = 2.932 D.U.)
 - D. Number Of Proposed Buildable Lots And/Or Build Preservation Parcels = 2 D.U.
 - E. Total Number Of Density Rights Required To Be Transferred = 1 D.U. (2 D.U. - 1 D.U.) = 1 D.U.
 - F. Sending Parcel Information
 1. Tax Map No. 6
 2. Parcel No. 82
 3. Grid No. 9

GENERAL NOTES 9 (continued)

18. ●●● Denotes 65 dba Noise Line As Delineated In A Noise Study Report Prepared By Wildman Environmental Services On April 15, 1998.


PROPERTY OF LOUIS E. BRITTON AND BETTY C. BRITTON LAND PART

DATE: 12/19/2000
BY: J. C. 39552424515


1" Iron Pipe Found

47

Robert And Elizabeth Long

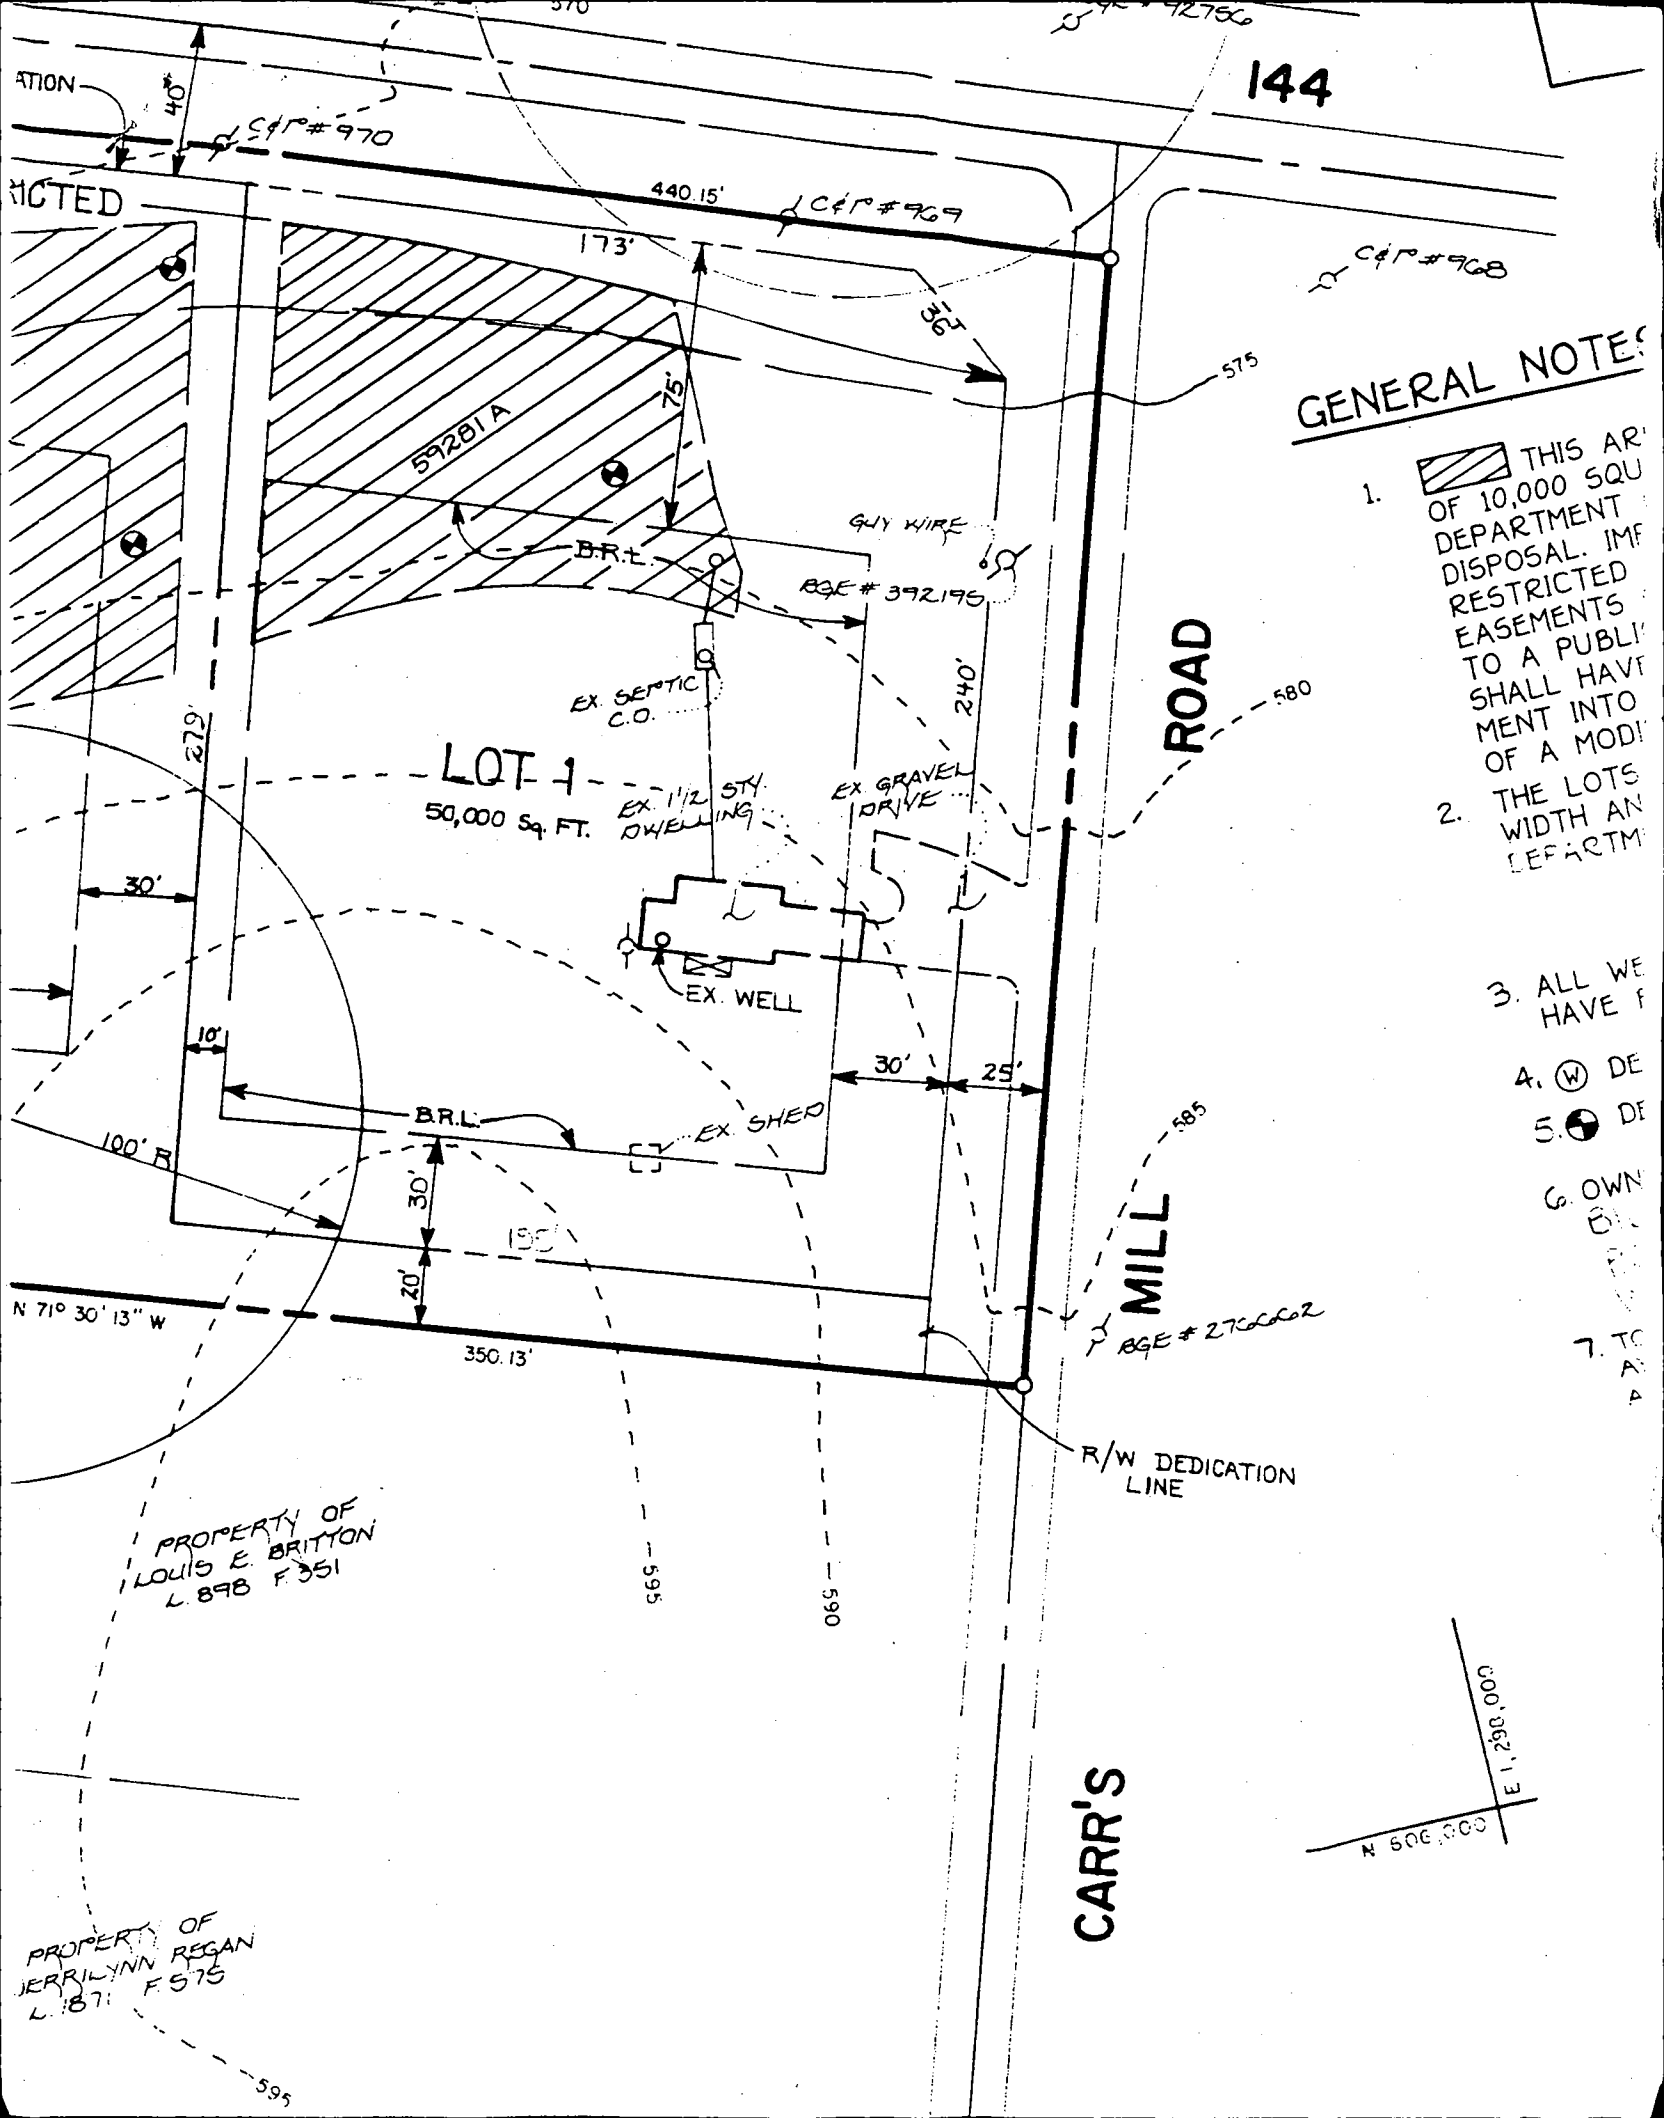

GENERAL NOTES

1.  THIS AREA OF 10,000 SQU. FEET IS A PUBLIC DEPARTMENT DISPOSAL. IMPROVED RESTRICTED EASEMENTS TO A PUBLIC SHALL HAVE PRECEDENCE INTO OF A MODIFIED EASEMENT.
2. THE LOTS WITHIN AN EASEMENT.
3. ALL WE HAVE F...
4. (W) DE...
5. (S) DE...
6. OWN...
7. TO...

ROAD

MILL

CARR'S

PROPERTY OF
LOUIS E. BRITTON
L 898 F 351

PROPERTY OF
JERRILYNN REGAN
L 187 F 575

