

APPLICATION

A 05882

SEWAGE DISPOSAL TESTING

P _____

MARYLAND STATE DEPARTMENT OF HEALTH

HOWARD COUNTY

ELLICOTT CITY

Septic Tank - 750 gal.

DISTRICT _____

Dry well - 300 sq ft absorbent sidewall area to

DATE 10/8/62

begin below the inlet pipe

Place Dry Well in area that passed percolation test (about 2 1/2 ft from front of house.)

meet man at Ho Co. Lumber Supply on 144.

TO: THE COUNTY HEALTH OFFICER
ELLICOTT CITY, MARYLAND

I, HEREBY, APPLY FOR THE NECESSARY TESTS IN ORDER TO CONSTRUCT (OR RECONSTRUCT) A SEWAGE DISPOSAL SYSTEM.

PROPERTY OWNER Along Powell

ADDRESS Cookville PHONE _____

PROPERTY LOCATION:

SUBDIVISION _____ LOT NO. _____

ROAD AND DESCRIPTION Daisy Rd. - turn on + Horseshoe driveway

1/4 mile from RT 144 on right hand side of Daisy Road

OCCUPANT _____ PHONE _____

PERSON TO CONSTRUCT SYSTEM _____

ADDRESS _____ PHONE _____

SIZE OF LOT 1 acre plus TYPE BLDG. 3 NUMBER OF BEDROOMS

IF NOT SINGLE RESIDENCE DESCRIBE _____

SIGNATURE OF APPLICANT Along Powell


APPROVED BY Donald W. Wagoner FOR Dry Well DATE 10/16/62

REJECTED BY _____ FOR _____ (KIND OF SYSTEM) DATE _____

HOLD PENDING FURTHER TESTS _____ DATE _____

REASONS FOR REJECTION OR HOLDING _____

THIS IS NOT A PERMIT

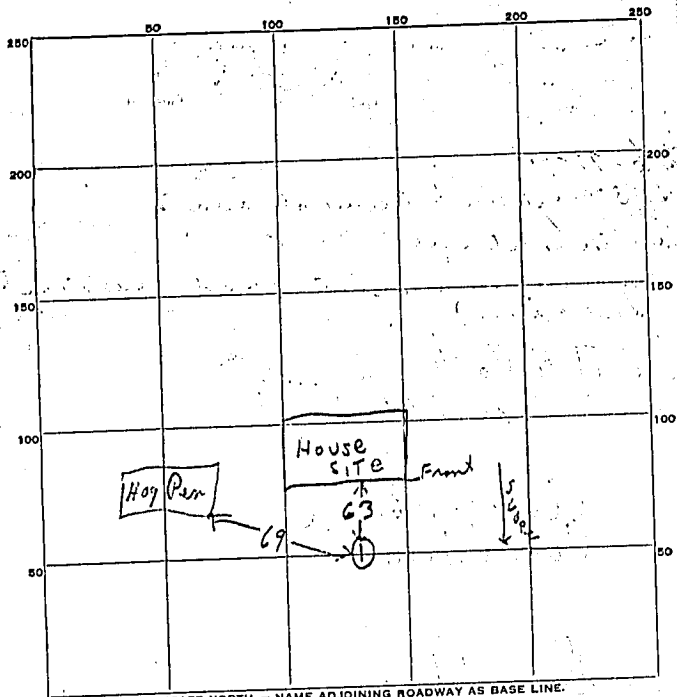

INDICATE NORTH. - NAME ADJOINING ROADWAY AS BASE LINE.

DATE	TEST NO.	DEPTH	PRE-WET		TEST - 1" DROP		TIME
			START	STOP	START	STOP	
12/11/62	1	9	854		855	1 min	
	1A	4 1/2	did not test				

SOIL AUGER FINDING _____

TESTED BY Sam 10/16/62

REMARKS _____

ALSO PRESENT Alonzo A. Jewell LOT NO. _____