

PERMIT

SEWAGE DISPOSAL SYSTEM

MARYLAND STATE DEPARTMENT OF HEALTH

HOWARD COUNTY *Approved 10/159*

ELLICOTT CITY

DISTRICT

DATE

INDEXED

George Klein

IS PERMITTED TO INSTALL OR ALTER

ADDRESS 500 Edinboro Rd. Parkville 2

PHONE Ext. 1, 2

A SEWAGE DISPOSAL SYSTEM LOCATED AT

SUBDIVISION Woods Development

ROAD Edinboro Rd

LOT 1

PROPERTY OWNER George Klein

ADDRESS 300 Edinboro Rd. Parkville, Md

SPECIFICATIONS

DRAIN FIELD DRYCH FEET, BOTTOM AREA 300 SQ. FT.

SEWAGE PITS 1 ABSORBENT SIDEWALL AREA 300 SQ. FT.

SEPTIC TANK CAPACITY 750 GALLONS

FOR GARAGE SEWER, INCREASE DISPOSAL AREA 225 & TANK CAPACITY 500

OTHER System must be installed in area that parcel photo shows

PLANS APPROVED BY Robert E. King

DATE 5/26/90

FILL SEPTIC TANK AND DISTRIBUTION BOX WITH WATER BEFORE CALLING FOR AN INSPECTION. COVER HOLES UNTIL INSPECTED AND APPROVED.


NEITHER THE HOWARD COUNTY COMMISSIONERS NOR THE HEALTH DEPARTMENT IS RESPONSIBLE FOR THE SUCCESSFUL OPERATION OF ANY SYSTEM.

CLERK, PERMIT SERVICE

ONE RECEIVED

*Serial # 2-11-98
Serial # 2-11-98-18
detached garage*



59309-F

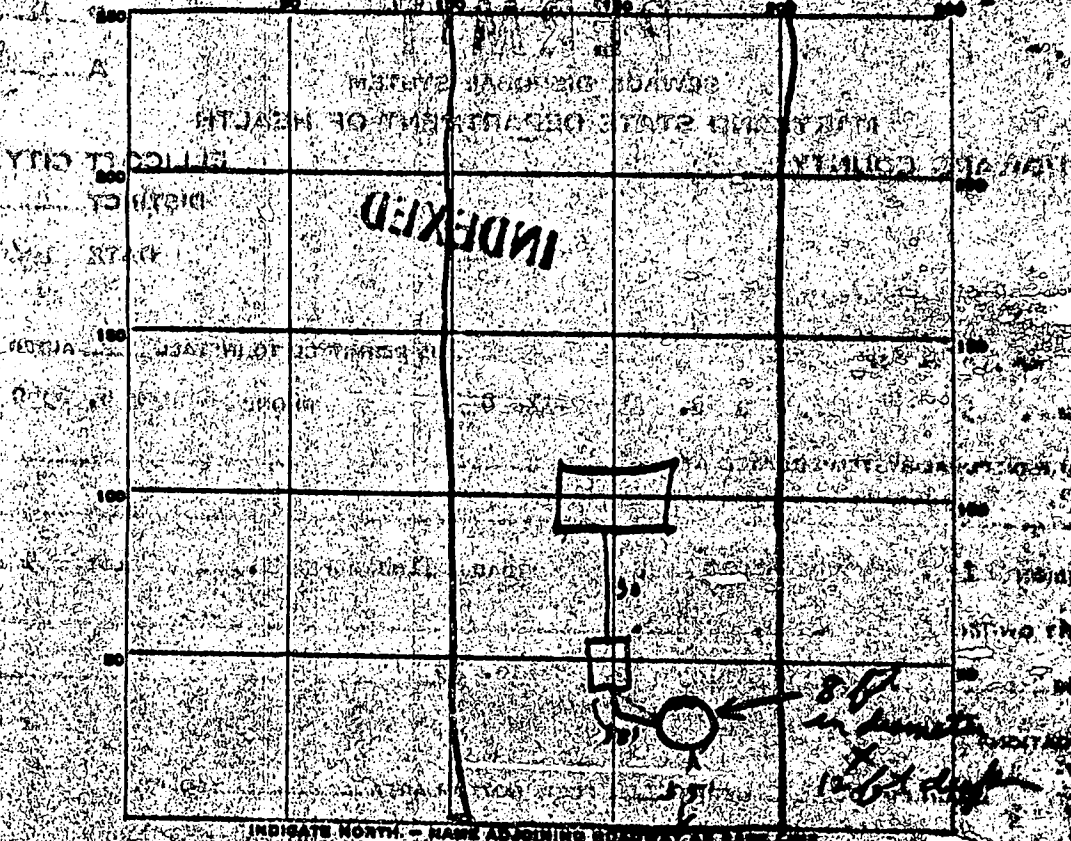

PERMIT CARD 70
 SEPTIC TANK LEVEL OK 750 CLEARANCE OK 5 ft
 DISTRIBUTION BOX LEVEL _____
 TILE FIELD, DEPTH _____ FT. TRENCH WIDTH _____ FT.
 GRAVEL DEPTH _____ IN. TOTAL LENGTH _____ FT.
 NUMBER OF TRENCHES _____ TOTAL BOTTOM AREA _____
 SERPENTINE PITS, INSIDE DIAMETER _____ FT. DEPTH BELOW INLET _____ FT.
 ABSORBENT AREA _____ SQ. FT.

REMARKS OK to finish fill 1 side of deep well with
dust gravel to go around left of it
10/7/59 - Gravel added & concrete top put on deep well

DATE SYSTEM APPROVED 10 INSPECTOR Raymond Hodges

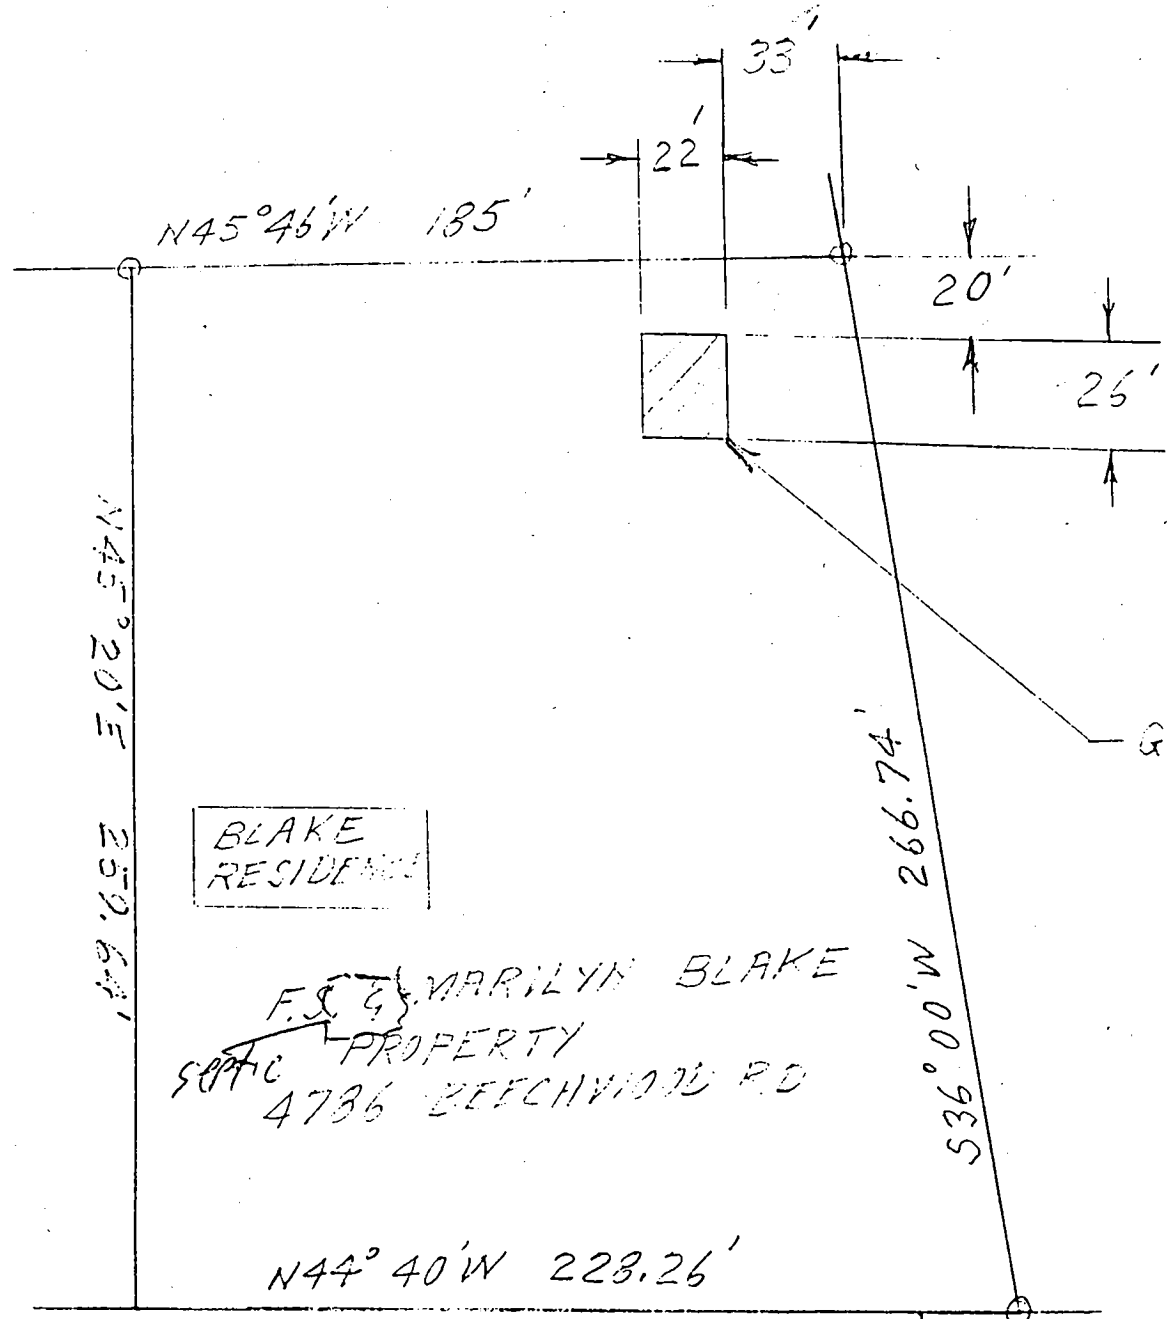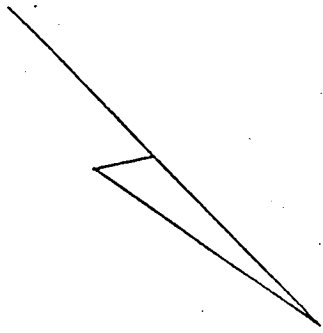

BLAKE
RESIDENCE

F.S. & MARILYN BLAKE
PROPERTY
4736 BEECHWOOD RD

BEECHWOOD RD

2/1/98 Proposed
garage location
oil as shown
you are

GARAGE

SCALE 1" = 50'

APPLICATION

HOWARD COUNTY

SERIAL NUMBER

PERMIT APPLICATION

DEPARTMENT OF INSPECTIONS, LICENSES & PERMIT
3430 COURT HOUSE DRIVE, ELLICOTT CITY, MARYLAND 21043

25
2-7
87
B0009578

BUILDING ADDRESS (HOUSE NO., STREET, TOWN OR AREA)
**4786 BEECHWOOD ROAD 34248
ELLICOTT CITY, MD 21043**

GRADING/SEDIMENT CONTROL YES NO
SDP #

DESCRIPTION OF WORK AUTHORIZED
**22'x26' GARAGE DETACHED
FROM HOUSE**

LOT NO. 3
PARCEL NO. 411
SEC. -
AREA -
BLOCK NO. 10
LIBER 4095
FOLIO 125

SUB DIVISION John C. Thomas Subd
ZONE R-20
ZONE MAP 31
ELEC. DIST 1st
CENSUS TR 6011.01

OWNER NAME AND ADDRESS
**MARILYN A. BLAKE
& FRED S. BLAKE**
PHONE NO. **410-747-7374**

SIZE OF BLDG. FRONT 22 DEPTH 26 HEIGHT 15 FT

OCCUPANT'S NAME AND ADDRESS
SAME
PHONE NO.

TYPE OF BLDG. AREA VOLUME ROOF
B. ROOMS
C. ROOMS
D. ROOMS
E. ROOMS

ARCHITECT OR ENGINEER'S NAME AND ADDRESS
OWNER
PHONE NO.

FOOTINGS 18" WD X 9 DP FOUNDATION 8" CONK S. WALLS FRAME

CONTRACTOR'S NAME AND ADDRESS
OWNER
PHONE NO.

UTILITIES
WATER WELL SEWER SEPTIC GAS ELECTRICITY TYPE OF HEAT AC
NONE NONE NONE NONE NONE NONE

EXISTING USE SFD 5,000.00
PROPOSED USE **GARAGE**

I have carefully examined and read this application and know the same is true and correct, and that in doing this work, all provisions of Howard County Ordinances and the State Laws of Maryland will be complied with, whether specified or not; and I will notify the Department of Inspections, and Permits twenty-four hours in advance when I am ready for the inspections called for elsewhere in the application; and that no work will be covered up until such inspections have been completed with.
Fred S. Blake
SIGNATURE
DATE **2-12-98**

EST. CONSTRUCTION COST **5,000.00**
LICENSE NUMBER
PERMIT FEE **157.00**

W/S CODE **FOR OFFICE USE ONLY**

DISTANCE IN FEET FROM RW LINE TO FRONT BUILDING LINE
SIDE YARD (DISTANCE IN FEET FROM SIDE BLDG. LINE TO SIDE PROPERTY LINE)
TO SIDE BUILDING LINE
DISTANCE IN FEET, REAR YD. REQUIRING SET
BACK (CORNER LOT ONLY)
SDP #

FUNCTION	DATE	SIGNATURE APPROVAL
ZONING/PLANNING	X	
SHA		
SEDIMENT/GRADING		
BUILDING OFFICIAL	X 2/10/98	[Signature]
WATER & SEWER		
HEALTH DEPT.	X 2/11/98	[Signature]
FIRE PROTECTION		
STORM WATER MGM		

Check payable to: DIRECTOR OF FINANCE OF HOWARD COUNTY

CAUTION

To begin construction before a permit placard has been issued and displayed on the job is a violation of the law.
Use and occupancy permit must be applied for two weeks before it will be issued.

IMPORTANT: PLEASE SHOW ZIP CODES AND AREA CODES WHEREVER REQUIRED.

LP-69-591

OK 39114

Distribution of Copies:
White - Building Official
Green - Planning & Zoning

Yellow - Engineering
Pink - Health Dept.
Gold - S.H.A.

APPROVED

DATE

[Signature]