

1/22/66

PERMIT

Handwritten: 4/27/66
approved 1/28/66
D.W.P.

P 10406
A 05882

SEWAGE DISPOSAL SYSTEM

MARYLAND STATE DEPARTMENT OF HEALTH

HOWARD COUNTY

Handwritten: In compliance
1/20/66 - R.P.

ELLICOTT CITY
DISTRICT 4

INDEXED

DATE 6/28/65

Alonzo Powell IS PERMITTED TO INSTALL ALTER

ADDRESS Daisy Rd., Woodbine, Md. PHONE _____

A SEWAGE DISPOSAL SYSTEM LOCATED AT _____

SUBDIVISION _____ ROAD Daisy Rd. LOT _____

PROPERTY OWNER Alonzo Powell

ADDRESS _____

SPECIFICATIONS - 3 bedrooms

DRAIN FIELD _____ DEPTH _____ FEET, BOTTOM AREA _____ SQ. FT.

SEEPAGE PITS _____ ABSORBENT SIDE-WALL AREA _____ SQ. FT.

SEPTIC TANK CAPACITY 750 GALLONS

FOR GARBAGE GRINDER, INCREASE DISPOSAL AREA 22% & TANK CAPACITY 50%.


OTHER Dry well - 300 sq. ft. absorbent sidewall area to begin below the inlet pipe.
Place dry well in area that passed percolation test (about 63 ft. from front of House).

PLANS APPROVED BY Donald W. Mousghan DATE 10/16/62

FILL SEPTIC TANK AND DISTRIBUTION BOX WITH WATER BEFORE CALLING FOR AN INSPECTION. COVER NO WORK UNTIL INSPECTED AND APPROVED.

NEITHER THE HOWARD COUNTY COMMISSIONERS NOR THE HEALTH DEPARTMENT IS RESPONSIBLE FOR THE SUCCESSFUL OPERATION OF ANY SYSTEM.

A.05882

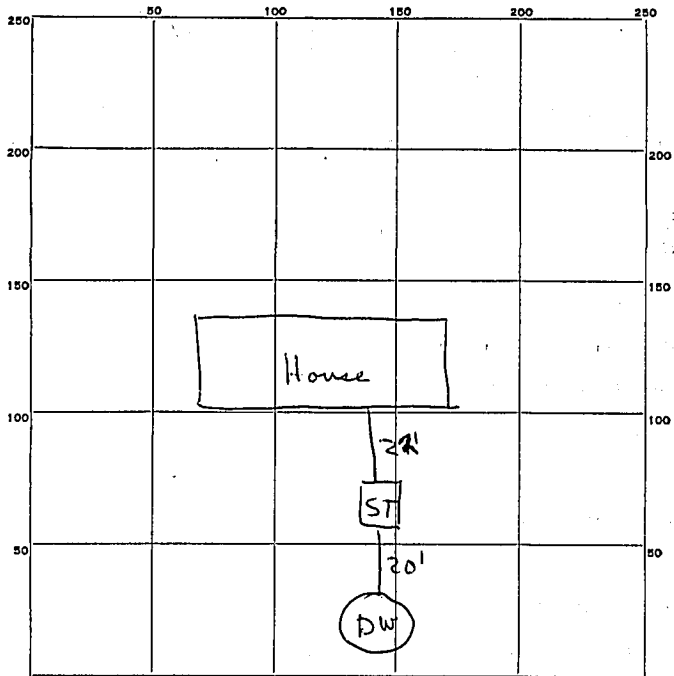

INDICATE NORTH. - NAME ADJOINING ROADWAY AS BASE LINE.

Daisy Rd.

PERMIT CARD OK

SEPTIC TANK, LEVEL OK

CLEANOUTS OK

DISTRIBUTION BOX, LEVEL _____

TILE FIELD, DEPTH _____ FT. TRENCH WIDTH _____ FT.

GRAVEL DEPTH _____ IN. TOTAL LENGTH _____ FT.

NUMBER OF TRENCHES _____ TOTAL BOTTOM AREA _____

SEEPAGE PITS, INSIDE DIAMETER 12 FT. DEPTH BELOW INLET 10 FT.

ABSORBENT AREA 300+ SQ. FT.

REMARKS 1/18/66 - Incomplete - gravel not around dugwell - P.F.

DATE SYSTEM APPROVED 1-28-66

INSPECTOR Wesley M. ...