

APPLICATION

A 11967

SEWAGE DISPOSAL TESTING

P _____

MARYLAND STATE DEPARTMENT OF HEALTH

HOWARD COUNTY

ELLICOTT CITY

Septic Tank - 1250 gallons

DISTRICT 4th

DATE 5-31-66

2 dry wells. Each 400 sq. ft. below the inlet pipe and 40 ft. apart measured edge to edge. First one to be located 180 ft. from right front corner and 30 ft. from right side line, as seen when facing lot from Daisy Rd. Discount first 7 ft. of soil below original grade, maximum depth 18 ft.

TO: THE COUNTY HEALTH OFFICER
ELLICOTT CITY, MARYLAND

I, HEREBY, APPLY FOR THE NECESSARY TESTS IN ORDER TO CONSTRUCT (OR RECONSTRUCT) A SEWAGE DISPOSAL SYSTEM.

PROPERTY OWNER William V. and A. Kathleen Audia, pending settlement with Louise H. Adams

ADDRESS 6004 - 41st Ave. Hyattsville, Md.

PHONE WA. 7-8702

PROPERTY LOCATION:

SUBDIVISION _____ LOT NO. _____

ROAD AND DESCRIPTION West on Route 40 to Cooksville (Route 97); then west on Route 144 to Daisy Rd.; stay on Daisy Rd. and property is on south side of Bushy Park Rd. (just past Cole Farm).

OCCUPANT _____ PHONE _____

PERSON TO CONSTRUCT SYSTEM _____

ADDRESS _____ PHONE _____

SIZE OF LOT 7.22 acres (frontage on Daisy Rd.) TYPE BLDG. House (5 bedrooms)

IF NOT SINGLE RESIDENCE DESCRIBE _____

RECEIVED
JUN 1 8 54 AM '66
HOWARD COUNTY
HEALTH DEPT.
ELLICOTT CITY, MD.

SIGNATURE OF APPLICANT William V. Audia A. Kathleen Audia

APPROVED BY J. H. Robinson FOR 2 dry wells DATE 6/24/66


REJECTED BY _____ FOR _____ (KIND OF SYSTEM) DATE _____

HOLD PENDING FURTHER TESTS YH DATE 6/14/66

REASONS FOR REJECTION OR HOLDING 6/14/66 see letter above

THIS IS NOT A PERMIT

curve
945
14 JUNE 66

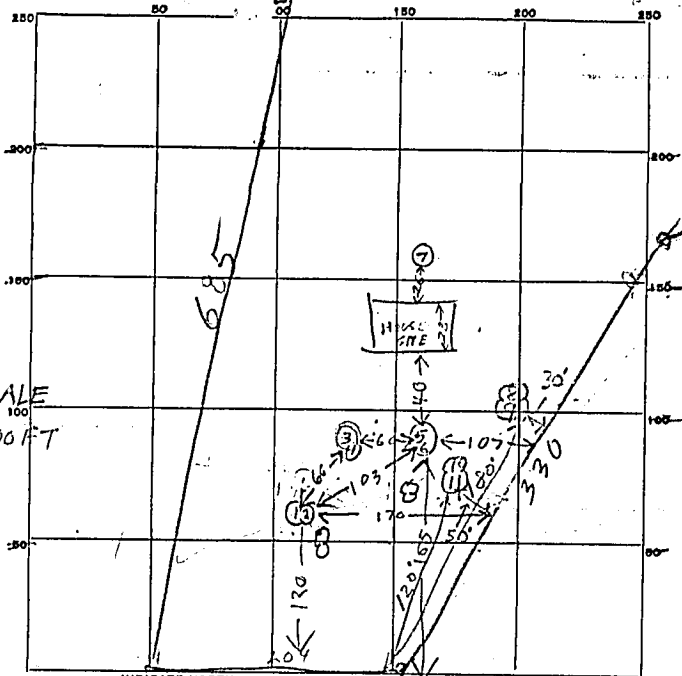

SCALE
100
1" = 100 FT

INDICATE NORTH. - NAME ADJOINING ROADWAY AS BASE LINE.

DAISY RD

addition check was made
dry region water (matted ground)
that running with Daisys (dry well). This was changed

TO REC 144

TOP 5' CLAY SAND
BOTTOM 3 1/2' CLAY
ALL CLAY
TOP 7' CLAY
BOTT 2' SAND CLAY
ALL SAND

	DATE	TEST NO.	DEPTH	PRE-WET		TEST - 1" DROP		TIME
				START	STOP	START	STOP	
	6/14/66	(1)	8 1/2'	9:56	11:15	little perc		
	6/14/66	2	4 1/2'	9:57	10:17	10:17	10:42	25
	6/14/66	(3)	9'	10:43	12:10	little perc		
	6/14/66	(4)	5 1/2'	10:43	11:13	11:13	12:10	little perc
	6/14/66	5	9'	11:22	11:34	11:34	11:53	19
	6/14/66	(6)	5'	11:27			12:47	little perc
	6/14/66	(7)	8'	ALL CLAY TOO LATE TO		NO WATER TEST TODAY		
	6/14/66	8	12 1/2'	9:53	9:58	9:58	10:06	8 min
		(9)	7 1/2'	9:58	overtime			
		(10)	12 1/2'	10:10	10:13	10:13	10:19	6 min
		(11)	7 1/2'	10:12	overtime			
SOIL AUGER FINDING			9 1/2'	9:05	4 11	5 min	6 min	15 min

SOIL AUGER FINDING

TESTED BY

B. Hodges 6/25/66 JHK

REMARKS

300
500
4) 74
19
795