

1-20-98  
10:00 AM

# PERMIT

## SEWAGE DISPOSAL SYSTEM

### DEPARTMENT OF HEALTH AND MENTAL HYGIENE

01-678571

P 59340

A REPAIR

DISTRICT \_\_\_\_\_

DATE 1-28-98

HOWARD COUNTY HEALTH DEPARTMENT  
BUREAU OF ENVIRONMENTAL HEALTH

~~XXXXXXXX~~ 410-313-2640

DATE SYSTEM APPROVED 1/21/98

INDEXED

INSPECTOR KM

Jack Fyock Septic Service \_\_\_\_\_ IS PERMITTED TO INSTALL \_\_\_\_\_ ALTER

ADDRESS P. O. Box 89, Triadelphia Road, Glenelg, Maryland PHONE 410-988-9270

SUBDIVISION \_\_\_\_\_ LOT \_\_\_\_\_ ROAD 6014 Old Lawyers Hill Road

PROPERTY OWNER Todes  
ADDRESS 6014 Old Lawyers Hill Road  
Elkridge, Maryland 21227

SEPTIC TANK CAPACITY 1000 GALLONS

NUMBER OF BEDROOMS 3  
AS MUCH AS POSS. SQUARE FEET PER BEDROOM

CITY WATER

LINEAR FEET OF TRENCH REQUIRED 180

REPAIR - PURPOSE - SEPTIC SYSTEM HAS FAILED.

Call for inspection when ground is opened so sanitarian can recommend repair.  
01/20/98

IN 5' BOTT 9' 2' WIDE

PLANS APPROVED BY \_\_\_\_\_ DATE \_\_\_\_\_

COVER NO WORK UNTIL INSPECTED AND APPROVED

NEITHER THE HOWARD COUNTY COUNCIL NOR THE HEALTH DEPARTMENT IS RESPONSIBLE FOR THE SUCCESSFUL OPERATION OF ANY SYSTEM

NOTE: CLEANOUT REQUIRED EVERY 70 FEET OF SEWER LINE AND/OR AT 90° SWEEPS IN LINES FROM HOUSE TO DRAIN FIELDS, 90° ELBOWS NOT ACCEPTABLE.

NOTE: ALL PARTS OF SEPTIC SYSTEMS (I.E. TANK, DISTRIBUTION BOX TRENCHES) TO BE 100 FEET FROM WELL (UNLESS OTHERWISE SPECIFICALLY AUTHORIZED)

NOTE: IF DEEP TRENCH(ES) ARE USED CALL FOR INSPECTION BEFORE AND AFTER PLACING GRAVEL IN TRENCH(ES)

NOTE: NO DRY WELL SHALL EXCEED 15 FOOT IN DIAMETER NO ABSORPTION TRENCH TO EXCEED 100 FEET IN LENGTH

NOTE: ALL PIPE FROM HOUSE TO SEPTIC TANK MUST BE CAST IRON OR SCHEDULE 35/40 PVC OR ABS

PERMIT VOID AFTER TWO YEARS


NOTE: INSTALL STAND PIPE ON SEPTIC TANK AND DRY WELL STAND PIPES MUST BE 6 INCHES IN DIAMETER CAST IRON. CONCRETE OR TERRA COTTA OR PVA OR ABS ACCEPTED. IF TOP OF SEPTIC TANK IS DEEPER THAN 3 FEET. MANHOLE TO GRADE REQUIRED.

NOTE: DISTRIBUTION BOXES MUST HAVE BAFFLES

**\*INSTALLER IS RESPONSIBLE FOR OBTAINING FINAL APPROVAL ON THIS PERMIT**

P 59340

① ②  
 8ry  
 brn cl  
 cl lm  
 5-6  
 0ry brn  
 silt loam  
 9  
 0ry brn. fvs  
 sa si m  
 13  
 (w/o PERC  
 STICK)  
 30 min @  
 SECOND INCH  
 @ 6-6 1/2

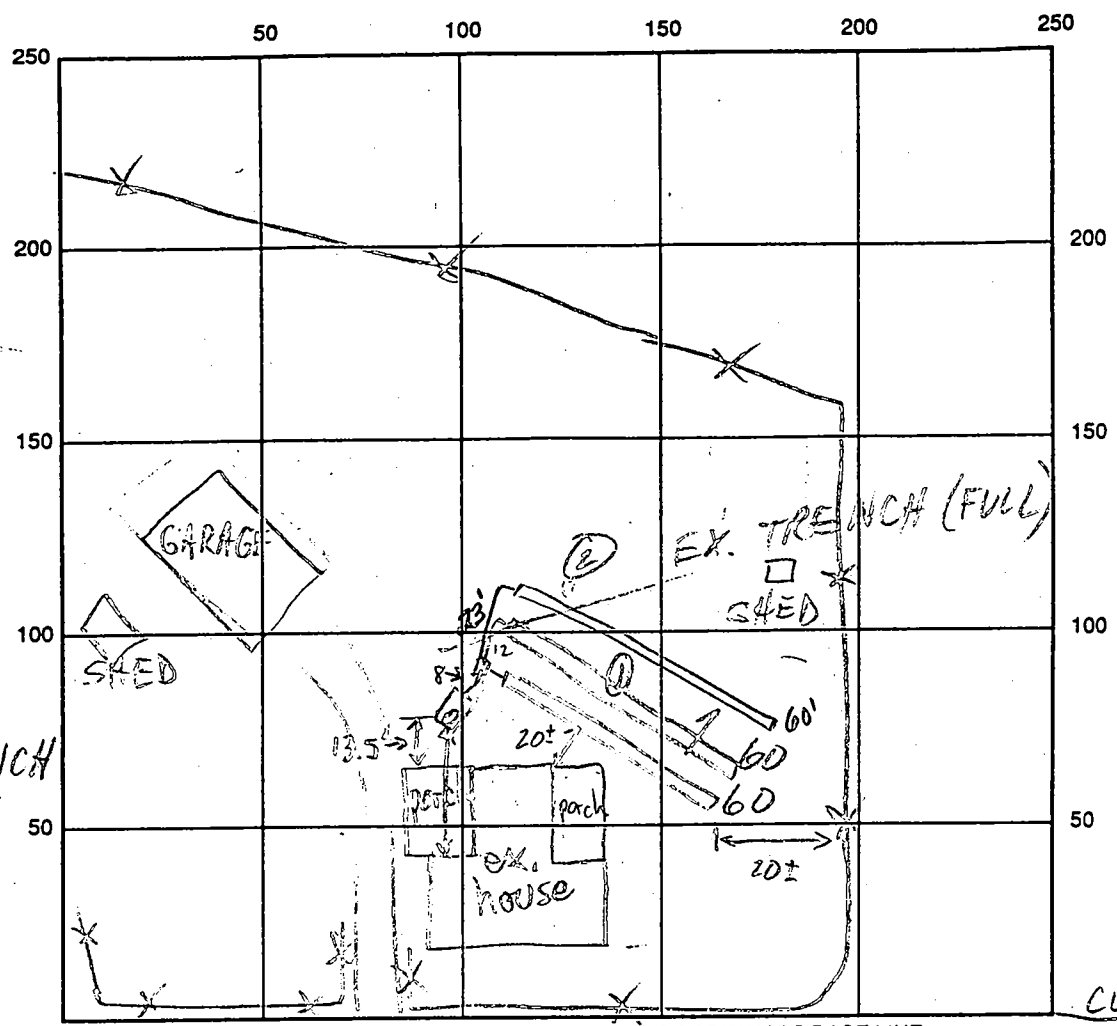

INDICATE NORTH - NAME ADJOINING ROADWAY AS BASE LINE

CUL-DE-SAC

OLD LAWYERS HILL RD

SEPTIC TANK LEVEL EX. 1000 GAL

CLEANOUTS OK

DISTRIBUTION BOX LEVEL OK

DRAIN FIELD/TITLE DEPTH 8 1/2 - 9 FT.

TRENCH WIDTH 2 FT.

INLET DEPTH 4 1/2 - 5 FT.

EFFECTIVE GRAVEL DEPTH 4 FT.

TOTAL LENGTH 3 x 60 FT. → 180

NUMBER OF TRENCHES 3

ONE SIDEWALL/BOTTOM AREA 720 SQ. FT.

DRYWALL INSIDE DIAMETER      FT.

EFFECTIVE DEPTH BELOW INLET      FT.

ABSORBENT AREA      SQ. FT.

REMARKS: 1/20/98 #1 OK TO START; SAN ADVISED OWNER OR NEED TO

LOCATE EX. WELL & PROPERLY ABANDON (MR)

1/20/98 #2 (2) TRENCHES DUG & STONED, DEPTHS OK, CONTINUE (MR)

1/21/98 ok to cover all work, ex. well still not found, owner informed me he would contact the Health Department when well was found (KAM)

DATE SYSTEM APPROVED 1/21/98

INSPECTOR Kim Marto