

*Q.O.
10:00
meet contractor*

05-359945

PERMIT

SEWAGE DISPOSAL SYSTEM

DEPARTMENT OF HEALTH AND MENTAL HYGIENE

P 59928

A REPAIR

DISTRICT _____

DATE 4-8-98

DATE SYSTEM APPROVED 4/24/98

INSPECTOR AN

HOWARD COUNTY HEALTH DEPARTMENT
BUREAU OF ENVIRONMENTAL HEALTH
~~4633333~~ 410-313-2640

INDEXED

Sutton Contracting IS PERMITTED TO INSTALL _____ ALTER

ADDRESS P.O. Box 304, Ashton, Maryland 20861 PHONE 301-930-8294

SUBDIVISION _____ LOT _____ ROAD 7032 Mink Hollow Road

PROPERTY OWNER Sandy Gibson

ADDRESS 7032 Mink Hollow Road, Highland, Maryland 20777

SEPTIC TANK CAPACITY _____ GALLONS

NUMBER OF BEDROOMS _____

_____ SQUARE FEET PER BEDROOM

LINEAR FEET OF TRENCH REQUIRED _____

REPAIR - PURPOSE - SEPTIC SYSTEM HAS FAILED (DRYWELL HAS COLLAPSED)

Call for inspection when ground is opened so a sanitarian can recommend repair.

04-07-98

PLANS APPROVED BY _____ DATE _____

COVER NO WORK UNTIL INSPECTED AND APPROVED

NEITHER THE HOWARD COUNTY COUNCIL NOR THE HEALTH DEPARTMENT IS RESPONSIBLE FOR THE SUCCESSFUL OPERATION OF ANY SYSTEM

NOTE: CLEANOUT REQUIRED EVERY 70 FEET OF SEWER LINE AND/OR AT 90° SWEEPS IN LINES FROM HOUSE TO DRAIN FIELDS, 90° ELBOWS NOT ACCEPTABLE.

NOTE: ALL PARTS OF SEPTIC SYSTEMS (I.E. TANK, DISTRIBUTION BOX TRENCHES) TO BE 100 FEET FROM WELL (UNLESS OTHERWISE SPECIFICALLY AUTHORIZED)

NOTE: IF DEEP TRENCH(ES) ARE USED CALL FOR INSPECTION BEFORE AND AFTER PLACING GRAVEL IN TRENCH(ES)

NOTE: NO DRY WELL SHALL EXCEED 15 FOOT IN DIAMETER NO ABSORPTION TRENCH TO EXCEED 100 FEET IN LENGTH

NOTE: ALL PIPE FROM HOUSE TO SEPTIC TANK MUST BE CAST IRON OR SCHEDULE 35/40 PVC OR ABS


PERMIT VOID AFTER TWO YEARS

NOTE: INSTALL STAND PIPE ON SEPTIC TANK AND DRY WELL STAND PIPES MUST BE 6 INCHES IN DIAMETER CAST IRON. CONCRETE OR TERRA COTTA OR PVA OR ABS ACCEPTED. IF TOP OF SEPTIC TANK IS DEEPER THAN 3 FEET. MANHOLE TO GRADE REQUIRED.

NOTE: DISTRIBUTION BOXES MUST HAVE BAFFLES

***INSTALLER IS RESPONSIBLE FOR OBTAINING FINAL APPROVAL ON THIS PERMIT**

R 59928

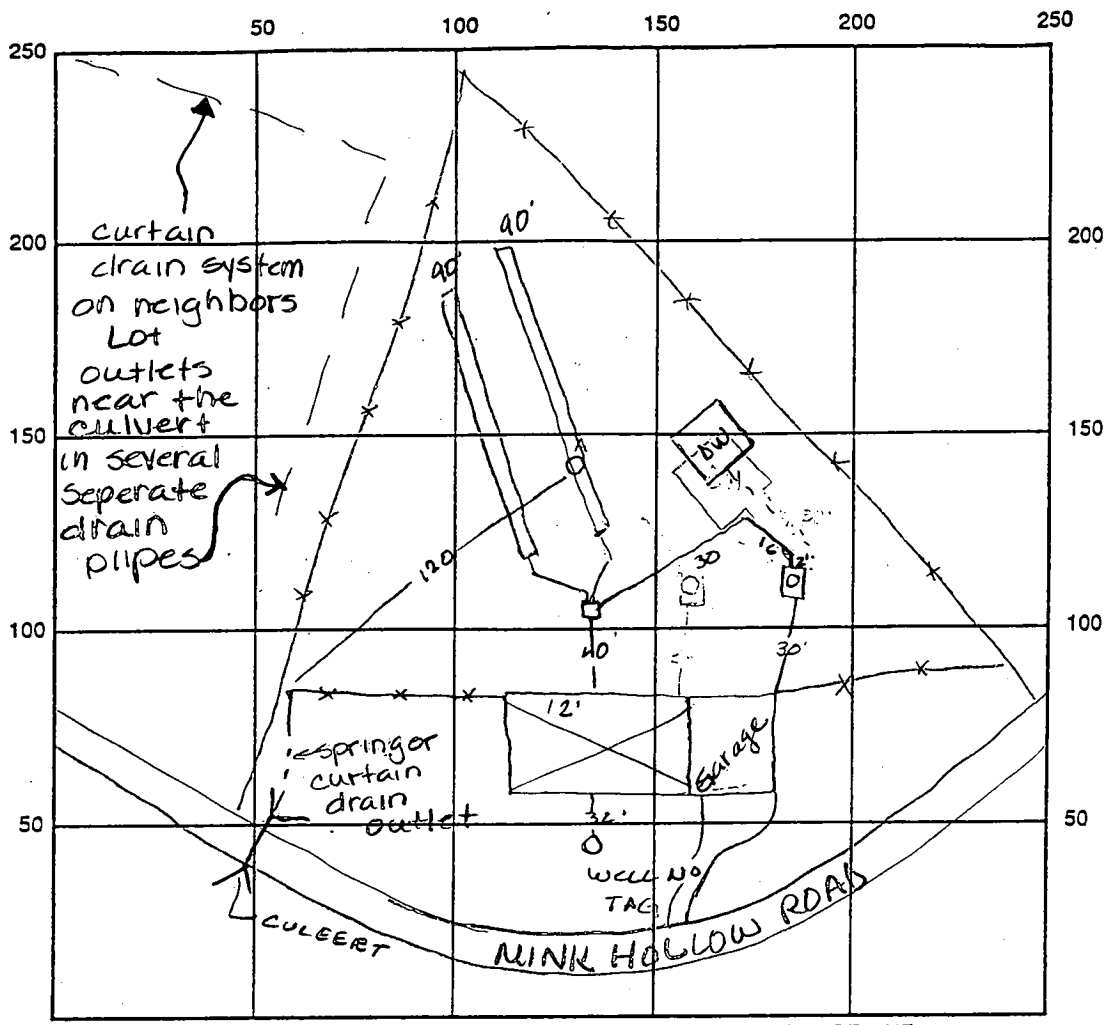

A
 yellow
 orange
 Si CLM
 3.0
 dark
 red
 Si
 micaceous
 20%
 lg R₂
 frags
 8.0

SEPTIC TANK LEVEL 1500 gal CLEANOUTS OK

DISTRIBUTION BOX LEVEL OK baffle is in

DRAIN FIELD/TITLE DEPTH 4.0 FT. TRENCH WIDTH 3.0 FT. INLET DEPTH 2.0 FT.

EFFECTIVE GRAVEL DEPTH 2.0 FT. TOTAL LENGTH 180 FT. $\frac{2 \times 180}{3} = \frac{720}{3} = 240$

NUMBER OF TRENCHES 2 ONE SIDEWALL/BOTTOM AREA 540 SQ. FT.

DRYWALL INSIDE DIAMETER FT. EFFECTIVE DEPTH BELOW INLET 2.0 FT.

ABSORBENT AREA SQ. FT.

REMARKS: 4/8/98 Install 180' of trench - inlet @ 2.0 bottom @ 4.0 Au
4/24/98 OK to cover all work final Au

DATE SYSTEM APPROVED 4/24/98 INSPECTOR A M Miller

5/24/69
6/15/69
9/24/69

Hold for final

AP 1-22-75

PERMIT

SEWAGE DISPOSAL SYSTEM
MARYLAND STATE DEPARTMENT OF HEALTH

HOWARD COUNTY

INDEXED

3 bedrooms only
B 14612
A 11066

ELLICOTT CITY
DISTRICT 9

DATE 7/1/69

William A. Merrill, Jr. IS PERMITTED TO INSTALL ALTER
ADDRESS 6410 Jodie St., Hyattsville, Md. PHONE 345-6994

A SEWAGE DISPOSAL SYSTEM LOCATED AT _____

SUBDIVISION Sweet Hill ROAD Kirk Hollow Rd. LOT 4

PROPERTY OWNER same as above

ADDRESS _____

SPECIFICATIONS - 4 bedrooms

DRAIN FIELD _____ DEPTH _____ FEET, BOTTOM AREA _____ SQ. FT.

BEEPAGE PITS _____ ABSORBENT SIDE-WALL AREA _____ SQ. FT.

SEPTIC TANK CAPACITY 2,000 GALLONS

FOR GARBAGE GRINDER, INCREASE DISPOSAL AREA 25% & TANK CAPACITY 50%.

OTHER Dry wall - 424 sq. ft. absorbent sidewall area below inlet pipe.

Inlet pipe to be 4" below grade. (See back)

Place dry wall about 138 ft. from front lot line and about 50 ft. from right side line as seen when facing lot from Kirk Hollow Rd.

NOTE: ALL PIPE FROM HOUSE TO SEPTIC TANK MUST BE CAST IRON.
PERMIT VOID AFTER THREE YEARS.

PLANS APPROVED BY D. W. Monaghan DATE 2/11/66


FILL SEPTIC TANK AND DISTRIBUTION BOX WITH WATER BEFORE CALLING FOR AN INSPECTION. COVER NO WORK UNTIL INSPECTED AND APPROVED.

NEITHER THE HOWARD COUNTY COMMISSIONERS NOR THE HEALTH DEPARTMENT IS RESPONSIBLE FOR THE SUCCESSFUL OPERATION OF ANY SYSTEM.

NOTIFY THE HEALTH DEPARTMENT 48 HOURS BEFORE EXCAVATIONS ARE TO BE BACK FILLED.

7/1/69


372-
1000
1/1/69

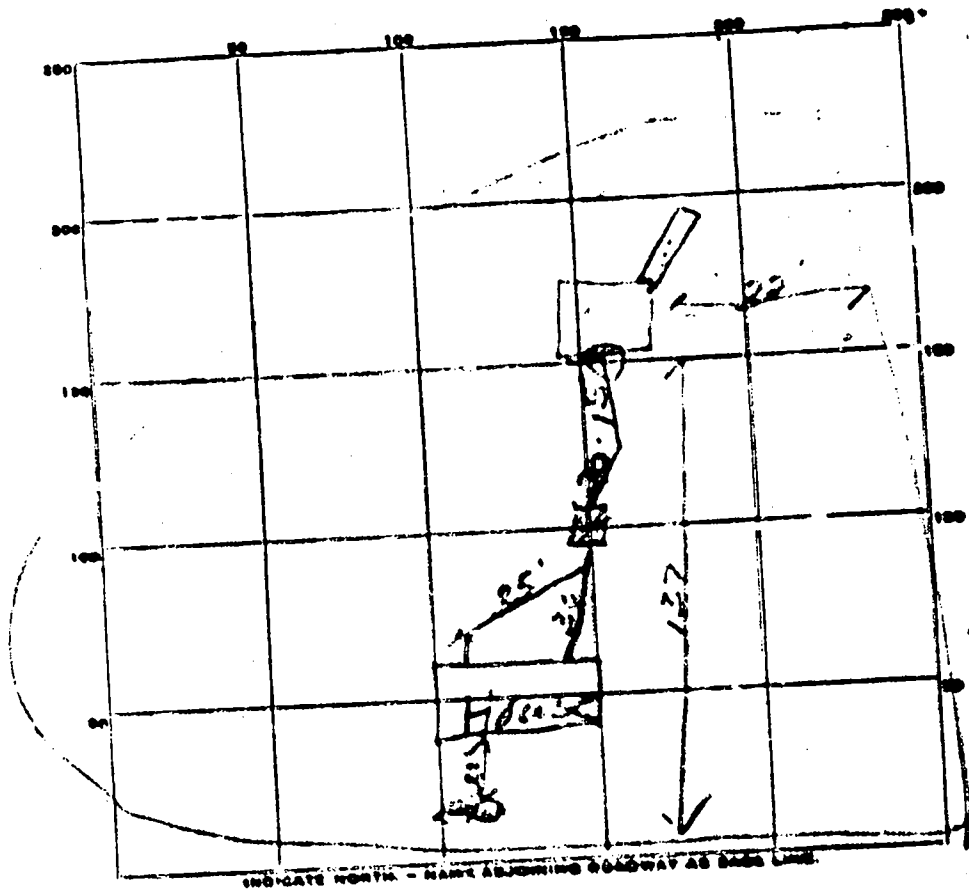

PERMIT CARD 28
 SEPTIC TANK LEVEL OK 1100 CLEANOUTS OK
 DISTRIBUTION BOX LEVEL _____
 TILE FIELD DEPTH _____ FT. TRENCH WIDTH _____ FT.
 GRAVEL DEPTH _____ IN. TOTAL LENGTH _____ FT.
 NUMBER OF TRENCHES _____ TOTAL BOTTOM AREA _____
 BEEPAGE PITS, INSIDE DIAMETER 12 FT. DEPTH BELOW INLET 7 FT.
 ABSORBENT AREA _____ SQ. FT.

REMARKS 2" x 4" blower 10' x 10' - 11' x 11' H. Generation Hall
collected (max 4 ft.) with 2' long trench, 1" pipe, with 5' pipe

DATE WHEN APPROVED 1/31/70 INSPECTOR C. M. Morgan

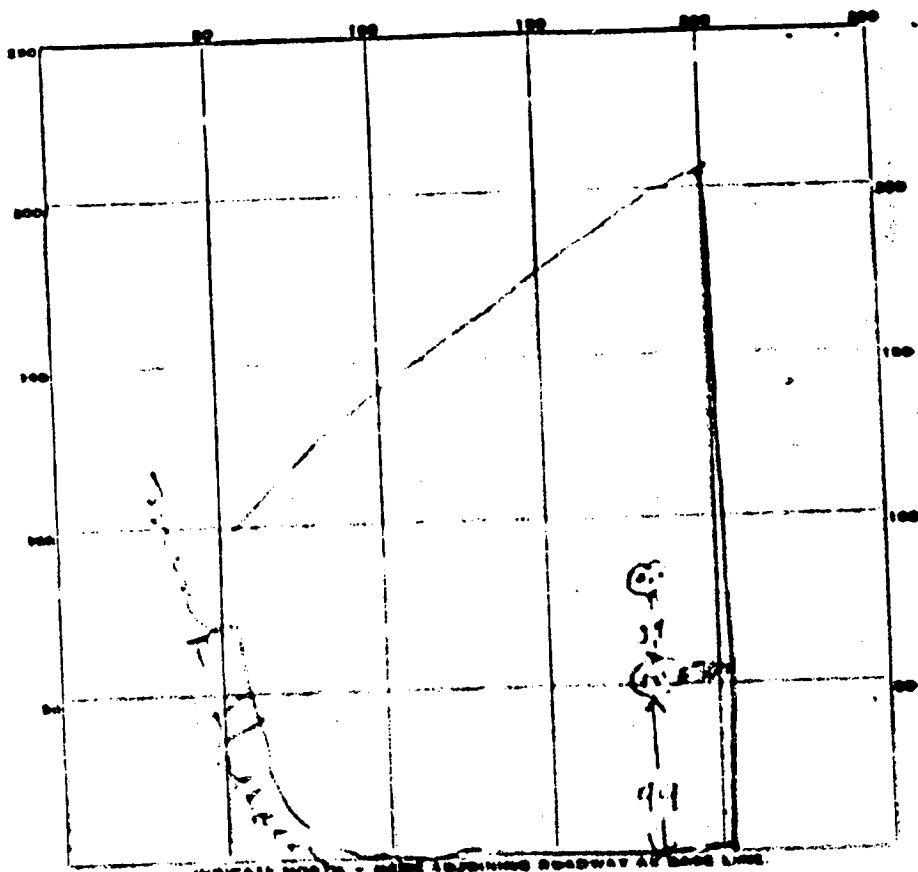

INDICATE NORTH - POINT BEGINNING ROADWAY AT BASE LINE.

DATE	TEST NO.	DEPTH	PRO. WET		100% - 1" DROP		TIME
			START	STOP	START	STOP	
1/1/52	1	979	10 9	10 17	10 9	10 20	13 min
	2	971	10 11	10 21	10 11	10 16	5 min
	3	967	10 11	10 17	10 13	10 18	5 min
	4	961	10 13	11 18	10 14	10 20	12 min

NO. OF AUGER FINDING

TESTED BY ALM

REMARKS

ALSO PRESENT

LOT NO. 4

2829

STATE OF MARYLAND DEPARTMENT OF WATER RESOURCES STATE OFFICE BLDG., ANNAPOLIS, MARYLAND 21401

THIS REPORT MUST BE SUBMITTED WITHIN 90 DAYS AFTER COMPLETION OF THE WELL. FILL IN THIS FORM COMPLETELY.

DATE WELL COMPLETED 11-09

DEPTH OF WELL 100

PERMIT NO. FROM PERMIT TO DRILL WELL 40-70-0022

OWNER [Handwritten Name]

STREET OR RFD [Handwritten Address] POST OFFICE [Handwritten Post Office]

STATE THE KIND OF PUMPING TEST CONDUCTED, THE EQUIPMENT USED, THE DEPTH OF WATER BEING PUMPED, AND THE RESULTS.

ROUTING RECORD. Includes checkboxes for 'ROUTING TEST' and 'ROUTING TEST'. Includes a diagram of a well casing with a depth of 38 feet.

PUMPING TEST. Includes checkboxes for 'PUMPING TEST' and 'PUMPING TEST'. Includes a diagram of a well casing with a depth of 30 feet.

Handwritten notes: 'Top of well 3', 'Sandstone 35-50', 'Gravel 50-100'.

CASING RECORD. Includes checkboxes for 'CASING RECORD' and 'CASING RECORD'. Includes a diagram of a well casing with a depth of 40 feet.

WATER LEVEL MEASUREMENTS. Includes checkboxes for 'WATER LEVEL MEASUREMENTS' and 'WATER LEVEL MEASUREMENTS'. Includes a diagram of a well casing with a depth of 100 feet.

OTHER CASING RECORD. Includes checkboxes for 'OTHER CASING RECORD' and 'OTHER CASING RECORD'. Includes a diagram of a well casing with a depth of 40 feet.

TYPE OF PUMPS USED. Includes checkboxes for 'TYPE OF PUMPS USED' and 'TYPE OF PUMPS USED'. Includes a diagram of a well casing with a depth of 40 feet.

CIRCLE APPROPRIATE BORES. Includes checkboxes for 'CIRCLE APPROPRIATE BORES' and 'CIRCLE APPROPRIATE BORES'. Includes a diagram of a well casing with a depth of 40 feet.

SCREEN RECORD. Includes checkboxes for 'SCREEN RECORD' and 'SCREEN RECORD'. Includes a diagram of a well casing with a depth of 40 feet.

PUMP DETAILS. Includes checkboxes for 'PUMP DETAILS' and 'PUMP DETAILS'. Includes a diagram of a well casing with a depth of 40 feet.

DEPTH RECORD. Includes checkboxes for 'DEPTH RECORD' and 'DEPTH RECORD'. Includes a diagram of a well casing with a depth of 40 feet.

CASING WEIGHT. Includes checkboxes for 'CASING WEIGHT' and 'CASING WEIGHT'. Includes a diagram of a well casing with a depth of 40 feet.

LOCATION OF WELL ON LOT. Includes checkboxes for 'LOCATION OF WELL ON LOT' and 'LOCATION OF WELL ON LOT'. Includes a diagram of a well casing with a depth of 40 feet.

