

PRELIMINARY

APPLICATION

#16

A 26605

SEWAGE DISPOSAL TESTING

STATE OF MARYLAND - DEPARTMENT OF HEALTH AND MENTAL HYGIENE

HOWARD COUNTY HEALTH DEPARTMENT
ENVIRONMENTAL HEALTH SERVICES
P. O. BOX 476, ELLICOTT CITY, MARYLAND 21043
TELEPHONE: 465-5000, EXT. 356

Septic tanks { ^{1-3 Bedrooms} 1000 gallons
 { ^{4 Bedrooms} 1250 gallons
 { ^{4th} 1600 gallons
DATE 8/16/77

BLDG. PERMIT SIGNED
AND RETURNED 4/15/80
Serial # 43011

dry well to have 190' effective
absorbent sidewall area per bedroom below
inlet. Inlet to be 4 1/2' below original grade
& maximum depth 12'. Location ~~_____~~
~~_____~~ 30' from left rear side line
lot and ~~_____~~ 1091' from front lot line
Barberry Way.

TO: THE COUNTY HEALTH OFFICER
ELLICOTT CITY, MARYLAND

I, HEREBY, APPLY FOR THE NECESSARY TEST IN ORDER TO CONSTRUCT (OR RECONSTRUCT) A SEWAGE
DISPOSAL SYSTEM.

PROPERTY OWNER J & B Partnership Hopson & Son (2) 2 inspections after test

ADDRESS 5632 Stevens Forest Rd., Apt. 254, Columbia 21045 PHONE Ron Carter - 837-0194

PROPERTY LOCATION: Westcliffe Manor LOT NO. 40

ROAD AND DESCRIPTION off Underwood Road 13726 Barberry Way

SIZE OF LOT 40,500 sq. ft. TYPE BLDG. 3 or 4 bedrooms
NUMBER OF BEDROOMS

IF NOT SINGLE RESIDENCE DESCRIBE _____

THE SYSTEM INSTALLED UNDER THIS APPLICATION IS ACCEPTABLE ONLY UNTIL PUBLIC
FACILITIES BECOME AVAILABLE.

SIGNATURE OF APPLICANT /s/ Ron Carter

APPROVED BY C.B. [Signature] FOR drywell + trench DATE 1/13/78
(KIND OF SYSTEM)


REJECTED BY _____ FOR _____ DATE _____
(KIND OF SYSTEM)

HOLD PENDING FURTHER TESTS _____ DATE _____

REASONS FOR REJECTION OR HOLDING _____

THIS IS NOT A PERMIT

3rd Parcel Forayth Rd.

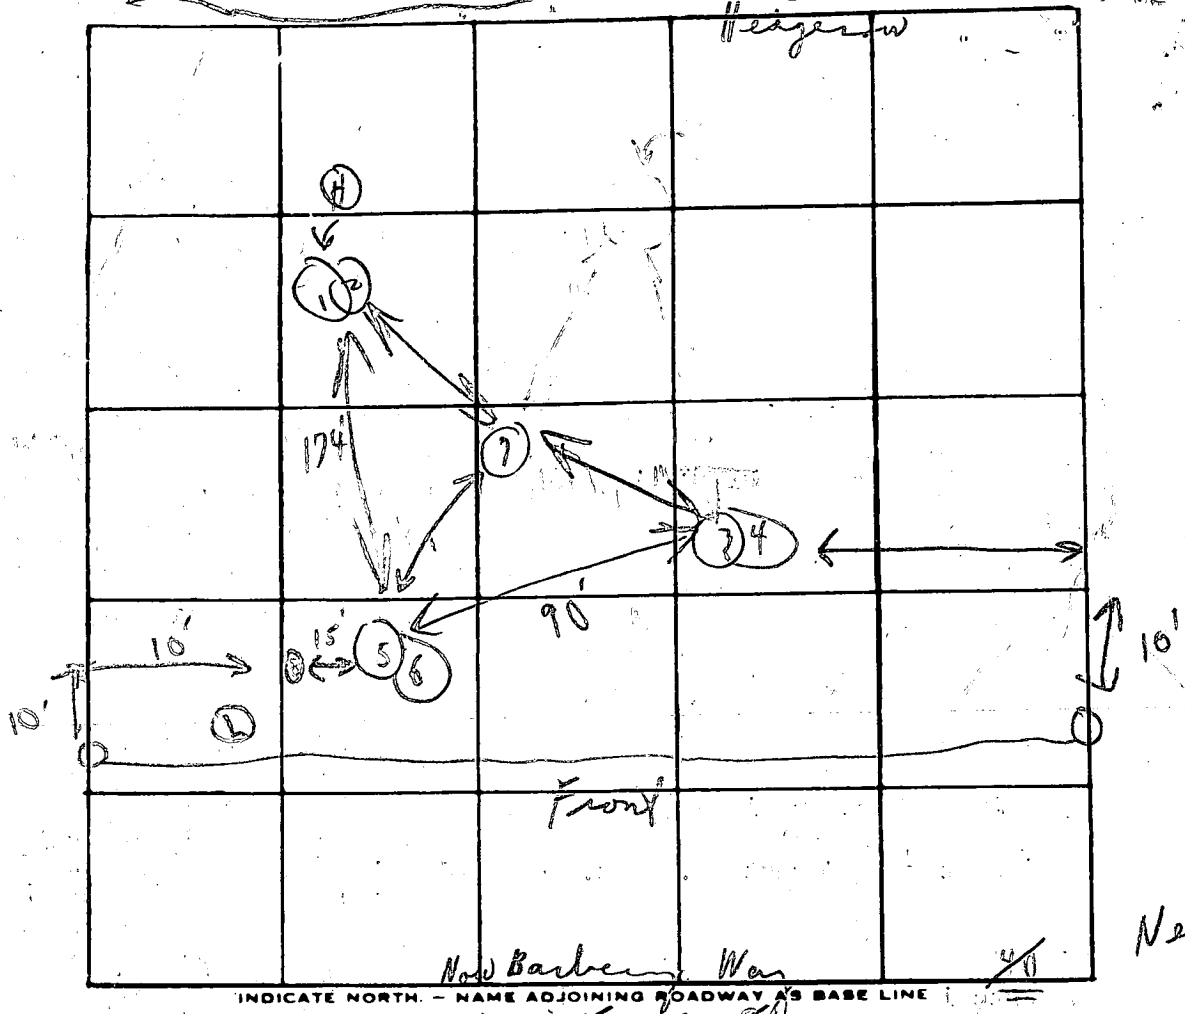

DATE	TEST NO.	DEPTH	PRE-WET		TEST - 1" DROP		TIME	
			START	STOP	START	STOP		
8/30/77	1	4 1/2'	3:03	3:11	3:11	3:22	11	
	2	13'	3:03	3:20	3:20	3:45	25	
	3	5 1/2'	3:09	3:11	3:11	3:16	5m	
	4	12 1/2'	3:09	3:13	3:13	3:18	5m	
	5	3 1/2'	3:02	3:06	3:06	3:14	8m	
	6	12 1/2'	3:02	3:08	3:08	3:22	14m	
	7	13'	Visual - sandstone 14m					
	8	10 1/2'	4 1/2' - 10 1/2'		"	"	"	
						6	68	

190 sq ft

18 min

Under 4 1/2'

12 m

from Barber clay

REMARKS Open field

TYPE OF SOIL _____

TESTED BY C. B. O. ALSO PRESENT: Frock & men