

# APPLICATION

A 16736  
P \_\_\_\_\_

2/8/72  
9:30

SEWAGE DISPOSAL TESTING

MARYLAND STATE DEPARTMENT OF HEALTH

HOWARD COUNTY SEPTIC TANK - 1250 gal.

ELLICOTT CITY

Dry Well - 500 sq. ft. absorbent sidewall

DISTRICT 4

DATE 2/2/72

area to begin below the first 4 ft. of non-porous soil. Maximum depth permitted for dry well is 13 ft. below original grade. Locate dry well ~~13~~ <sup>35 feet</sup> ~~from center of house~~ <sup>from Daisy Road</sup>

TO: THE COUNTY HEALTH OFFICER ~~located near Daisy Rd. S~~ <sup>The highest part of drywell must be 3 1/2' below original grade on slope S.C.B.S.</sup>  
ELLICOTT CITY, MARYLAND

I, HEREBY, APPLY FOR THE NECESSARY TESTS IN ORDER TO CONSTRUCT (OR RECONSTRUCT) A SEWAGE DISPOSAL SYSTEM.

PROPERTY OWNER Sherwood C. Kiernan JR.

ADDRESS 12832 Claxton Dr. Laurel, MD. PHONE 498 6813

PROPERTY LOCATION:  
SUBDIVISION Chas. W. Slagle Farm LOT NO. #19

ROAD AND DESCRIPTION Stone RD. off Daisy RD. 1500 Ft. North of ~~1/2~~ A.E. Mullinix RD. and 1000. (feet west of Daisy RD.)

OCCUPANT none PHONE \_\_\_\_\_

PERSON TO CONSTRUCT SYSTEM William Hopkins

ADDRESS Woodbine MD. PHONE \_\_\_\_\_

SIZE OF LOT 5 acres TYPE BLDG. 4 NUMBER OF BEDROOMS \_\_\_\_\_

IF NOT SINGLE RESIDENCE DESCRIBE \_\_\_\_\_

SIGNATURE OF APPLICANT S.C. Kiernan

APPROVED BY Robert V. Torne FOR Dry Well DATE 2/8/72  
(KIND OF SYSTEM)


REJECTED BY \_\_\_\_\_ FOR \_\_\_\_\_ DATE \_\_\_\_\_  
(KIND OF SYSTEM)

HOLD PENDING FURTHER TESTS \_\_\_\_\_ DATE \_\_\_\_\_

REASONS FOR REJECTION OR HOLDING \_\_\_\_\_

6/6/74 Visual hole dug 35' down slope from house 13' deep, 12K S.S. & W.Z.  
Drywell location 35' down slope from house S.S. & W.Z.

## THIS IS NOT A PERMIT

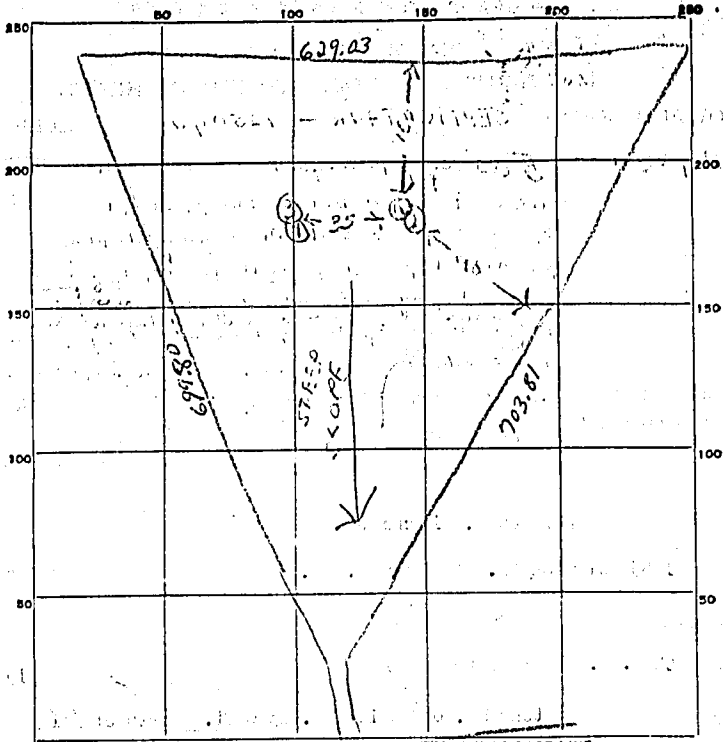

DATE	TEST NO.	DEPTH	PRE-WET		TEST - 1" DROP		TIME
			START	STOP	START	STOP	
2/1/72	1	4 1/2'	10 22	10 26	10 26	10 35	9 min
	2	10 1/2'	10 22	10 27	10 27	10 36	9 min
	3	4 1/2'	10 37	10 44	10 44	10 50	9 min
	4	7 1/2'	10 37	—	—	10 50	13 min over 3 min

Rotten Shale rock.

SOIL AUGER FINDING

TESTED BY R. Tone

REMARKS