

6/25/74

off 6-25-74
194474

PERMIT

SEWAGE DISPOSAL SYSTEM

MARYLAND STATE DEPARTMENT OF HEALTH

HOWARD COUNTY

ELLICOTT CITY

DISTRICT 4th

DATE 6/24/74

20211

A 16736

INDEXED

William Hopkins IS PERMITTED TO INSTALL ALTER

ADDRESS Jennings Chapel Road, Woodbine, Maryland PHONE 489-4711

A SEWAGE DISPOSAL SYSTEM LOCATED AT _____

SUBDIVISION _____ ROAD Daisy Road LOT 19

PROPERTY OWNER Sherwood C. Kiernan, Jr.

ADDRESS 12832 Claxton Drive, Laurel, Maryland 20810 Phone: 498-6813

SPECIFICATIONS 4 bedrooms

DRAIN FIELD _____ DEPTH _____ FEET, BOTTOM AREA _____ SQ. FT.

SEEPAGE PITS _____ ABSORBENT SIDE-WALL AREA _____ SQ. FT.

SEPTIC TANK CAPACITY 1250 GALLONS

FOR GARBAGE GRINDER, INCREASE DISPOSAL AREA 22% & TANK CAPACITY 50%.

OTHER DRY WELL - 500 sq. ft. absorbent sidewall area to begin below the first 10 feet of non-porous soil. Maximum depth permitted for dry well is 13 ft. below original grade. Locate dry well 35 feet down slope from center of house towards Daisy Road. The highest part of dry well must be 3 1/2 feet below original grade on slope.

NOTE: ALL PIPE FROM HOUSE TO DRY WELL MUST BE CAST IRON.

PERMIT VOID AFTER THREE YEARS.

NOTE: INSTALL STAND PIPE ON SEPTIC TANK AND DRY WELL.


PLANS APPROVED BY Robert V. Torre DATE 2/8/72

FILL SEPTIC TANK AND DISTRIBUTION BOX WITH WATER BEFORE CALLING FOR AN INSPECTION. COVER NO WORK UNTIL INSPECTED AND APPROVED.

NEITHER THE HOWARD COUNTY COMMISSIONERS NOR THE HEALTH DEPARTMENT IS RESPONSIBLE FOR THE SUCCESSFUL OPERATION OF ANY SYSTEM.

A 16736

DATE SYSTEM IS PROPOSED _____

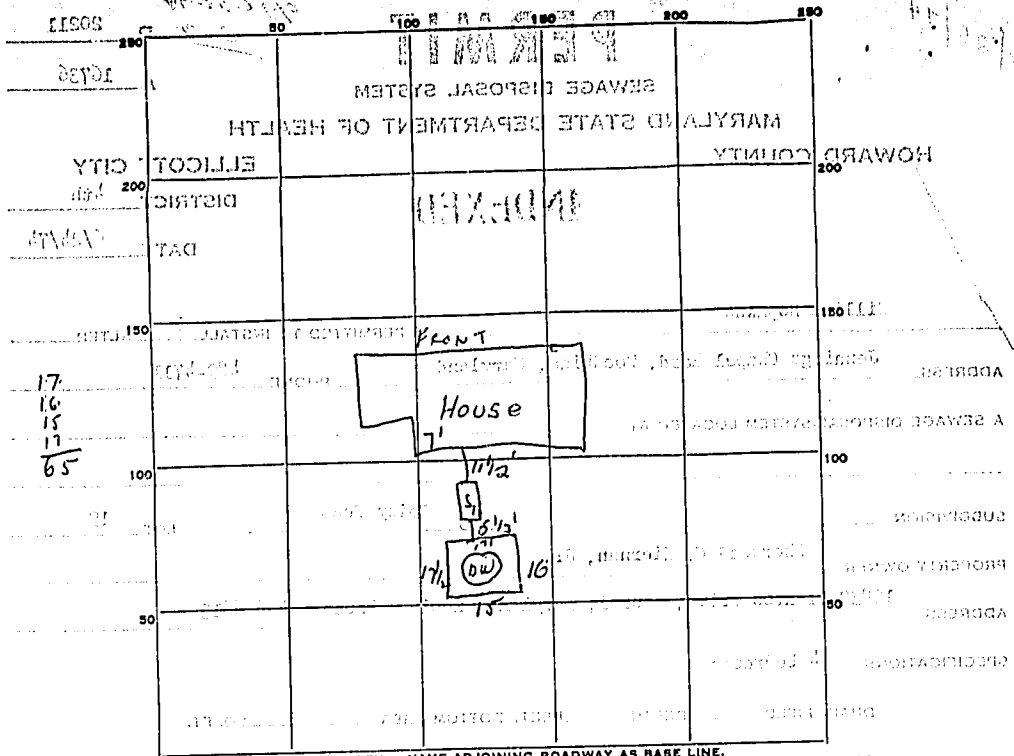

PERMIT CARD OK

SEPTIC TANK, LEVEL 0.16 CLEANOUTS OK

DISTRIBUTION BOX, LEVEL _____

TILE FIELD, DEPTH _____ FT. TRENCH WIDTH _____ FT.

GRAVEL DEPTH _____ IN. TOTAL LENGTH _____ FT.

NUMBER OF TRENCHES _____ TOTAL BOTTOM AREA _____


SEEPAGE PITS, INSIDE-DIAMETER Perimeter 65 FT. DEPTH BELOW INLET 8 FT.

ABSORBENT AREA 520 SQ. FT.

REMARKS _____

DATE SYSTEM APPROVED 6-25-74 INSPECTOR D.W. Money

WESTINGHOUSE ELECTRIC CORPORATION

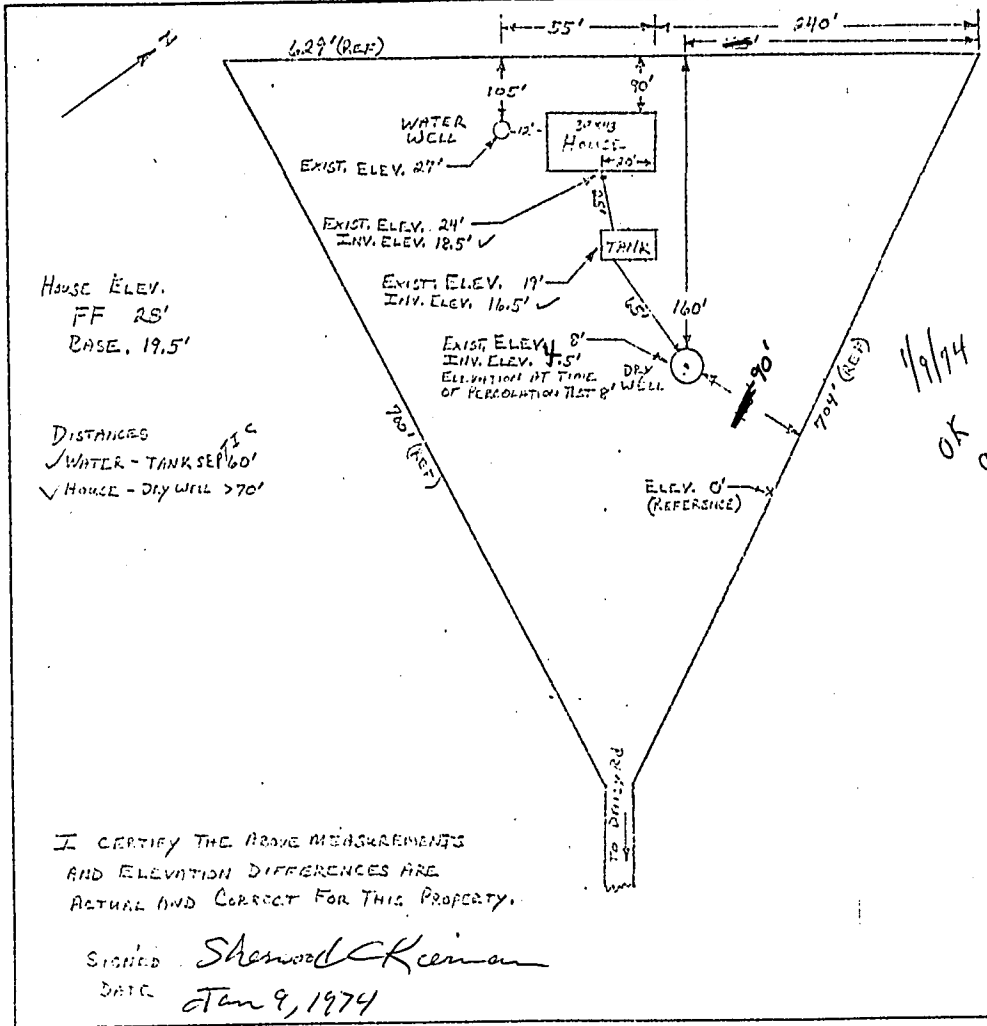

House ELEV.
FF 25'
BASE. 19.5'

DISTANCES
✓ WATER - TANK 53'
✓ HOUSE - DRY WELL 70'

I CERTIFY THE ABOVE MEASUREMENTS
AND ELEVATION DIFFERENCES ARE
ACTUAL AND CORRECT FOR THIS PROPERTY.

SIGNED *Shenwood Keenan*
DATE *Jan 9, 1974*

1/9/74
OK
C.B.S.

SKETCH SHEET
Form PA 5635