

APPLICATION

A 17661

P _____

SEWAGE DISPOSAL TESTING

MARYLAND STATE DEPARTMENT OF HEALTH

HOWARD COUNTY

ELLICOTT CITY

DISTRICT 4

DATE 11/9/72

TO: THE COUNTY HEALTH OFFICER
ELLICOTT CITY, MARYLAND

I, HEREBY, APPLY FOR THE NECESSARY TESTS IN ORDER TO CONSTRUCT (OR RECONSTRUCT) A SEWAGE DISPOSAL SYSTEM.

PROPERTY OWNER EDWARD C. AND DOLORES J. HORNBERGER

ADDRESS 631 BRISBANE ROAD PHONE 644-2508
BALTIMORE, MD. 21229

PROPERTY LOCATION:
SUBDIVISION CHARLES W. SLAGLE LOT NO. 18

ROAD AND DESCRIPTION 1200' WEST OF ~~ADLER~~ DAILY ROAD
ABOUT 2000' NORTH OF A.E. MUELLINIX ROAD

OCCUPANT UNIMPROVED PHONE _____

PERSON TO CONSTRUCT SYSTEM W. HOPKINS

ADDRESS WOODBINE, MD. PHONE 489-4711

SIZE OF LOT 5 ACRES TYPE BLDG. _____ NUMBER OF BEDROOMS 4

IF NOT SINGLE RESIDENCE DESCRIBE _____

SIGNATURE OF APPLICANT [Signature]

APPROVED BY [Signature] FOR [Signature] DATE 12-7-72

REJECTED BY _____ FOR _____ (KIND OF SYSTEM) _____ DATE _____

HOLD PENDING FURTHER TESTS _____ DATE _____


REASONS FOR REJECTION OR HOLDING _____

SOIL ANALYSIS FINDING

TESTED BY

THIS IS NOT A PERMIT

APPLICATION

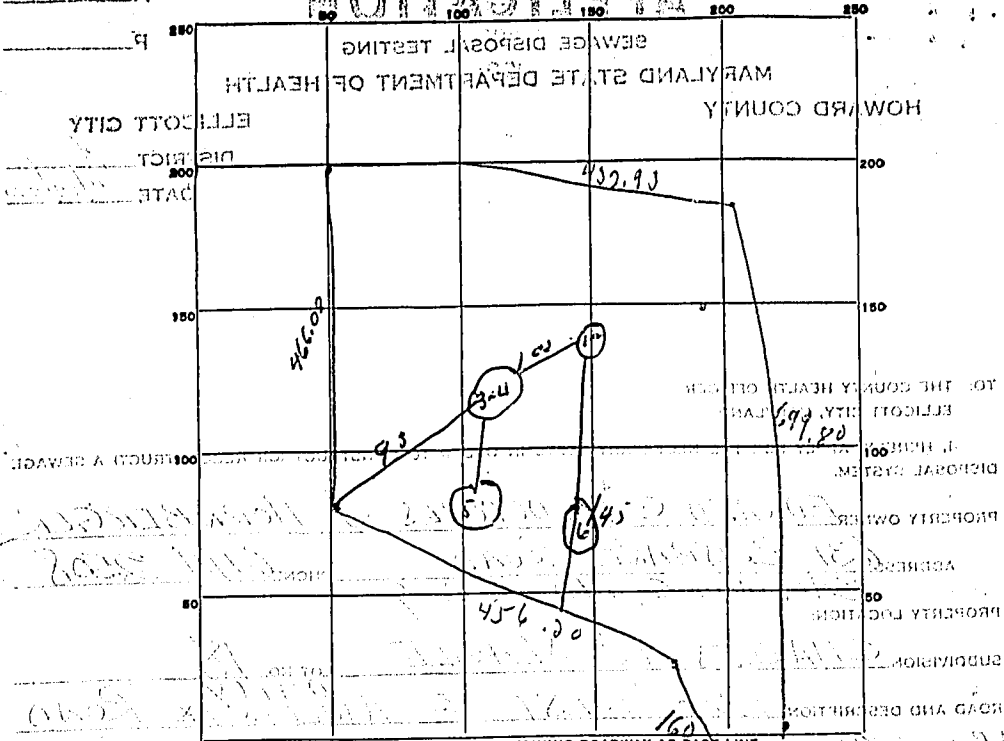

DATE	TEST NO.	DEPTH	PRE-WET		TEST - 1" DROP		TIME
			START	STOP	START	STOP	
12/7/77	1	4ft	9:50	9:58	9:58	10:02	5 min
	2	13ft	9:53	9:57	9:57	10:02	5 min
	3	15ft	10:03	10:05	10:05	10:14	9 min
	4	4ft	10:07	amputation			
	5	5 1/2 ft	10:15	10:20	10:20	10:30	10 min
	6	not taken		OK			
DATE			FOR				
DATE			FOR				
DATE			FOR				
DATE			FOR				

SOIL AUGER FINDING

TESTED BY: *[Signature]*

REMARKS

THIS IS NOT A DEED