

9/11/73
ditch inspection
a.m. if possible

9/11/73
A.W.W. 18948

PERMIT

SEWAGE DISPOSAL SYSTEM

A 17661

MARYLAND STATE DEPARTMENT OF HEALTH

HOWARD COUNTY

ELLCOTT CITY


DISTRICT 4th

INDEXED

DATE 9/7/73

Herman Sirk IS PERMITTED TO INSTALL X ALTER

ADDRESS Florence Road, Woodbine, Maryland 21797 PHONE 489-4724

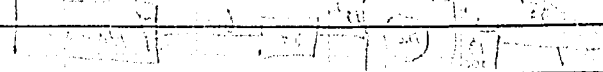A SEWAGE DISPOSAL SYSTEM LOCATED AT 

SUBDIVISION _____ ROAD Daisy Road LOT 18

PROPERTY OWNER Edward C. & Dolores J. Hornberger

ADDRESS 631 Brisbane Road, Baltimore, Md. 21229 Phone: 644-2508

SPECIFICATIONS 4 bedrooms

DRAIN FIELD _____ DEPTH _____ FEET, BOTTOM AREA _____ SQ. FT.

SEEPAGE PITS _____ ABSORBENT SIDE-WALL AREA _____ SQ. FT.

SEPTIC TANK CAPACITY 1200 GALLONS

FOR GARBAGE GRINDER, INCREASE DISPOSAL AREA 22% & TANK CAPACITY 50%.

OTHER DRY WELL - 300 sq. ft. absorbent sidewall area to begin below the first 5 1/2 ft. of non absorbent ground. Maximum depth permitted for dry well is 13 ft. below original grade. Come off dry well with trench 30 ft. long, 12 ft. deep, with 6 ft. of gravel under pipe. Call for inspection of trench before gravel is installed. Place dry well 193 ft. to right of point where the 466.8 lot line and 456.20 lot line join and 145 ft. from the 456.2 lot line. See diagram on reverse side for location.

NOTE: ALL PIPE FROM HOUSE TO DRY WELL MUST BE CAST IRON.

PERMIT VOID AFTER THREE YEARS.

NOTE: INSTALL STAND PIPE ON SEPTIC TANK AND DRY WELL.


PLANS APPROVED BY: Donald W. Monaghan DATE 12/7/72

FILL SEPTIC TANK AND DISTRIBUTION BOX WITH WATER BEFORE CALLING FOR AN INSPECTION. COVER NO WORK UNTIL INSPECTED AND APPROVED.

NEITHER THE HOWARD COUNTY COMMISSIONERS NOR THE HEALTH DEPARTMENT IS RESPONSIBLE FOR THE SUCCESSFUL OPERATION OF ANY SYSTEM.

A 17661

DATE SYSTEM APPROVED _____

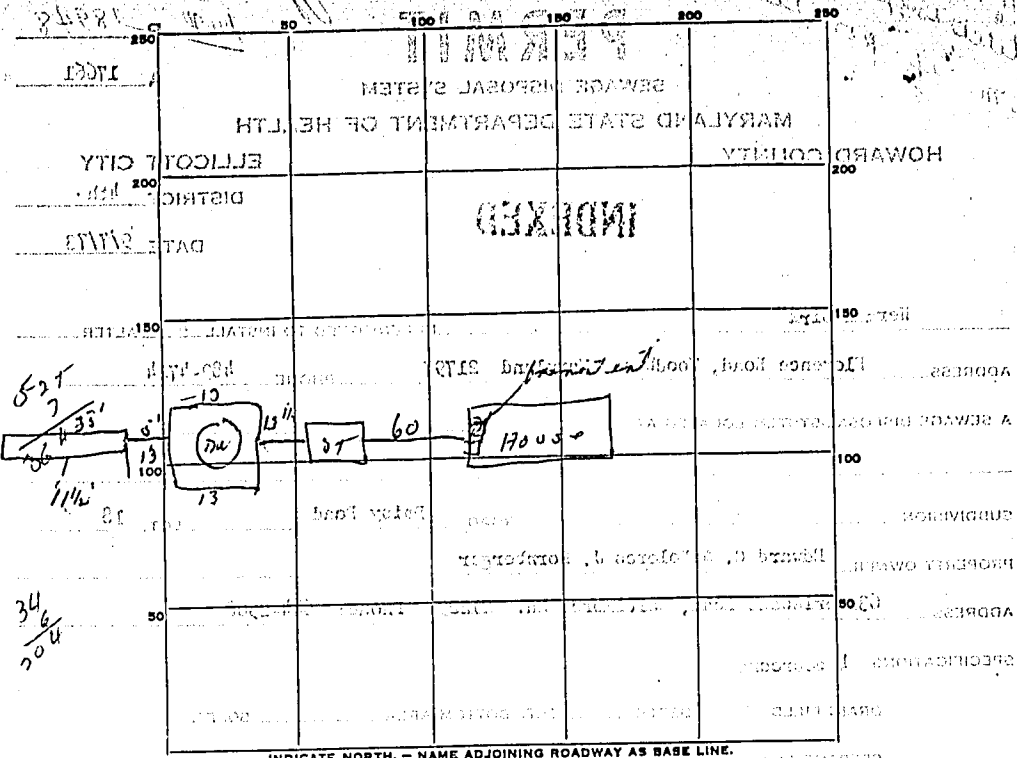

PERMIT CARD _____

SEPTIC TANK, LEVEL _____ CLEANOUTS _____

DISTRIBUTION BOX, LEVEL _____

TILE FIELD, DEPTH 9 1/2 FT. TRENCH WIDTH _____ FT.

GRAVEL DEPTH 7 1/2 IN. TOTAL LENGTH 82 1/2 FT.

NUMBER OF TRENCHES _____ TOTAL BOTTOM AREA _____

SEEPAGE PITS, INSIDE DIAMETER Permits 52 ft FT. DEPTH BELOW INLET _____ FT.

ABSORBENT AREA 364 SQ. FT. + 204 sq' one side of lawn - TOT 568 sq'

REMARKS: 9/11/73 - ok for ground in trench

DATE SYSTEM APPROVED 9/11/73 INSPECTOR [Signature]