

7/15/75
analyzed &
passed

PERMIT

P 21865

SEWAGE DISPOSAL SYSTEM

A 21795

MARYLAND STATE DEPARTMENT OF HEALTH

HOWARD COUNTY

ELLICOTT CITY

INDEXED

DISTRICT 4th

DATE 7/18/75

Norman Birk IS PERMITTED TO INSTALL X ALTER

ADDRESS Jennings Chapel Road, Woodbine, Maryland 21797 PHONE 489-4724

A SEWAGE DISPOSAL SYSTEM LOCATED AT _____

SUBDIVISION _____ ROAD 2425 Daisy Road LOT _____

PROPERTY OWNER Robert M. Warfield and Wife

ADDRESS Daisy Road, Woodbine, Maryland Phone: 774-7893

SPECIFICATIONS 3 bedrooms - Farm Trailer

DRAIN FIELD _____ DEPTH _____ FEET. BOTTOM AREA _____ SQ. FT.

SEEPAGE PITS _____ ABSORBENT SIDE-WALL AREA _____ SQ. FT.

SEPTIC TANK CAPACITY 1000 GALLONS

FOR GARBAGE GRINDER, INCREASE DISPOSAL AREA 22% & TANK CAPACITY 50%.

OTHER DRY WELL - To have 140 sq. ft. effective absorbent sidewall area per bedroom below inlet. Inlet to be 4 ft. below original grade and maximum depth 12 ft. Locate dry well 95 ft. from corner post of existing stable out towards left part of lot when facing stable from front closest to driveway (Perc hole 3 & 4).

NOTE: ALL PIPES FROM HOUSE TO DISPOSAL AREA MUST BE CAST IRON.

PERMIT VOID AFTER THREE YEARS.

NOTE: INSTALL STAND PIPE ON SEPTIC TANK AND DRY WELL. STAND PIPES MUST BE 6 INCHES IN DIAMETER. CAST IRON, CONCRETE OR TERRA COTTA ACCEPTED.


PLANS APPROVED BY Charles B. Streaker DATE 7/17/75

FILL SEPTIC TANK AND DISTRIBUTION BOX WITH WATER BEFORE CALLING FOR AN INSPECTION. COVER NO WORK UNTIL INSPECTED AND APPROVED.

NEITHER THE HOWARD COUNTY COMMISSIONERS NOR THE HEALTH DEPARTMENT IS RESPONSIBLE FOR THE SUCCESSFUL OPERATION OF ANY SYSTEM.

A 21795

21795

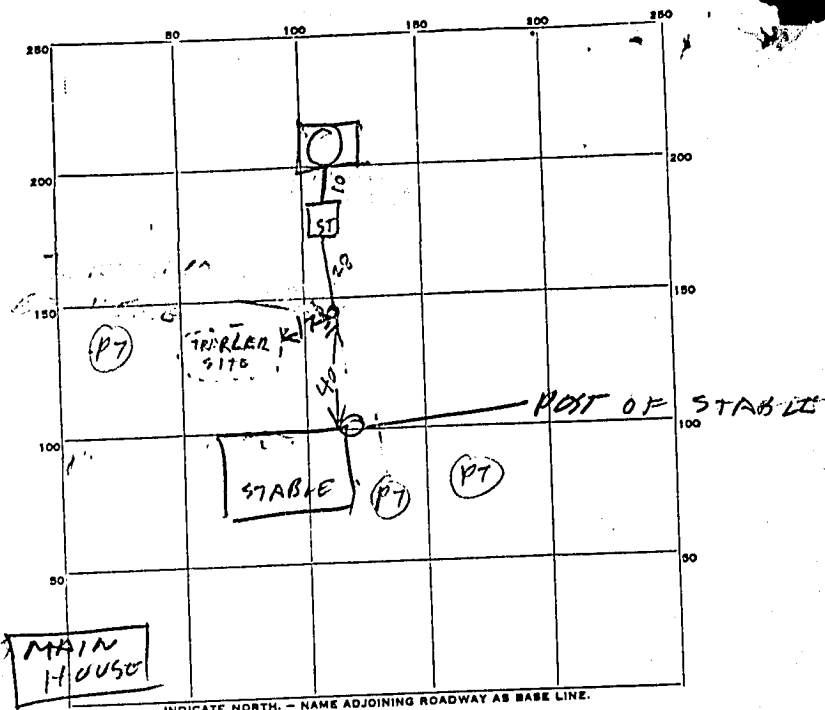

PERMIT CARD _____

SEPTIC TANK, LEVEL 1000

CLEANOUTS OK

DISTRIBUTION BOX, LEVEL _____

TILE FIELD, DEPTH _____ FT. TRENCH WIDTH _____ FT.

GRAVEL DEPTH _____ IN. TOTAL LENGTH _____ FT.

NUMBER OF TRENCHES _____ TOTAL BOTTOM AREA _____

SEEPAGE PITS, INSIDE DIAMETER _____ FT. DEPTH BELOW INLET 8 FT.

REMARKS ABSORBENT AREA 456 SQ. FT. COUNTING STONE
7/25/75 - DW INLET 4 FT DEEP BELOW GRADE
PERIMETER DW 57 FT - 3 BR. TRAILER 420
SQ FT REQUIRED LOCATION DW 150K
TRAILER TO GET WATER FROM HOUSE
WELL FOR MAIN HOUSE.

DATE SYSTEM APPROVED 7/25/75 INSPECTOR Raymond Hodges