

APPLICATION

A 08245

P _____

SEWAGE DISPOSAL TESTING

MARYLAND STATE DEPARTMENT OF HEALTH

HOWARD COUNTY

ELLICOTT CITY

Septic tank - 1,000 gal.

Drywell - 480 sq. ft. absorbent sidewall area
below inlet pipeDISTRICT 4DATE 4/3/64

Locate drywell 153 from back lot line and approximately
405 ft. from right side line in area treated as lot is
seen under facing it from Daisy Road.

TO: THE COUNTY HEALTH OFFICER
ELLICOTT CITY, MARYLANDI, HEREBY, APPLY FOR THE NECESSARY TESTS IN ORDER TO CONSTRUCT (OR RECONSTRUCT) A SEWAGE
DISPOSAL SYSTEM.PROPERTY OWNER Edward H. & Ruth P. David (David)Linthicum Heights, Md.ADDRESS 323 School Lane, P. O. Box 162 PHONE 8T 9-5376

PROPERTY LOCATION:

SUBDIVISION River Farms, Inc. LOT NO. _____ROAD AND DESCRIPTION Daisy Rd.

OCCUPANT _____ PHONE _____

PERSON TO CONSTRUCT SYSTEM, _____


ADDRESS _____ PHONE _____

SIZE OF LOT 30,710 acres TYPE BLDG. 4
NUMBER OF BEDROOMS

IF NOT SINGLE RESIDENCE DESCRIBE _____

SIGNATURE OF APPLICANT Edward H. DavidAPPROVED BY Ronald Fletcher FOR Drywell DATE 4/28/64
(KIND OF SYSTEM)REJECTED BY _____ FOR _____ DATE _____
(KIND OF SYSTEM)HOLD PENDING FURTHER TESTS Ronald Fletcher DATE 4/17/64REASONS FOR REJECTION OR HOLDING Needs more tests to determine
where persons said begin

THIS IS NOT A PERMIT

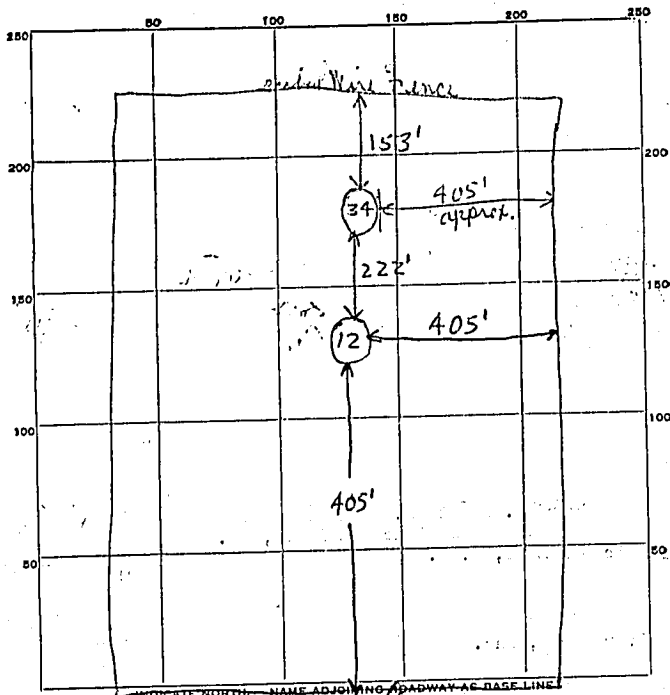

Daisy Road

DATE	TEST NO.	DEPTH	PRE-WET		TEST - 1" DROP		TIME
			START	STOP	START	STOP	
4/17/64	1	8 ft	1015	1030	1030	1047	17 min
	2	4 ft	1017				slow perc, did not make level in 30 minutes, stopped perc.
4/28/64	3	11 ft	1010	1015	1015	1027	12 min
	4	4 ft	1012	1018	1018	1027	9 min

SOIL AUGER FINDING

TESTED BY RDE 4/17/64 RDE 4/28/64

REMARKS RDE 4/17/64 soil clayish and saturated; needs more tests to determine where permeability begins, suggested 12' test with 6" shell

ALSO PRESENT Herman Spiky
4/28/64 Hummer Inc.

LOT NO.