

APPLICATION

A 08947

P _____

SEWAGE DISPOSAL TESTING

MARYLAND STATE DEPARTMENT OF HEALTH

HOWARD COUNTY

ELLCOTT CITY

Septic Tank: 3 bedroom - 750 gal
4 " 1000 galDISTRICT 4DATE 8/25/64

Dry Well - 120 sq ft sidewalk area below the inlet of
bedroom. Inlet pipe must be 4 ft below grade

Please Dry Well about 442 ft from wooded area on
rear of lot and about 596 ft from wooded area on left side
or rear when facing lot from Daisy Rd

TO: THE COUNTY HEALTH OFFICER
ELLCOTT CITY, MARYLAND

I, HEREBY, APPLY FOR THE NECESSARY TESTS IN ORDER TO CONSTRUCT (OR RECONSTRUCT) A SEWAGE DISPOSAL SYSTEM.

PROPERTY OWNER Howard H. David Roy DavisADDRESS 323 School Lane, Linthicum Heights, Md. PHONE _____

PROPERTY LOCATION: _____

SUBDIVISION River Farms LOT NO. _____ROAD AND DESCRIPTION Daisy Rd.

OCCUPANT _____ PHONE _____

PERSON TO CONSTRUCT SYSTEM _____ PHONE _____

ADDRESS _____ PHONE _____

SIZE OF LOT 20 acres TYPE BLDG. 3 or 4
NUMBER OF BEDROOMS


IF NOT SINGLE RESIDENCE DESCRIBE _____

SIGNATURE OF APPLICANT Howard TriplettAPPROVED BY Ed Monaghan FOR Dry Well DATE 9/29/64
(KIND OF SYSTEM)REJECTED BY _____ FOR _____ DATE _____
(KIND OF SYSTEM)

HOLD PENDING FURTHER TESTS _____ DATE _____

REASONS FOR REJECTION OR HOLDING 8/27/64 hold for survey & reclassification of
property owner DW

THIS IS NOT A PERMIT

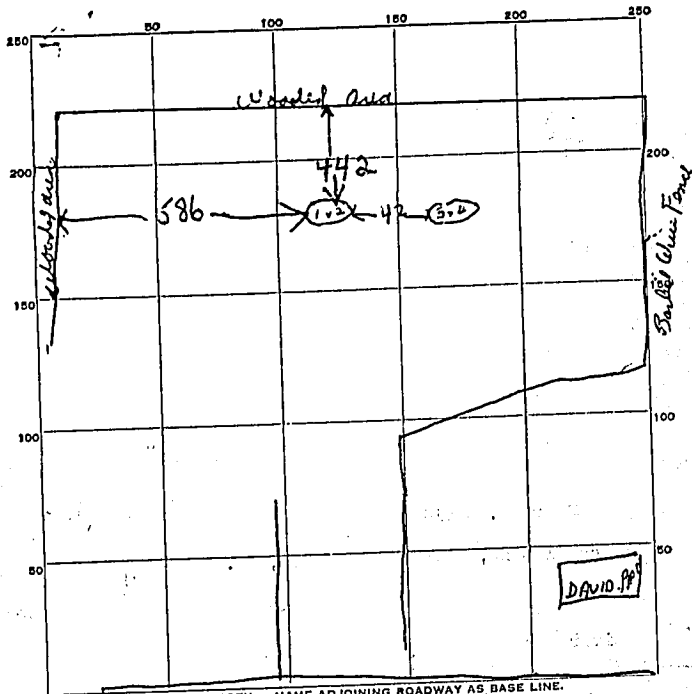

Darry Road

DATE	TEST NO.	DEPTH	PRE-WET		TEST - 1" DROP		TIME
			START	STOP	START	STOP	
8/27/61	1	9	1000	1013	1013	1027	14 min
	2	4	1001	1004	1004	1010	6 min
	3	9	1007	1020	1020	1034	14 min
	4	4	1009			1015	6 min
Well permit appl.			HO-65-W-384				

SOIL AUGER FINDING _____

TESTED BY *DWM-8/27/61*

REMARKS _____

ALSO PRESENT *Howard Triplett* LOT NO. _____