

APPLICATION

A 11502

SEWAGE DISPOSAL TESTING

P _____

MARYLAND STATE DEPARTMENT OF HEALTH

HOWARD COUNTY

ELLICOTT CITY

Septic Tank - 750 gal.

DISTRICT 4

Drywell - 12 ft. ~~dia.~~ dia. concrete top
with 2 ft. of gravel around edge making a total
dia. of 16 ft. Drywell to be 9 to 10 ft. deep below
inlet pipe. Inlet pipe to be 4 ft. below original grade.
Locate drywell 40 ft. from front lot line and 40 ft.
from left side of house as lot is seen when facing it
from Daisy Rd.

DATE 2/28/66TO: THE COUNTY HEALTH OFFICER
ELLICOTT CITY, MARYLAND

I, HEREBY, APPLY FOR THE NECESSARY TESTS IN ORDER TO CONSTRUCT (OR RECONSTRUCT) A SEWAGE DISPOSAL SYSTEM.

PROPERTY OWNER Robert M. WarfieldADDRESS Woodbine, Maryland PHONE 442-2240

PROPERTY LOCATION:

SUBDIVISION _____ LOT NO. _____

ROAD AND DESCRIPTION East Side of Daisy Rd. - about 1/2 to 3/4 miles north of Daisy.

OCCUPANT _____ PHONE _____

PERSON TO CONSTRUCT SYSTEM _____

ADDRESS _____ PHONE _____

SIZE OF LOT 10 acres TYPE BLDG. Residing
NUMBER OF BEDROOMS 3


IF NOT SINGLE RESIDENCE DESCRIBE _____

SIGNATURE OF APPLICANT Robert M. WarfieldAPPROVED BY R. Fletcher FOR Drywell DATE 3/8/66
(KIND OF SYSTEM)REJECTED BY _____ FOR _____ DATE _____
(KIND OF SYSTEM)

HOLD PENDING FURTHER TESTS _____ DATE _____

REASONS FOR REJECTION OR HOLDING _____

THIS IS NOT A PERMIT

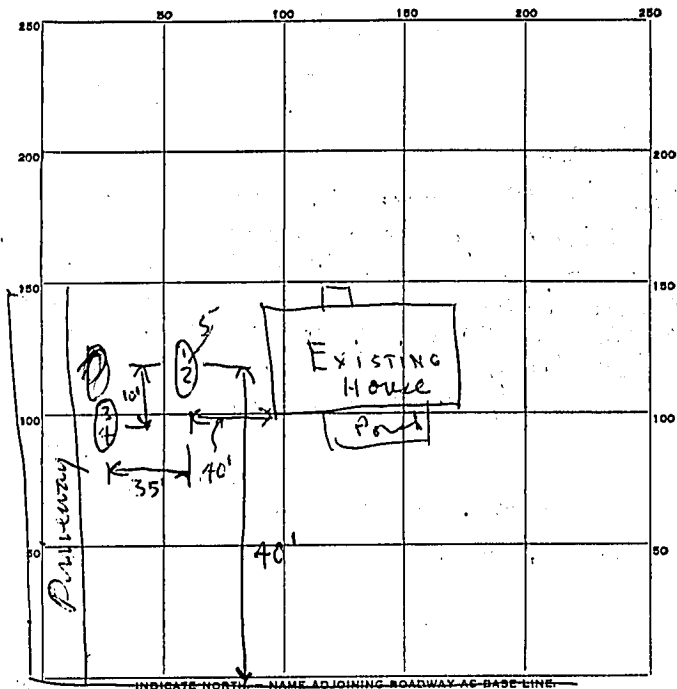

INDICATE NORTH - NAME ADJOINING ROADWAY AS BASE LINE.

Dairy Rd.

| DATE | TEST NO. | DEPTH | PRE-WET | | TEST - 1" DROP | | TIME |
|--------|--------------|--------|---------|-------|----------------|-------|---------|
| | | | START | STOP | START | STOP | |
| 3/8/66 | 1 | 4 ft. | 9:54 | Slow | Stop | Test | ✓ |
| | 2 | 9 ft. | 9:56 | 10:05 | 10:05 | 10:30 | 25 min. |
| | 3 | 4 ft. | 9:57 | Slow | Stop | Test | ✓ |
| | 4 | 9 ft. | 9:59 | 10:04 | 10:04 | 10:15 | 11 min. |
| | 5 | 13 ft. | 10:13 | 10:20 | 10:20 | 10:35 | 15 min. |
| | | | | | | | |
| | | | | | | | |
| | | | | | | | |
| | | | | | | | |

17
5 | 51
3
21

124-2 ft
9-10 ft.
62 in
4 ft.

SOIL AUGER FINDING *1st 4 ft. clay - Good from 4 ft. down*

TESTED BY *3/8/66 R.D.F. A.B.*

REMARKS *locate hole 4 ft. below original grade - R.F.*