

3/31/66 - Approved - J.H.K.

3/31/66
Ready

PERMIT

P 11647

A 11502

SEWAGE DISPOSAL SYSTEM

MARYLAND STATE DEPARTMENT OF HEALTH

HOWARD COUNTY

ELLICOTT CITY

DISTRICT 4

DATE 3/30/66

INDEXED

Herman Sirk IS PERMITTED TO INSTALL X ALTER

ADDRESS Annapolis Rock Rd., Woodbine, Md. PHONE HU 9-4724

A SEWAGE DISPOSAL SYSTEM LOCATED AT _____

SUBDIVISION _____ ROAD Daisy LOT _____

PROPERTY OWNER Robert M. Warfield

ADDRESS Woodbine, Maryland

SPECIFICATIONS - 3 bedrooms

DRAIN FIELD _____ DEPTH _____ FEET, BOTTOM AREA _____ SQ. FT.

SEEPAGE PITS _____ ABSORBENT SIDE-WALL AREA _____ SQ. FT.

SEPTIC TANK CAPACITY 750 GALLONS

FOR GARBAGE GRINDER, INCREASE DISPOSAL AREA 22% & TANK CAPACITY 50%.


OTHER Dry well - 12 ft. dia. concrete top with 2 ft. of gravel around edge making a total dia. of 16 ft. Dry well to be 9 to 10 ft. deep below inlet pipe. Inlet pipe to be 4 ft. below original grade. Locate dry well 40 ft. from front lot line and 40 ft. from left side of house as lot is seen when facing it from Daisy Rd.

PLANS APPROVED BY R. Fletcher DATE 3/8/66

FILL SEPTIC TANK AND DISTRIBUTION BOX WITH WATER BEFORE CALLING FOR AN INSPECTION. COVER NO WORK UNTIL INSPECTED AND APPROVED.

NEITHER THE HOWARD COUNTY COMMISSIONERS NOR THE HEALTH DEPARTMENT IS RESPONSIBLE FOR THE SUCCESSFUL OPERATION OF ANY SYSTEM.

A 11502

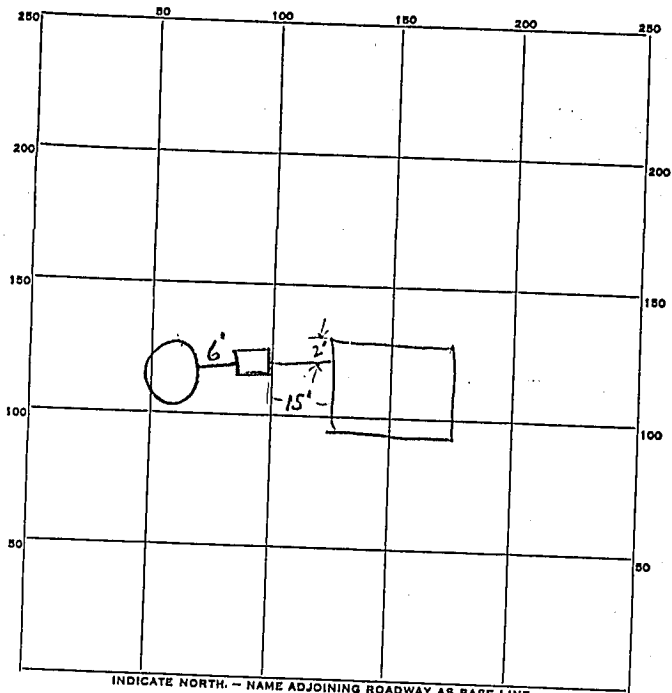

INDICATE NORTH. - NAME ADJOINING ROADWAY AS BASE LINE.

PERMIT CARD OK

Daisy Rd.

SEPTIC TANK, LEVEL OK

CLEANOUTS OK

DISTRIBUTION BOX, LEVEL _____

TILE FIELD, DEPTH _____ FT. TRENCH WIDTH _____ FT.

GRAVEL DEPTH _____ IN. TOTAL LENGTH _____ FT.

NUMBER OF TRENCHES _____ TOTAL BOTTOM AREA _____

SEEPAGE PITS, INSIDE DIAMETER 16 FT. DEPTH BELOW INLET 9 FT.

ABSORBENT AREA 452 SQ. FT.

REMARKS _____

DATE SYSTEM APPROVED 3/31/66

INSPECTOR G.H.K. Moore