

app - 7-31-75
sew

7/31/75

7/31/75
after 2 PM

PERMIT

P 21844
A 21539

SEWAGE DISPOSAL SYSTEM

MARYLAND STATE DEPARTMENT OF HEALTH

HOWARD COUNTY

ELLICOTT CITY
DISTRICT 4

DATE 7/16/75

INDEXED

Herman Sirk IS PERMITTED TO INSTALL ALTER

ADDRESS Jennings Chapel Road, Woodbine, Md. PHONE 489-4724

A SEWAGE DISPOSAL SYSTEM LOCATED AT _____

SUBDIVISION _____ ROAD Daisy Road LOT _____

PROPERTY OWNER Daisy United Methodist Church

ADDRESS _____

SPECIFICATIONS - 60 members

DRAIN FIELD _____ DEPTH _____ FEET. BOTTOM AREA _____ SQ. FT.

SEEPAGE PITS _____ ABSORBENT SIDE-WALL AREA _____ SQ. FT.

SEPTIC TANK CAPACITY 1,250 GALLONS

FOR GARBAGE GRINDER, INCREASE DISPOSAL AREA 22% & TANK CAPACITY 50%.

OTHER Two - 60 ft. trenches off of septic tank toward perc holes (1 & 2) and (7)

with 20 to 25 ft. between trenches. Six ft. of gravel under pipe and pipe inlet to trench to be from 2 to 3 1/2 ft. coming from septic tank. Requires 2 inspections (1st open and 2nd after pipe and gravel in)

NOTE: ALL PIPE FROM CHURCH TO DISPOSAL AREA MUST BE CAST IRON.

PERMIT VOID AFTER THREE YEARS.

NOTE: STAND PIPE MUST BE INSTALLED ON SEPTIC TANK. STAND PIPES MUST BE 6" IN DIA., CAST IRON, CONCRETE OR TERRA COTTA ACCEPTED.


PLANS APPROVED BY D. W. Monaghan DATE 6/17/75

FILL SEPTIC TANK AND DISTRIBUTION BOX WITH WATER BEFORE CALLING FOR AN INSPECTION. COVER NO WORK UNTIL INSPECTED AND APPROVED.

NEITHER THE HOWARD COUNTY COMMISSIONERS NOR THE HEALTH DEPARTMENT IS RESPONSIBLE FOR THE SUCCESSFUL OPERATION OF ANY SYSTEM.

A 21539

A 21589

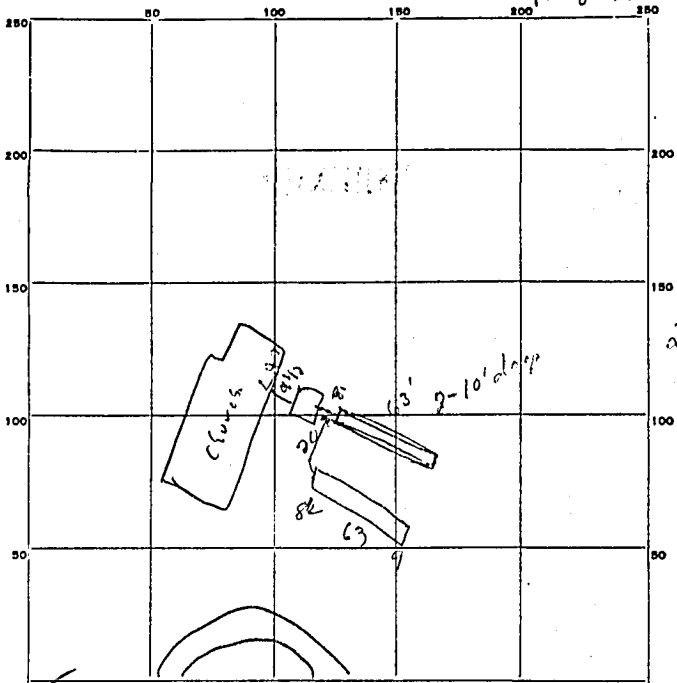

INDICATE NORTH. - NAME ADJOINING ROADWAY AS BASE LINE. Daisy Road

PERMIT CARD OK TO CONT 1/10/75 OK

SEPTIC TANK, LEVEL OK CLEANOUTS OK

DISTRIBUTION BOX, LEVEL NA

TILE FIELD, DEPTH 8-9 FT. TRENCH WIDTH 12 1/2 FT.

GRAVEL DEPTH 72 IN. TOTAL LENGTH 126 FT.

NUMBER OF TRENCHES _____ TOTAL BOTTOM AREA _____

SEEPAGE PITS, INSIDE DIAMETER _____ FT. DEPTH BELOW INLET _____ FT.

ABSORBENT AREA 756 SQ. FT. - 1 side of trench

REMARKS OK to use an 85' x 45' trench or 260' trench. id. 1204 7/24/75

Septic not installed at visit.

7-31-75 all pipe & trenches cast iron -

DATE SYSTEM APPROVED 7/31/75 INSPECTOR Bill Manna