

APPLICATION

SEWAGE DISPOSAL TESTING

A 05608

P 05688

MARYLAND STATE DEPARTMENT OF HEALTH

HOWARD COUNTY

ELLCOTT CITY 4

DISTRICT _____

DATE 8/10/62

Septic tank - 750 gal.

Dry Well - One Dry Well 10ft. diameter and 10ft deep below
the inlet pipe. Inlet pipe to be 3ft below original grade

Please Dry Well in area that passed percolation test.

10/6/62

TO: THE COUNTY HEALTH OFFICER
ELLCOTT CITY, MARYLAND

I, HEREBY, APPLY FOR THE NECESSARY TESTS IN ORDER TO CONSTRUCT (OR RECONSTRUCT) A SEWAGE DISPOSAL SYSTEM.

PROPERTY OWNER Ray Davis

ADDRESS Naisy Rd.

PHONE _____

PROPERTY LOCATION:

SUBDIVISION _____

LOT NO. _____

ROAD AND DESCRIPTION Naisy Rd. - about 2 1/4 miles

about 2 1/4 miles from Rt 144 on right
red flag or mailbox - about 2 1/4 miles from Naisy Church

OCCUPANT _____

PHONE _____

PERSON TO CONSTRUCT SYSTEM _____

ADDRESS _____

PHONE _____

SIZE OF LOT 52 acres

TYPE BLDG. 3

NUMBER OF BEDROOMS

IF NOT SINGLE RESIDENCE DESCRIBE _____

SIGNATURE OF APPLICANT Donald L. Hook

APPROVED BY Del. Thompson

FOR Dry Well

(KIND OF SYSTEM)

DATE 8-14-62

REJECTED BY _____

FOR _____

(KIND OF SYSTEM)


DATE _____

HOLD PENDING FURTHER TESTS _____

DATE _____

REASONS FOR REJECTION OR HOLDING _____

THIS IS NOT A PERMIT

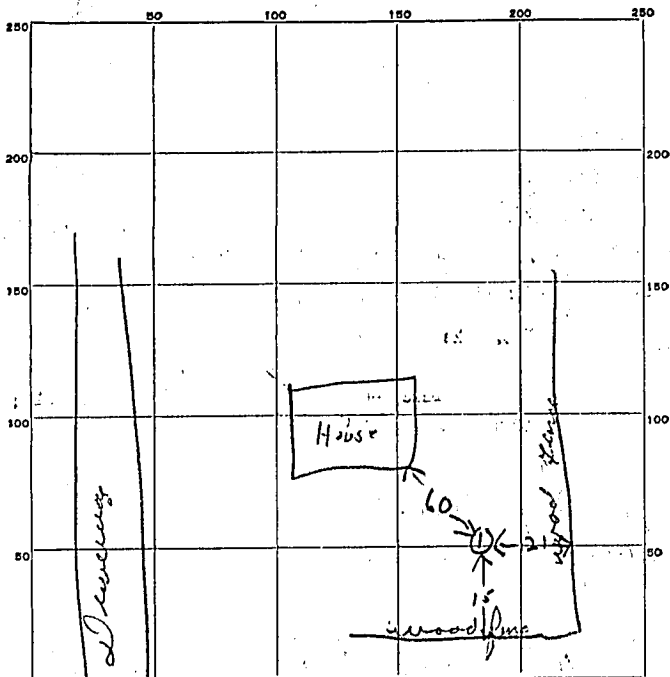

INDICATE NORTH - NAME ADJOINING ROADWAY AS BASE LINE.

Daisy Road

DATE	TEST NO.	DEPTH	PRE-WET		TEST - 1" DROP		TIME
			START	STOP	START	STOP	
8-14-62	1	9 ft	118	124	124	131	7 min

SOIL AUGER FINDING *find 3/4 clay*

TESTED BY *Dunn* 8-14-62

REMARKS _____

ALSO PRESENT *H. Smith* LOT NO. _____