

APPLICATION

SEWAGE DISPOSAL TESTING

MARYLAND STATE DEPARTMENT OF HEALTH

HOWARD COUNTY:

A 15477

P _____

ELLICOTT CITY

DISTRICT 4

DATE 5/25/71

TO: THE COUNTY HEALTH OFFICER
ELLICOTT CITY, MARYLAND

I, HEREBY, APPLY FOR THE NECESSARY TESTS IN ORDER TO CONSTRUCT (OR RECONSTRUCT) A SEWAGE DISPOSAL SYSTEM.

PROPERTY OWNER Woodrow W. Hagan and Ruth L. Hagan, his wife

ADDRESS R.D. #2, Woodbine, Maryland 21797 PHONE 489-7478

PROPERTY LOCATION: Rural

SUBDIVISION _____ LOT NO. _____

ROAD AND DESCRIPTION Daisy Road - Hard Surface

OCCUPANT _____ PHONE _____

PERSON TO CONSTRUCT SYSTEM Bollinger Bros.

ADDRESS Westminster, Maryland PHONE 848-5864

SIZE OF LOT Approximately 21 acres TYPE BLDG. Dwelling 3 bdrms.
NUMBER OF BEDROOMS

IF NOT SINGLE RESIDENCE DESCRIBE _____

Mt. Airy Builders & Contractors, Inc.

SIGNATURE OF APPLICANT _____


APPROVED BY [Signature] FOR Albert K. Ross, President DATE 6-15-71
(KIND OF SYSTEM)

REJECTED BY _____ FOR _____ DATE _____
(KIND OF SYSTEM)

HOLD PENDING FURTHER TESTS _____ DATE _____

REASONS FOR REJECTION OR HOLDING _____

THIS IS NOT A PERMIT

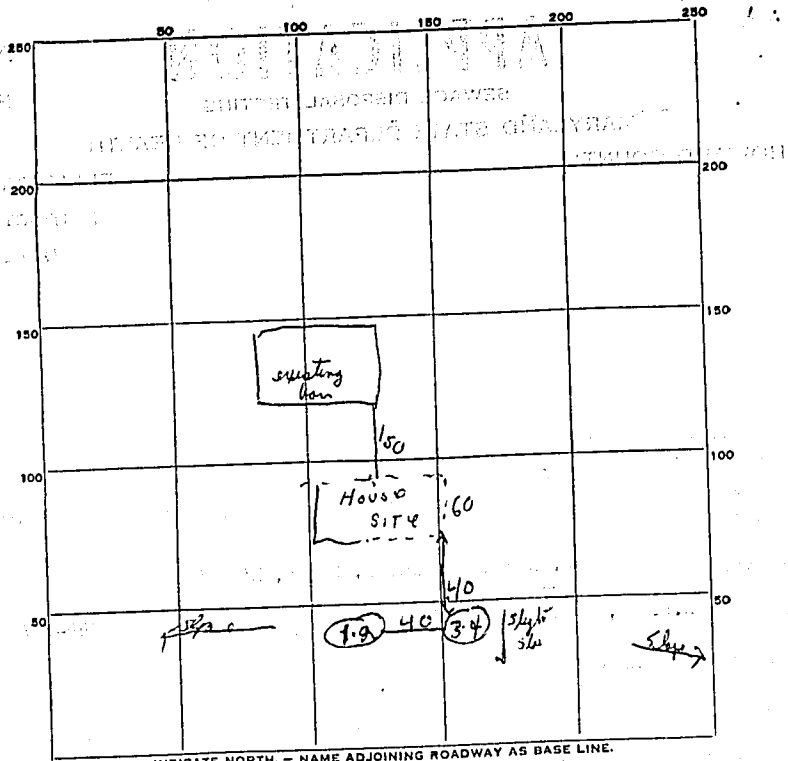


INDICATE NORTH. - NAME ADJOINING ROADWAY AS BASE LINE.

Dairy Road

DATE	TEST NO.	DEPTH	PRE-WET		TEST - 1" DROP		TIME	
			START	STOP	START	STOP		
6/18/71	1	4ft	10	20	10	32	8min	
	2	12ft	10	20	10	46	16min	
	3	7ft	not tested - some type soil					
	4	12ft	as pit 10' - some s. sh. b.					

SOIL AUGER FINDING _____
 TESTED BY dlm
 REMARKS _____

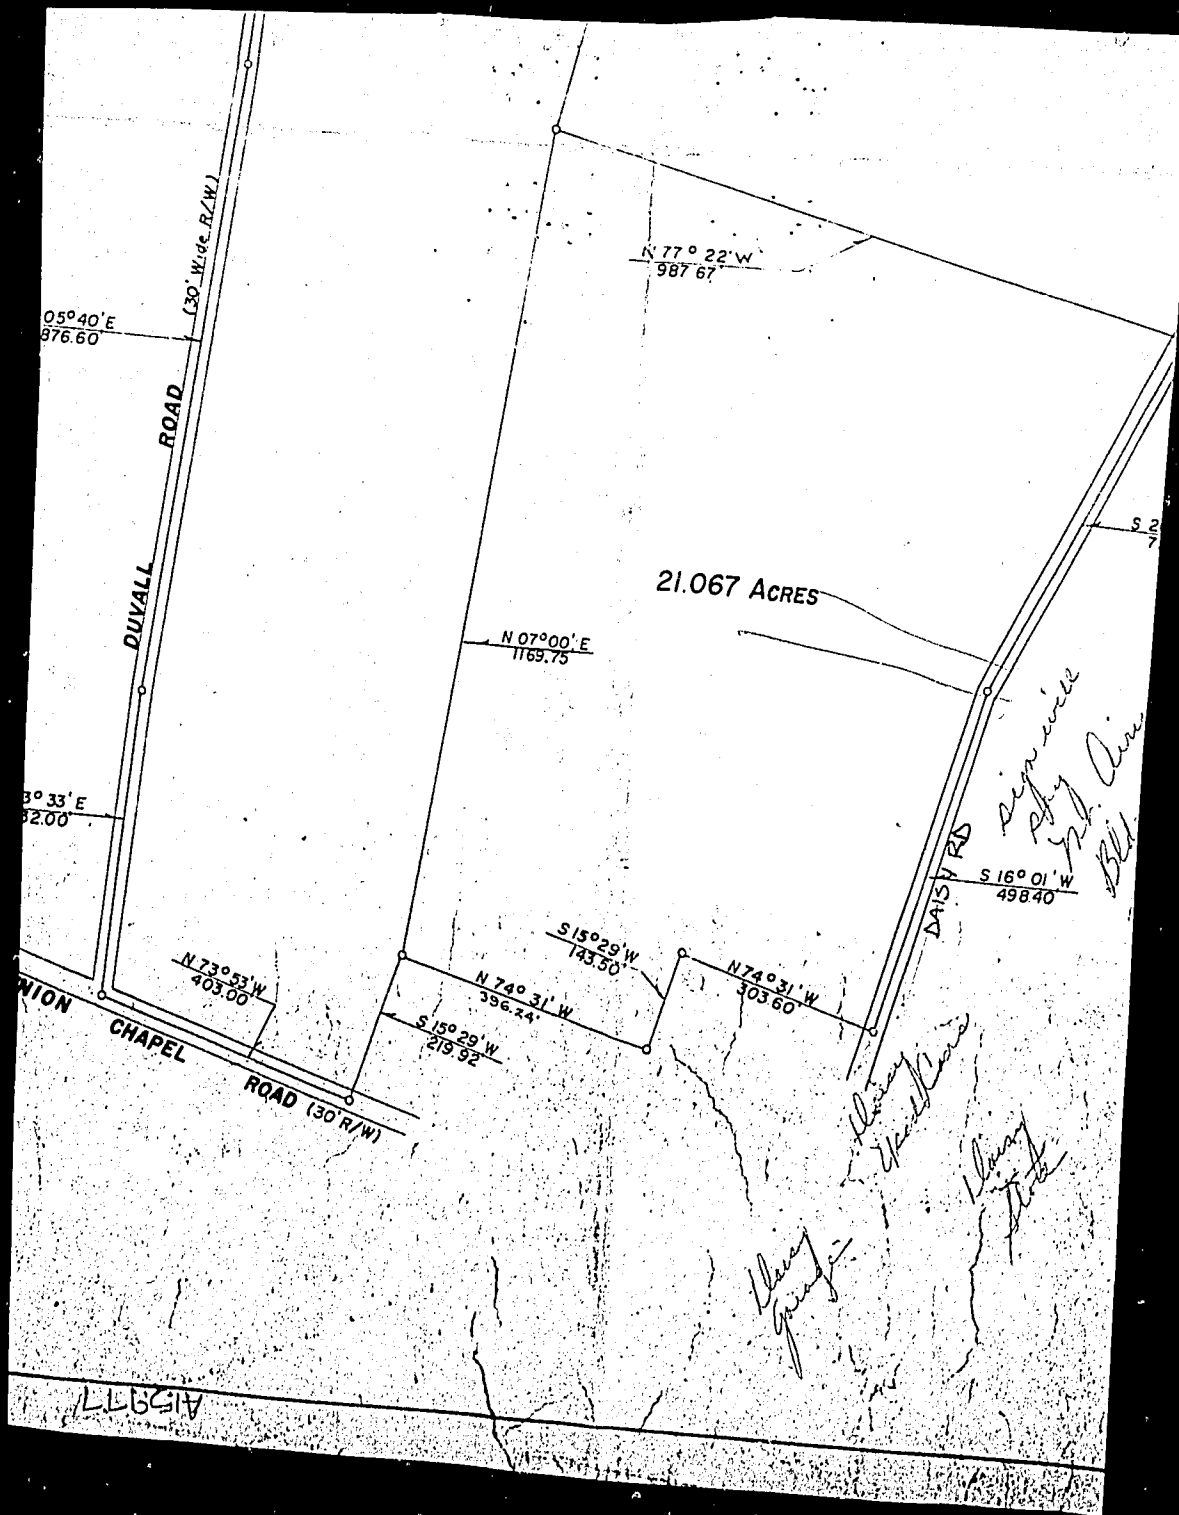

21.067 ACRES

sign will be by Mr. Ainslie

Honey

Honey

Honey

ASB