

APPLICATION

SEWAGE DISPOSAL TESTING

STATE OF MARYLAND - DEPARTMENT OF HEALTH AND MENTAL HYGIENE

A _____

P _____

HOWARD COUNTY HEALTH DEPARTMENT
ENVIRONMENTAL HEALTH SERVICES
P. O. BOX 476 ELLICOTT CITY, MARYLAND 21043
TELEPHONE: 992-2330

DISTRICT _____

DATE _____

TO: THE COUNTY HEALTH OFFICER
ELLICOTT CITY, MARYLAND

I HEREBY APPLY FOR THE NECESSARY TEST IN ORDER TO CONSTRUCT (OR RECONSTRUCT) A SEWAGE DISPOSAL SYSTEM.

PROPERTY OWNER JAMES BOGARD

ADDRESS 2850 DAISSY Rd., WOODBINE PHONE _____

PROPERTY LOCATION:

SUBDIVISION _____ LOT NO. _____

ROAD AND DESCRIPTION _____

SIZE OF LOT _____ TYPE BLDG. _____

(NUMBER OF BEDROOMS)

THE SYSTEM INSTALLED UNDER THIS APPLICATION IS ACCEPTABLE ONLY UNTIL PUBLIC FACILITIES BECOME AVAILABLE. I FULLY UNDERSTAND THE FEE CONNECTED WITH THE FILING OF THIS PERC TEST APPLICATION IS NON-REFUNDABLE UNDER ANY CIRCUMSTANCES. I ALSO AGREE TO COMPLY WITH ALL M.O.S.H.A. REQUIREMENTS IN TESTING THIS LOT.

(SIGNATURE OF APPLICANT)

APPROVED BY _____ FOR _____ DATE _____

REJECTED BY _____ FOR _____ DATE _____


HOLD PENDING FURTHER TESTS _____ DATE _____

REASONS FOR REJECTION OR HOLDING _____

THIS IS NOT A PERMIT

① SOIL PROFILE

0	AP
9"	BROWN CLAY LOAM <10% SAPROLITE
5'	BROWN SAND LOAM Slightly micaceous 10-20% SAPROLITE
10'	
12'	

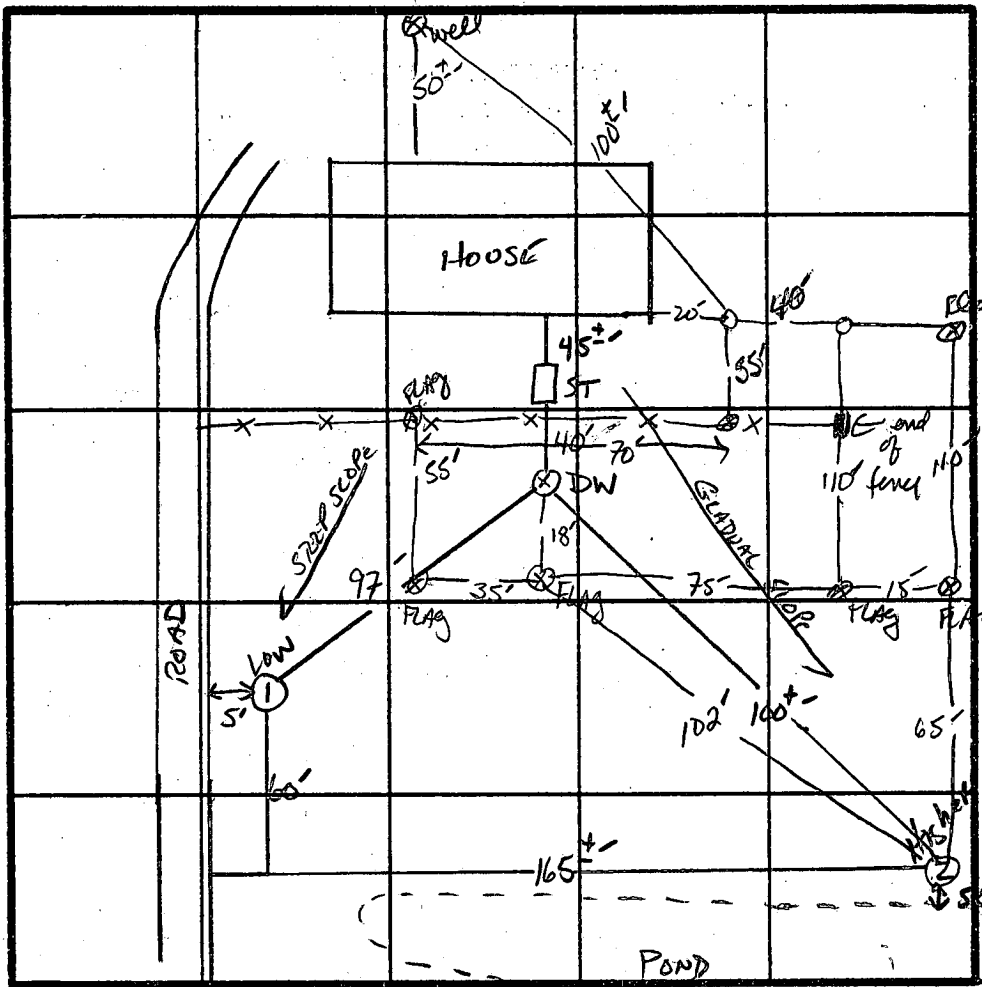

INDICATE NORTH - NAME ADJOINING ROADWAY AS BASE LINE.
TO DAISY Rd. ↓

②

0	AP
9"	BROWN CLAY LOAM <10% SAPROLITE
3'	BROWN micaceous SAND LOAM 20% SAPROLITE
13'	

DATE	TEST NO.	DEPTH	PRE-WET		TEST - 1" DROP		TIME
			START	STOP	START	STOP	
8/6/85	1V	WATER AT 10 FE	CLAY TO 5'				
	2V ⊗	13'	DRY TO 13 FE	GOOD SOIL	AFTER 3 FE		

REMARKS ⊗ Limits of BACKHOE / SUGGEST WET SEASON TEST FOR CONFIRMATION OF SOIL CONDITIONS AND WATER TABLE.

TYPE OF SOIL MANOK LOAM

TESTED BY EVALUATED - S. Abel

ARNOLD BACKHOE


ALSO PRESENT

NOT DRAWN TO SCALE

BOGARD'S PROPERTY


PROPERTY FENCE

NEW SEPTIC AREA


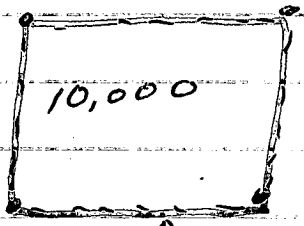


WOULD LIKE TO HAVE

NEW SEPTIC AREA

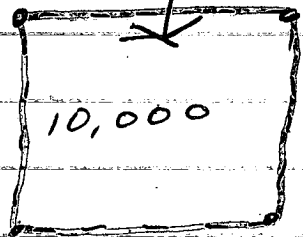

DRY STREAM MOST OF THE TIME

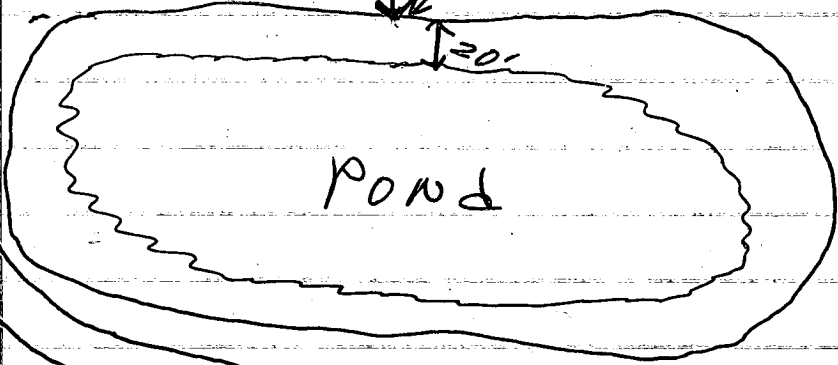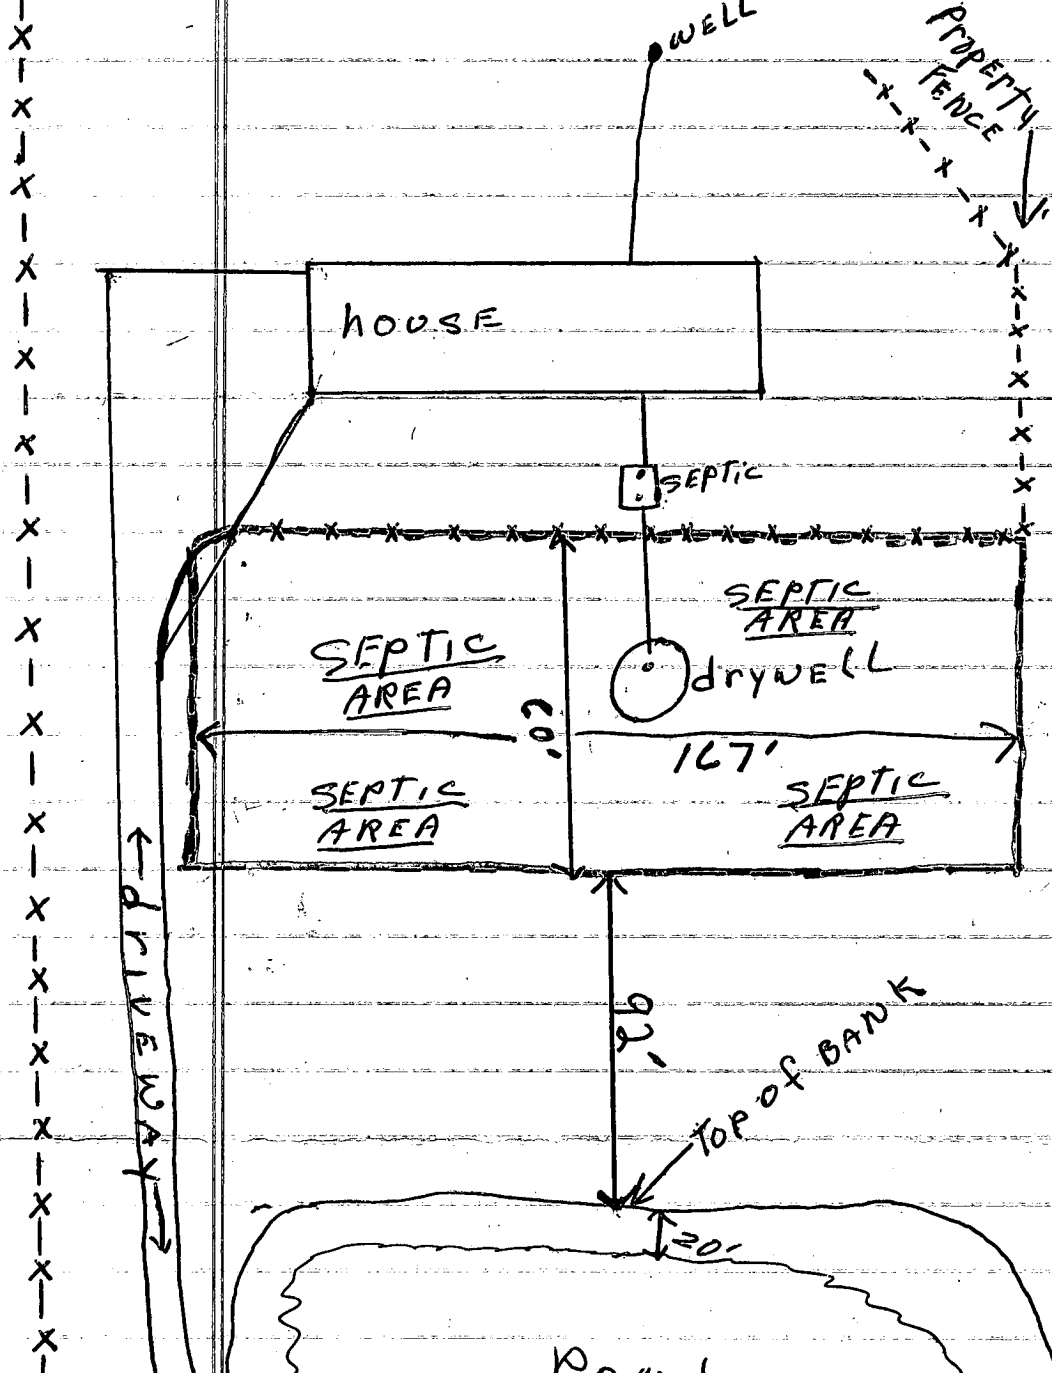

DAISY RD

ARNOLD'S SEPTIC SERVICE

P. O. Box 145
MT. AIRY, MARYLAND 21771

Mr. Williams;

Enclosed is a sketch of Mr. Bogards lot as seen from Daisy Road. The area below the fence is his proposed repair septic area which is 60 X 167 = 10,020 ft.

(As seen from Daisy Rd.)

Bud Arnold

