

LAYOUT 4/8/03 9:30 INSP 4 8:2203 12pm
 INSP 2 4/10/03 2:15-3:30 INSP 5 12pm 9/10/03
 INSP 3 4/15/03 3:30 INSP 6 Anytime 10/2/03 S.T. cover?

ISSUE DATE: 12/30/2002

P 518049

APPROVAL DATE: 9/16/03

PERMIT INDEXED
 04-366484

A 511939-B

**ON-SITE SEWAGE DISPOSAL SYSTEM
 HOWARD COUNTY HEALTH DEPARTMENT
 BUREAU OF ENVIRONMENTAL HEALTH**

K & K Excavating IS PERMITTED TO INSTALL ALTER
 ADDRESS: 14960 Frederick Rd, Woodbine PHONE NUMBER: 410-442-1336
 SUBDIVISION: Wellington III LOT NUMBER: 3
 ADDRESS: 2960 Hunt Valley Drive PROPERTY OWNER: Selfridge Builders
 SEPTIC TANK CAPACITY (GALLONS): 1500 OUTLET BAFFLE FILTER REQUIRED
 PUMP CHAMBER CAPACITY (GALLONS): 1500 COMPLETEMENT TANK REQUIRED
 NUMBER OF BEDROOMS: 5
 SQUARE FEET PER BEDROOM: 210
 LINEAR FEET OF TRENCH REQUIRED: 350 HOUSE SERVED BY PUBLIC WATER

**BUILDING PERMIT SIGNED
 AND RETURNED**
 4405 800153139-IG POOL

TRENCHES:	Trench to be <u>3.0</u> feet wide. Inlet 4.0 feet below original grade. Bottom maximum depth 6.0 feet below original grade. Effective area begins at 4.5 feet below original grade. 2.0 feet of stone below distribution pipe.
LOCATION:	Place the distribution box approximately midway between the two upper corner easement stakes. Run trenches on contour in both directions . <u>towards left + lot line (N)</u> <u>5-70' trenches</u>
NOTES:	The trenches for the initial system and repairs shouldn't be any further apart than 10' center to center, unless contour prevents this.

PLANS APPROVED: Brian Baker OK SRK 10/4/02 DATE: 9/24/2002

NOTES: PERMIT VOID AFTER 2 YEARS
 CONTRACTOR IS RESPONSIBLE FOR SCHEDULING A PRE-CONSTRUCTION INSPECTION FOR ALL INSTALLATIONS
 WATERTIGHT SEPTIC TANKS REQUIRED
 ALL PARTS OF SEPTIC SYSTEM SHALL BE 100 FEET FROM ANY WATER WELL UNLESS SPECIFICALLY AUTHORIZED
 MANHOLE RISERS REQUIRED ON ALL SEPTIC TANKS AND PUMP CHAMBERS UNLESS SPECIFICALLY AUTHORIZED
 CONTRACTOR RESPONSIBLE FOR COMPLIANCE WITH APPLICABLE REGULATIONS, GUIDELINES AND THE TERMS OF THIS PERMIT

NEITHER THE HOWARD COUNTY COUNCIL NOR THE HEALTH DEPARTMENT IS RESPONSIBLE FOR THE SUCCESSFUL OPERATION OF ANY SYSTEM PERMITTEE RESPONSIBLE FOR OBTAINING FINAL APPROVAL ON THIS PERMIT ALL 410-313-2640 FOR INSPECTION OF SEPTIC SYSTEM

9/10/03 - still 4' of cover on S.T., 5' on P.T. (SRK)
9/16/03 - SUPERINTENDENT (DOUG) FROM SELFTRIDGE SAID GRADING OVER TANKS WILL BE RESOLVED. WEATHER CONDITIONS STALLING WORK (SRK)
10/2/03 - GRADING RESOLVED (SRK)


5071939-B

NOT TO SCALE

4-16-03 pressure line 70'
to d. box already
covered. Distance from
end of trenches to pressure
line should be at least 5'
apart (KN)

TRENCH/DRAINFIELD DATA		
WIDTH	INLET	BOTTOM
3	4	6"
NUMBER OF TRENCHES		5
TOTAL LENGTH		350'
ABSORPTION AREA		
DISTRIBUTION BOX LEVEL		yes
DISTRIBUTION BOX BAFFLE		yes
DISTRIBUTION BOX PORT		yes

SEPTIC TANK DATA	
SEPTIC TANK 1 LEVEL	yes
CAPACITY	1500 GAL
SEAM LOC	top
TANK LID DEPTH	4'
BAFFLES	yes
BAFFLE FILTER	no
MANHOLE LOC	front
6" PORT LOC	none
WATERTIGHT TEST	no
SEPTIC TANK 2 LEVEL	yes
CAPACITY	1500 GAL
SEAM LOC	top
TANK LID DEPTH	4 1/2'
BAFFLES	yes
BAFFLE FILTER	no
MANHOLE LOC	end
6" PORT LOC	no
WATERTIGHT TEST	no

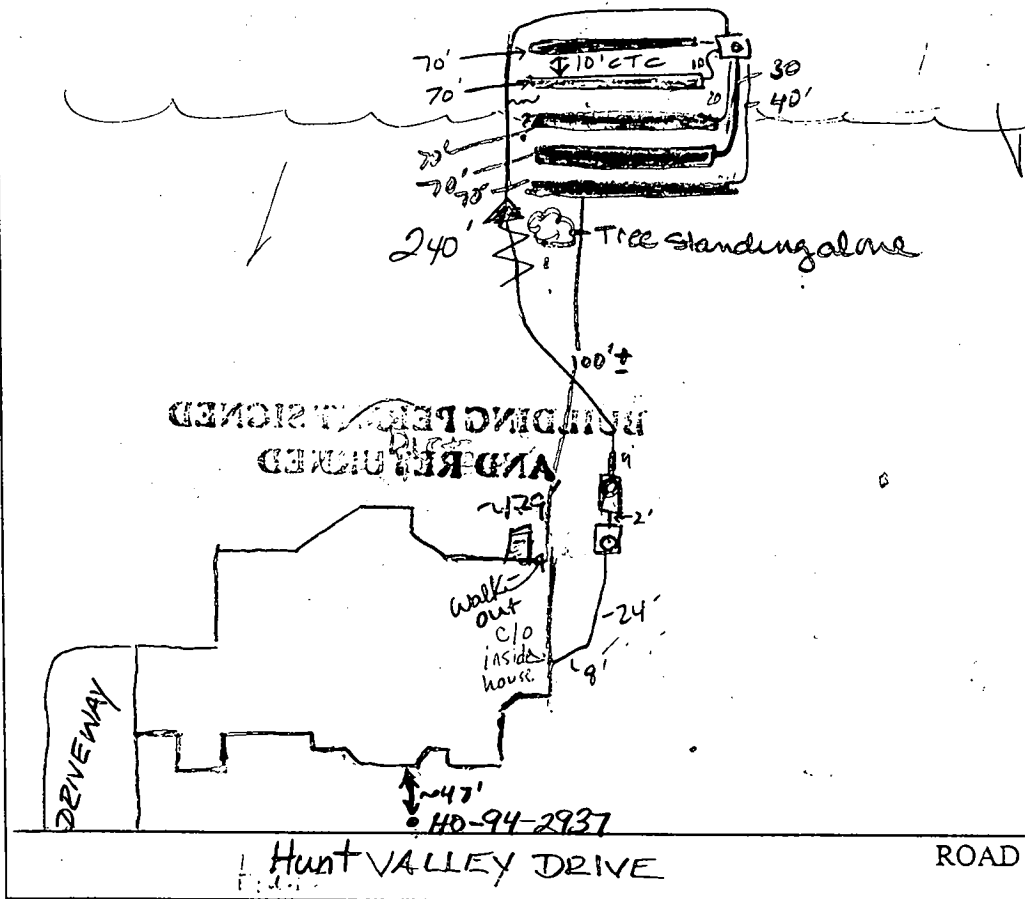


PRE-CONSTRUCTION 4/8/03 TOPD PER PLAN. AREA NOT STAKED FOR SDA; (OK) (NO)
 PLACE TANKS BUT NOT TRENCHES; DIST SHOULD BE 2129' FROM FRONT CORNER OF HOUSE; WALL CHECK SHOWS HOUSE TURNED SLIGHTLY CW FROM FROM PERMIT PLAN. (KN/VA)

4-10-03 SDA STAKED. TO CONSERVE TREES, RUN 5-70' TRENCHES TO THE (N) LEFT SIDE - MAY EXTEND SLIGHTLY OUT OF SDA EDGE - NO CONFLICTS. HOUSE CONNECTED UNDER FOOTING. TANK LID MAY BECOME MORE SHALLOW DUE TO GRADING AROUND HOUSE. SEPTIC TANKS NOT PLACED PER ENGINEER'S PLAN - MORE PARALLEL TO HOUSE. OK TO START TRENCHES (KN) 4/15/03 - ARE THESE LOAD BEARING LIDS? 4-16-03 Spoke to Super - Rob. Said will grade 1" ~~max~~ S.T.'s. OK TO COVER 1st TWO TRENCHES (KN) OK TO COVER

FINAL INSPECTOR Steven R. Krieger DATE OF APPROVAL 9/16/03

9/22/03 All TRENCHES. NEED Pump & ALARM TEST. (KN) Needs grading fix, too much cover (SO)

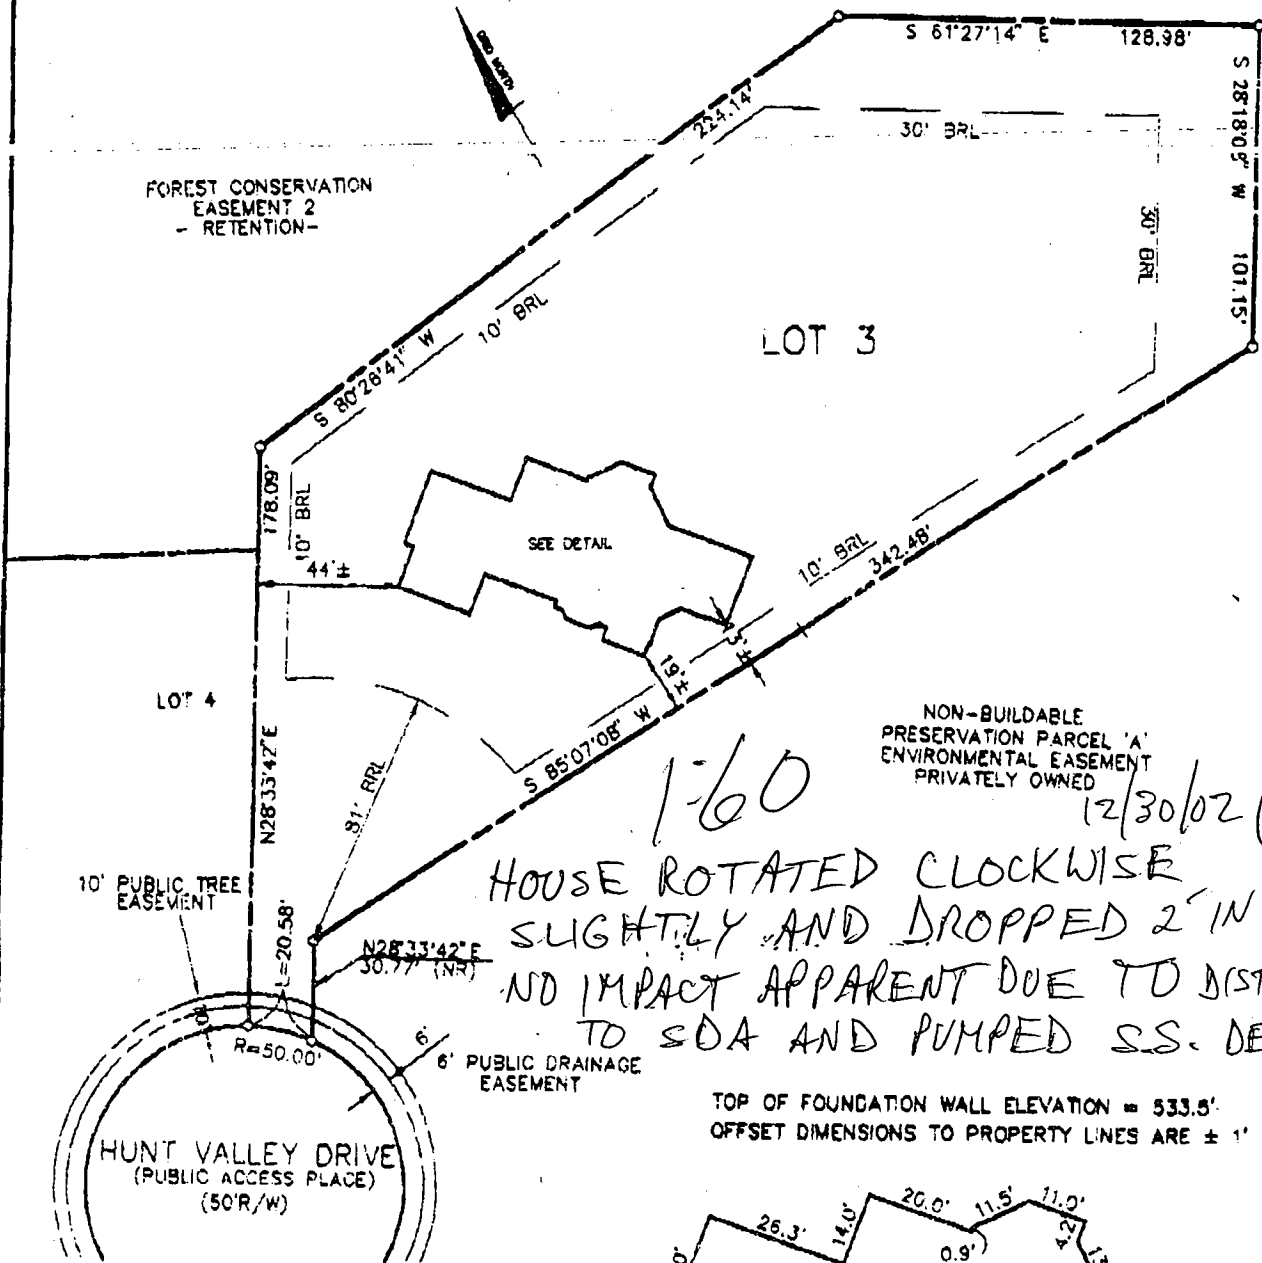


1-60
 HOUSE ROTATED CLOCKWISE
 SLIGHTLY AND DROPPED 2' IN FF EL.
 NO IMPACT APPARENT DUE TO DISTANCE
 TO SDA AND PUMPED S.S. DESIGN

NON-BUILDABLE
 PRESERVATION PARCEL 'A'
 ENVIRONMENTAL EASEMENT
 PRIVATELY OWNED

12/30/02 (MR)

TOP OF FOUNDATION WALL ELEVATION = 533.5'
 OFFSET DIMENSIONS TO PROPERTY LINES ARE ± 1'

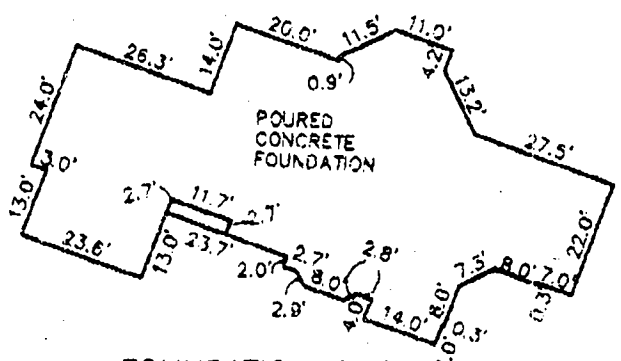

FOUNDATION DETAIL

SCALE: 1" = 30'

WALL CHECK
 THE WOODS OF
 WELLINGTON
 LOTS 1-24 AND
 NON-BUILDABLE PRESERVATION
 PARCELS 'A' THRU 'D'
 LOT No. 3

2960 HUNT VALLEY DRIVE

4TH ELECTION DISTRICT
 HOWARD COUNTY, MARYLAND

SCALE: 1" = 60' DATE: 11/08/02

SURVEYOR'S CERTIFICATE

I HEREBY CERTIFY TO THE BEST OF MY PROFESSIONAL KNOWLEDGE, INFORMATION AND BELIEF, THAT THE DIMENSIONS OF THE BUILDING WALLS SHOWN HEREON ARE CORRECT; THAT THEY ARE BASED ON A FIELD RUN SURVEY PERFORMED BY BENCHMARK ENGINEERING, INC. ON 11/08/02; AND THAT THE PROPERTY OUTLINE SHOWN HEREON IS BASED ON THE PLAT PREPARED BY BENCHMARK ENGINEERING, INC. ENTITLED "WOODS OF WELLINGTON LOTS 1-24 AND NON-BUILDABLE PRESERVATION PARCELS 'A' THRU 'D'", AND RECORDED AMONG THE LAND RECORDS OF HOWARD COUNTY AS PLAT No. 15288

David M. Harris

DAVID M. HARRIS
 REGISTERED PROFESSIONAL LAND SURVEYOR
 MD REG. No. 10978
 FOR BENCHMARK ENGINEERING, INC.
 MD REG. No. 351
 RECORD PLAT No. 15288
 FEMA FIRM No. 240044 0014 B
 ZONE: C
 DATED: 12/04/02

**BENCHMARK
 ENGINEERING, INC.**

2400 BALTIMORE NATIONAL PIKE & SUITE #110
 ELLETTT CITY, MARYLAND 21043
 PHONE 410-618-2100 & FAX 410-669-0044
 WWW: Benchmark.com



HOWARD COUNTY HEALTH DEPARTMENT
BUREAU OF ENVIRONMENTAL HEALTH
WATER AND SEWERAGE PROGRAM
TEL: (410)313-2640 FAX: (410)313-2648

Information Form for the Installation of the Well Pump, Pitless Adapter, and Supply Piping

NOTE: The installer is responsible for requesting an inspection prior to 9 am on the day of the desired inspection. No work is to be covered until approved by the Health Department. All installations must comply with the National Standard Plumbing Code (NSPC, as amended locally) and COMAR 26.04.04 (MD Well Construction Regulations). Submission of a complete form is required prior to Use and Occupancy approval.

Company Name: Pipe-Rite Plumbing Telephone #: 410-788-3680
Address: 405 Lafayette Ave
Baltimore, MD 21228

(Must circle one) Licensed Plumber Licensed Well Driller Licensed Well Pump Installer
License # and name of individual responsible for the field installation:
Name (Print): George Baker License# 2214

*A licensed individual must perform the actual installation. Apprentices must be under the direct supervision of a licensed journeyman or master plumber, pump installer or well driller. Licenses may be subjected to field verification.

Name of Property Owner: LCP 199C Telephone #:
Subdivision: Wellingston Lor #: 3 Well Tag #: HO-94-2937
Site Address: 2960 Hunt Valley Drive
Greenwood, MD 21738

Submersible Pump Data Pitless Adapter Well Cap and Electric Conduit
Make: MCGYLS Make: Bior (in sec) Two piece watertight cap: /
Model #: 35T-525 Model #: B10R Screened, vented well cap: /
Pump Capacity 8 GPM Depth: 48 (36" min) Cap secured to casing: /
Well Yield: 15 GPM NSF approved: / Conduit min 18" B.G.: /
Depth of well encountered at time of pump installation: 125 (feet) Conduit secured to well cap: /
If pump capacity exceeds well yield, a low water cut off switch is required by NSPC 1990 Section 17.8.4
Torque arrestors or Cable guards are required - Must circle one
Safety rope, if used, attached to inside of well casing with eye bolt

Piping to house House Connection
Type: Plastic PVC sleeved to undisturbed soil at wall penetration: /
P&I: 160 (160 psi min) Approximate length of sleeve: 5'
Depth of supply line: 45 (36" min) Sleeve caulked and sealed properly: /

The water supply line is required to be at least ten feet from the septic tank, pump chamber, sewage piping, distribution box, drainfields, and sewage reserve area. If this cannot be accomplished, contact this office for approval prior to installation.

Signature of company representative responsible for installation: George Baker date: 6-03-03

For Health Department Use Only - Not to be completed by Installer

Date Insp. Requested: 4/14/03 Date Insp. Approved: 4/14/03 (BB) SRK
Inspection Data: Pitless adapter and water supply line at least 36" below grade /
Two piece cap installed and attached to casing securely /
Elec. conduit extends at least 18" below grade/attached to cap properly /
Safety rope installed inside of well casing /
Correct well tag attached properly and casing 8" above finished grade /
Water supply line sleeved adequately at house connection /
Adequate grout observed below pitless adapter /

B 1 03761

SEQUENCE NO. (MDE USE ONLY)

STATE OF MARYLAND PERMIT TO DRILL WELL

STATE PERMIT NUMBER

NO - 94 - 2937

W514707 please print or type

fill in this form completely

Date Received (APA)

12/12/00

OWNER INFORMATION

Security Development Group, P.O. Box 417, Ellicott City Md 21041


LOCATION OF WELL

Howard Wellington, SECTION 3 LOT 3, Glenwood

DRILLER INFORMATION

Joseph L. Mayne MS D024, Joseph L. Mayne Well Drilling, 5512 Ridge Rd Mt. Airy 21771

DIRECTION OF WELL FROM TOWN (CIRCLE BOX)

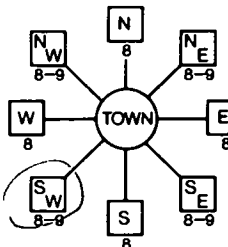

Hunt Valley Dr. NEAR WHAT ROAD

ON WHICH SIDE OF ROAD (CIRCLE APPROPRIATE BOX)



100 FT DISTANCE FROM ROAD

TAX MAP: BLK: PARCEL

WELL INFORMATION

APPROX. PUMPING RATE 5 GAL. PER MIN., AVERAGE DAILY QUANTITY NEEDED 500 GAL. PER DAY

NOT TO BE FILLED IN BY DRILLER HEALTH DEPARTMENT APPROVAL

Howard 13 COUNTY NAME COUNTY NO., DATE ISSUED 01/24/01, CO SIGNATURE, NORTH GRID 528 000, EAST GRID 0786 000

USE FOR WATER (CIRCLE APPROPRIATE BOX)

- DOMESTIC POTABLE SUPPLY & RESIDENTIAL IRRIGATION (circled), FARMING, INDUSTRIAL, PUBLIC WATER SUPPLY WELL, TEST, OBSERVATION, MONITORING, GEO-THERMAL

APPROXIMATE DEPTH OF WELL 260 FEET

APPROXIMATE DIAMETER OF WELL 6 INCH

METHOD OF DRILLING (circle one)

AIR-ROTary, AIR-PERCussion, ROTARY (Hydraulic Rotary), CABLE, REVerse-ROTary, Drive-POINT

REPLACEMENT OR DEEPEMED WELLS (CIRCLE APPROPRIATE BOX)

- THIS WELL WILL NOT REPLACE AN EXISTING WELL (circled), THIS WELL WILL REPLACE A WELL THAT WILL BE ABANDONED AND SEALED, THIS WELL WILL REPLACE A WELL THAT WILL BE USED AS A STANDBY-CONTACT LOCAL APPROVING AUTHORITY FOR POLICY ON STANDBY WELLS, THIS WELL WILL DEEPEM AN EXISTING WELL

Not to be filled in by driller (MDE OR COUNTY USE ONLY)

APPROP. PERMIT NUMBER HO 000G A P 013(01), PERMIT No HO 94 - 2937


SHOW MAJOR FEATURES OF BOX & LOCATE WELL WITH AN X

- SOURCES OF DRILLING WATER: 1. Well, 2., 3.

WRITE THE BOX NUMBER FROM THE MAP HERE

E 7500, N 5200

DRAW A SKETCH BELOW SHOWING LOCATION OF WELL IN RELATION TO NEARBY TOWNS AND ROADS AND GIVE DISTANCE FROM WELL TO NEAREST ROAD JUNCTION

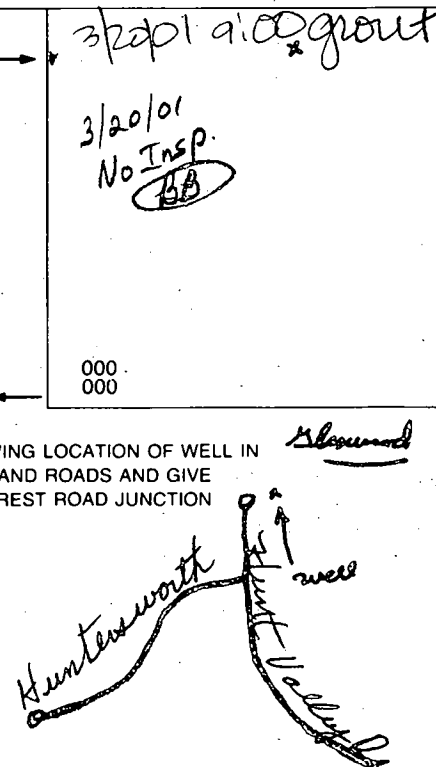

SPECIAL CONDITIONS

NOTE - APPROVING AUTHORITIES SHOULD USE SEPARATE SHEET IF NEEDED

CASHEMENT
RETENTION


LOT 4
50,000 S.F.

LOT 3
50,000 S.F.

1/24/01
well site
OK as stated
by surveyor -
NO drop made
DJO

WILSON-BULLDASH
RESERVATION MAP
HOWARD COUNTY AGRICULTURE
PRESERVATION PROGRAM
2007/08

FOREST CONSERVATION
CASHEMENT 2
RETENTION

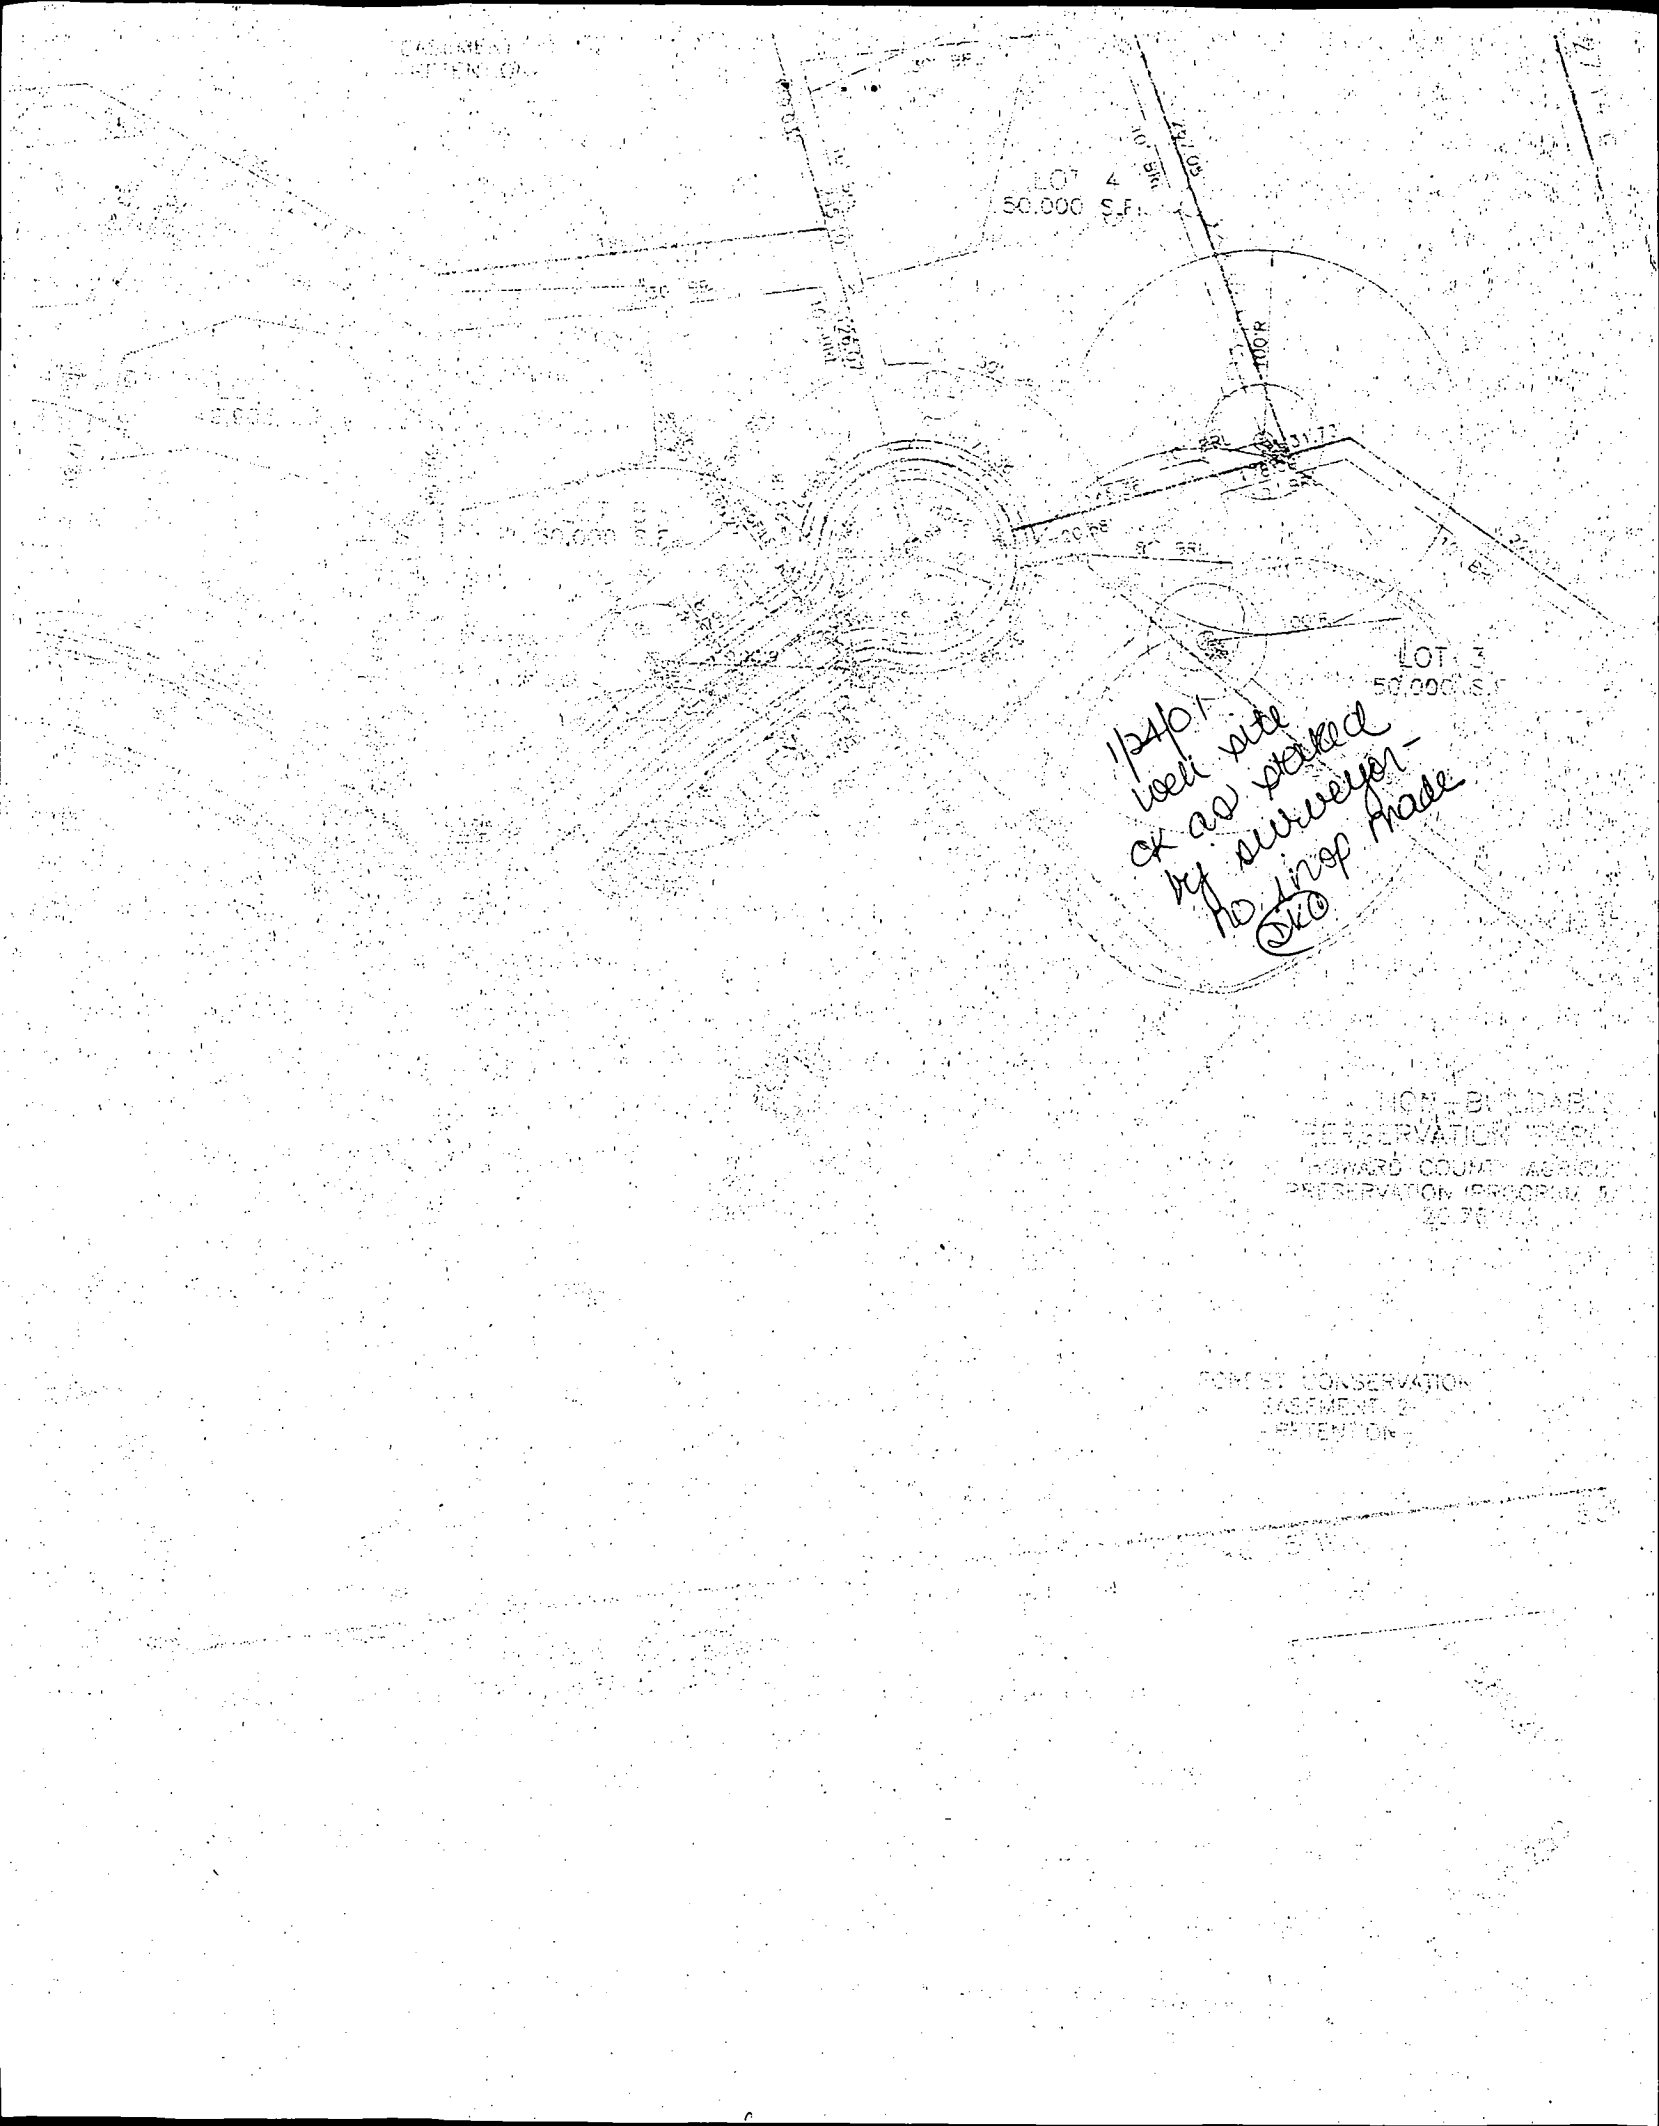

APPLICATION

PERCOLATION TESTING

A _____

P _____

DISTRICT _____

DATE _____

HOWARD COUNTY HEALTH DEPARTMENT
BUREAU OF ENVIRONMENTAL HEALTH
3525-H ELLICOTT MILLS DRIVE/ELLICOTT CITY, MARYLAND 21043
TELEPHONE: 313-2640

APRIL 21-28
MAY 13-14
12

TO: THE COUNTY HEALTH OFFICER
ELLICOTT CITY, MARYLAND

I HEREBY APPLY FOR THE NECESSARY TEST PRIOR TO APPLICATION FOR PERMIT TO CONSTRUCT (OR RECONSTRUCT) A SEWAGE DISPOSAL SYSTEM.

PROPERTY OWNER Mick Curvey

ADDRESS P.O. Box 417 E. Md 2104 PHONE 410-465-4244

AGENT OR PROSPECTIVE BUYER ~~Hunter Valley Dr~~ SDC Group

ADDRESS _____ PHONE 410-443-2509931

PROPERTY LOCATION:

SUBDIVISION Wellington 3 LOT NO. LOT-1 thru 20 (6) (3)

ROAD AND DESCRIPTION End of Hunt Valley Dr. Glenwood Md.

TAX MAP 14 PARCEL # 246

SIZE OF LOT 1 acre TYPE BLDG. Single Family Dwelling
(SINGLE FAMILY DWELLING OR COMMERCIAL)

THE SYSTEM INSTALLED UNDER THIS APPLICATION IS ACCEPTABLE ONLY UNTIL PUBLIC FACILITIES BECOME AVAILABLE. I FULLY UNDERSTAND THE FEE CONNECTED WITH THE FILING OF THIS PERC TEST APPLICATION IS NON-REFUNDABLE UNDER ANY CIRCUMSTANCES. I ALSO AGREE TO COMPLY WITH ALL M.O.S.H.A. REQUIREMENTS IN TESTING THIS LOT.

B.M. Curvey B.M.
(SIGNATURE OF APPLICANT)

APPROVED BY _____ FOR _____ DATE _____

DISAPPROVED BY _____ FOR _____ DATE _____

HOLD PENDING FURTHER TESTS _____

REASONS FOR REJECTION OR HOLDING _____

PERCOLATION TEST PLAT/PRELIMINARY PLAT - TITLE OR I.D. # _____ DATE _____

SITE DEVELOPMENT PLAN/FINAL PLAT - TITLE OR I.D. # _____ DATE _____

THIS IS NOT A PERMIT


COUNTY #

SOIL PROFILE

0' 6A
 1' topsoil
 red brn
 cl lm
 4.5'
 pale org
 tan
 Si lm
 10% - 15%
 rock
 frag

0' 6D
 1' topsoil
 org red
 brn
 cl lm
 4.5'
 tan
 Si lm
 20-25%
 hard
 rock

0' 6C
 1' topsoil
 red org
 brn
 cl lm
 4.5'
 pale
 org brn
 sil lm
 25%
 hard
 rock

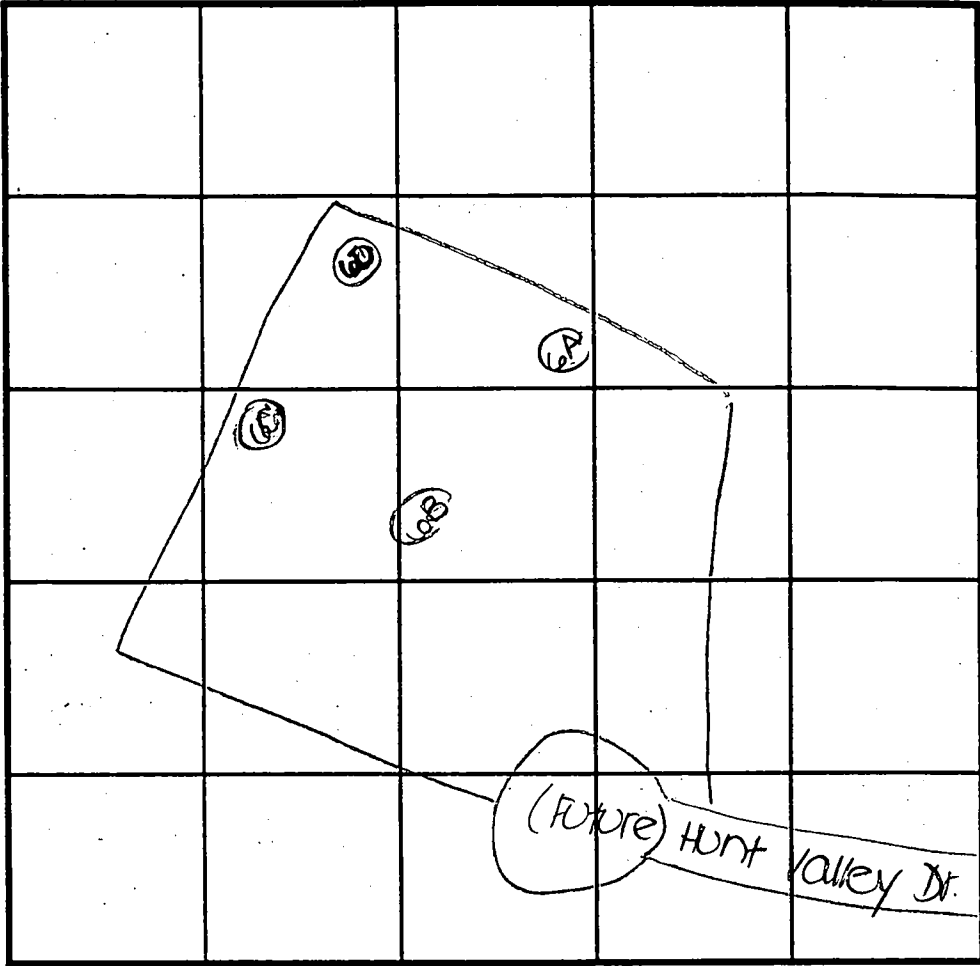

SOIL PROFILE


0' 6B
 1' topsoil
 org red
 brn
 cl lm
 5'
 beige
 Si lm
 15%
 rock
 frag

1st system (A) (B)
~~In 13, 210 & BK~~
~~In 4' bot 8~~
~~2nd & 3rd sys~~
~~In 4 1/2' bot 6 1/2'~~

INDICATE NORTH - NAME ADJOINING ROADWAY AS BASE LINE.

DATE	TEST NO.	DEPTH	PRE-WET		TEST - 1" DROP		TIME
			START	STOP	START	STOP	
4-28-99	6A	5.0'S	10:22	10:25	10:25	10:29	4
		12.5'D	Visual	- see	profile		OK
	6D	5.0'S	10:24	10:27	10:27	10:32	5
		12.5'D	Visual	- see	profile		OK
	Don't extend depth to 6C	4.5'S	10:35	10:42	10:42	10:50	8
		12.5'D	Visual	- see	profile		OK
	6B	5.0'S	10:35	10:48	10:48	11:09	21
		13.0'D	Visual	- see	profile		OK

REMARKS _____
 TYPE OF SOIL < shallow system only >
 TESTED BY D. See ALSO PRESENT Hatfield's
 TRENCH DESIGN DATA: AVERAGE PERCOLATION TIME _____ TRENCH WIDTH _____
 INLET DEPTH _____ MAXIMUM BOTTOM DEPTH _____ SQ. FT./BEDROOM _____

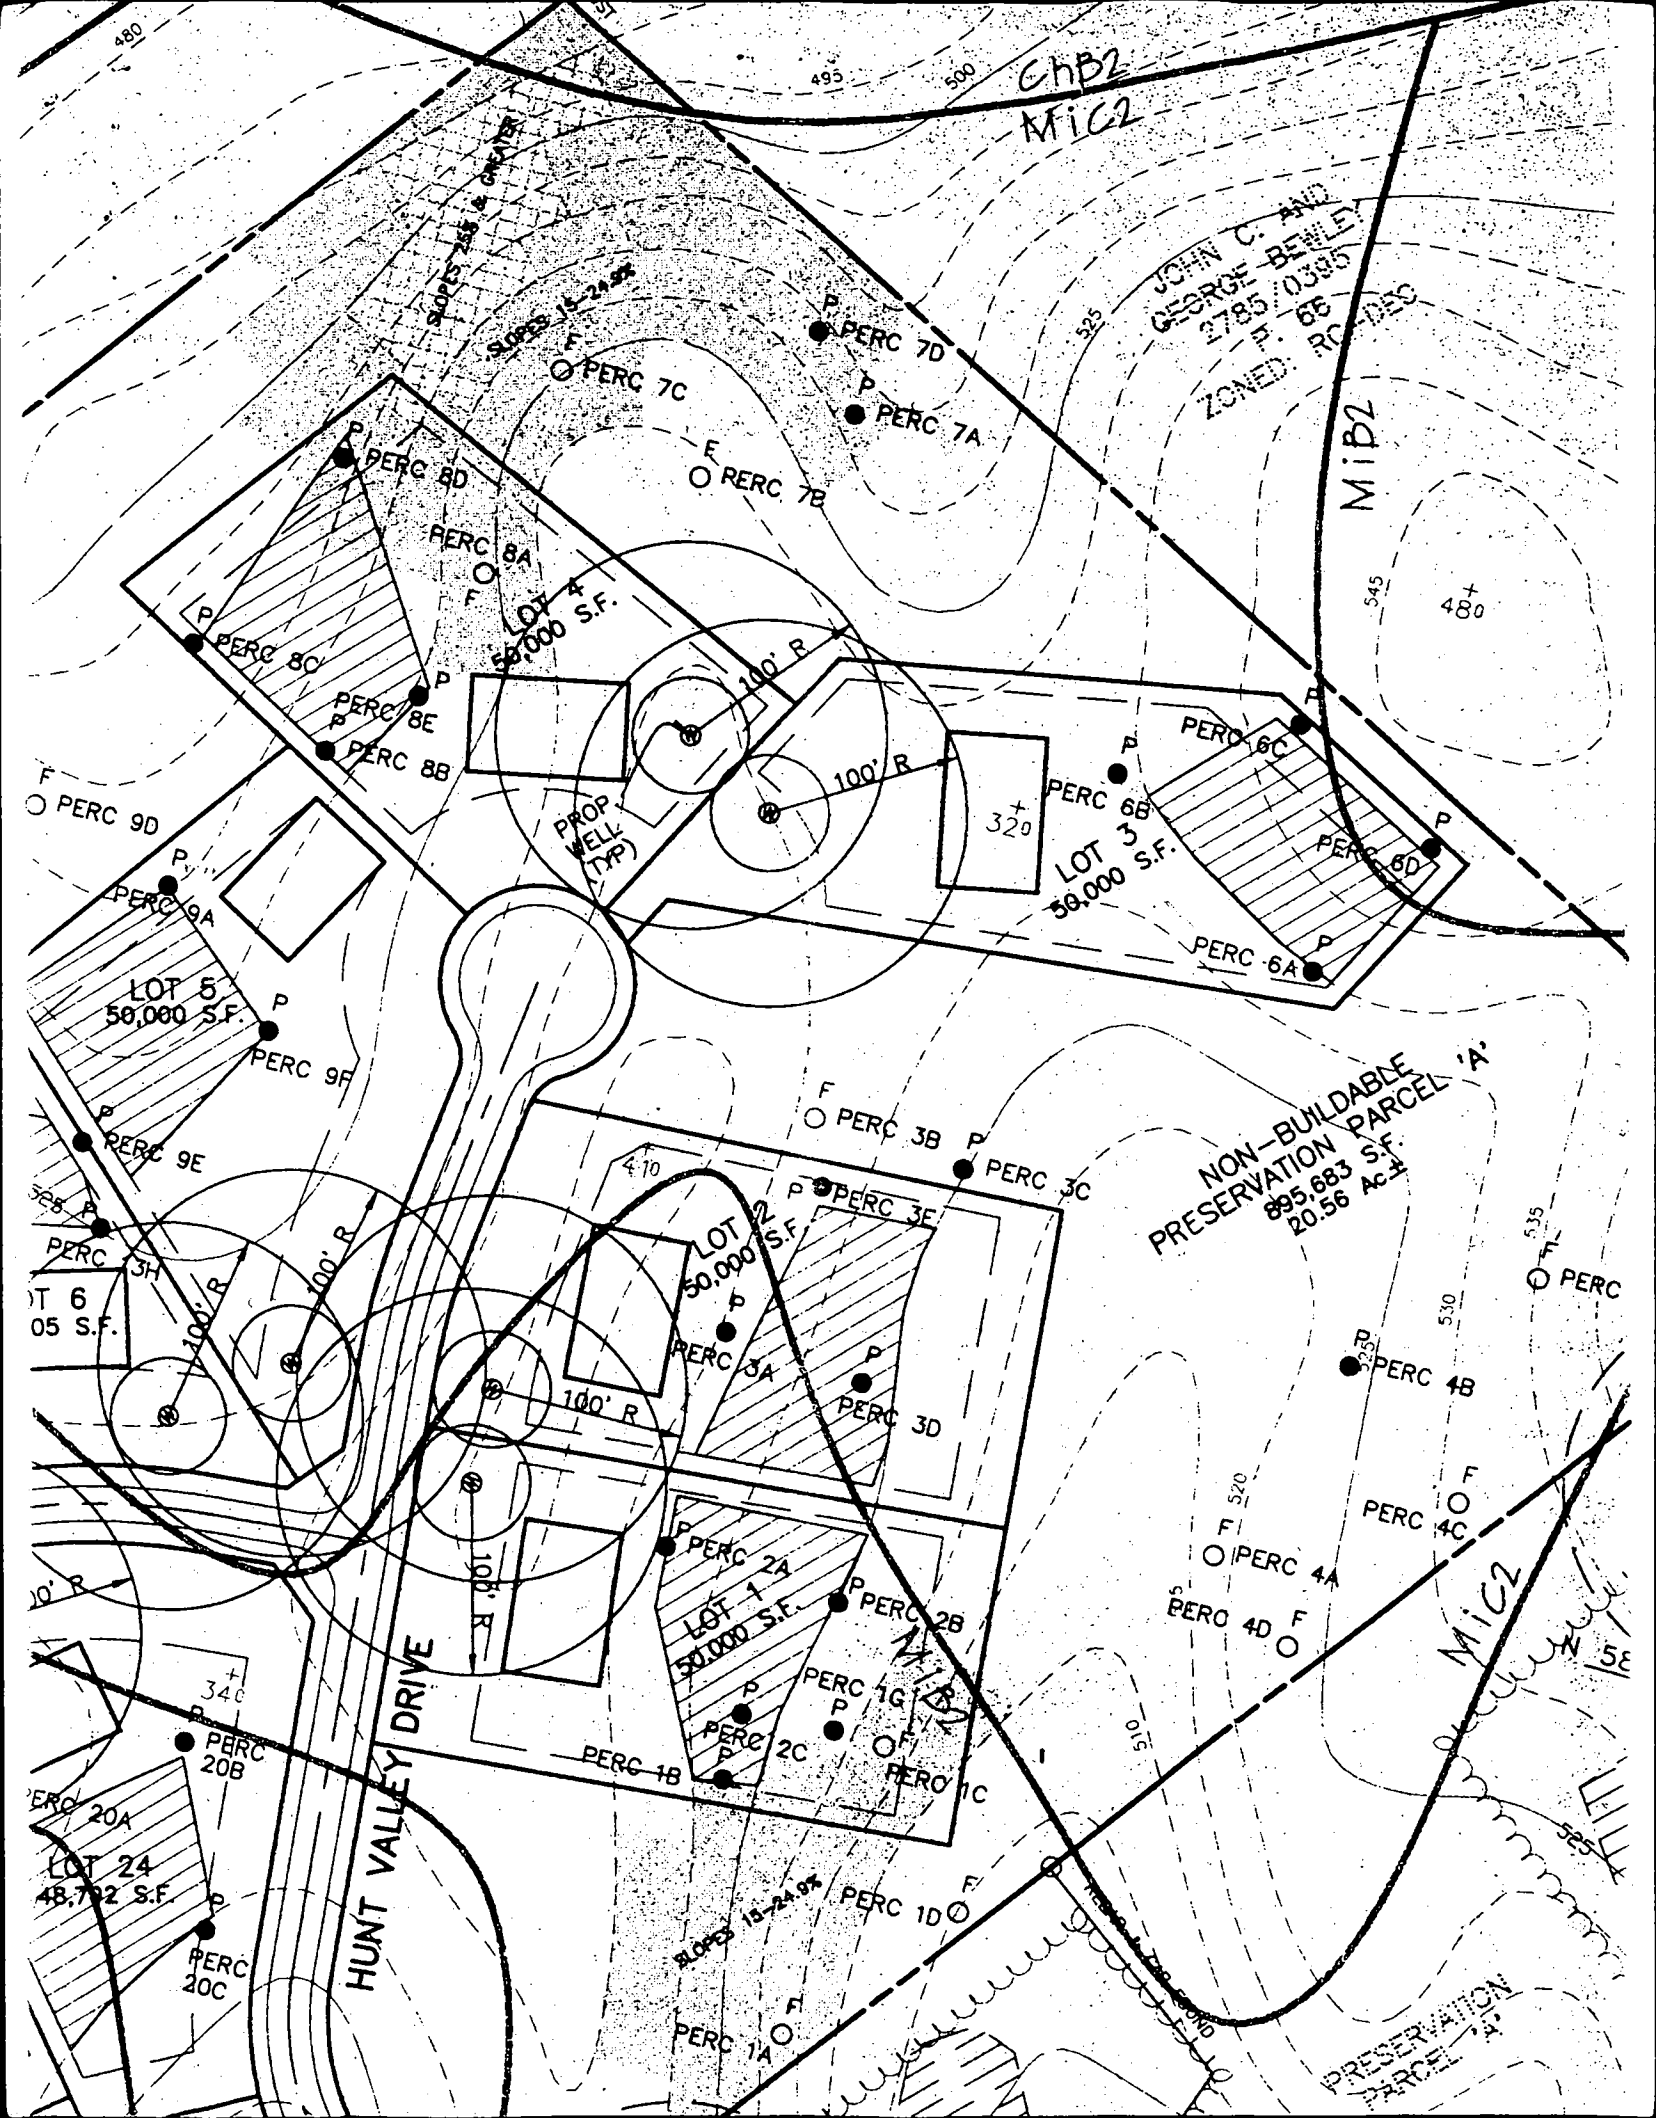

CHB2
MIC2

JOHN C. AND
GEORGE BEWLEY
2785-0385
P. 68
ZONED: ROLLING

MIB2

NON-BUILDABLE
PRESERVATION PARCEL 'A'
895,683 S.F.
20.56 Ac.


MIC2

HUNT VALLEY DRIVE

PRESERVATION
PARCEL 'A'

RETENTION-
 TOTAL AREA 15.53± ACRES
 AREA THIS SHEET 8.12± ACRES

JOH
 GEOR
 27
 ZONE

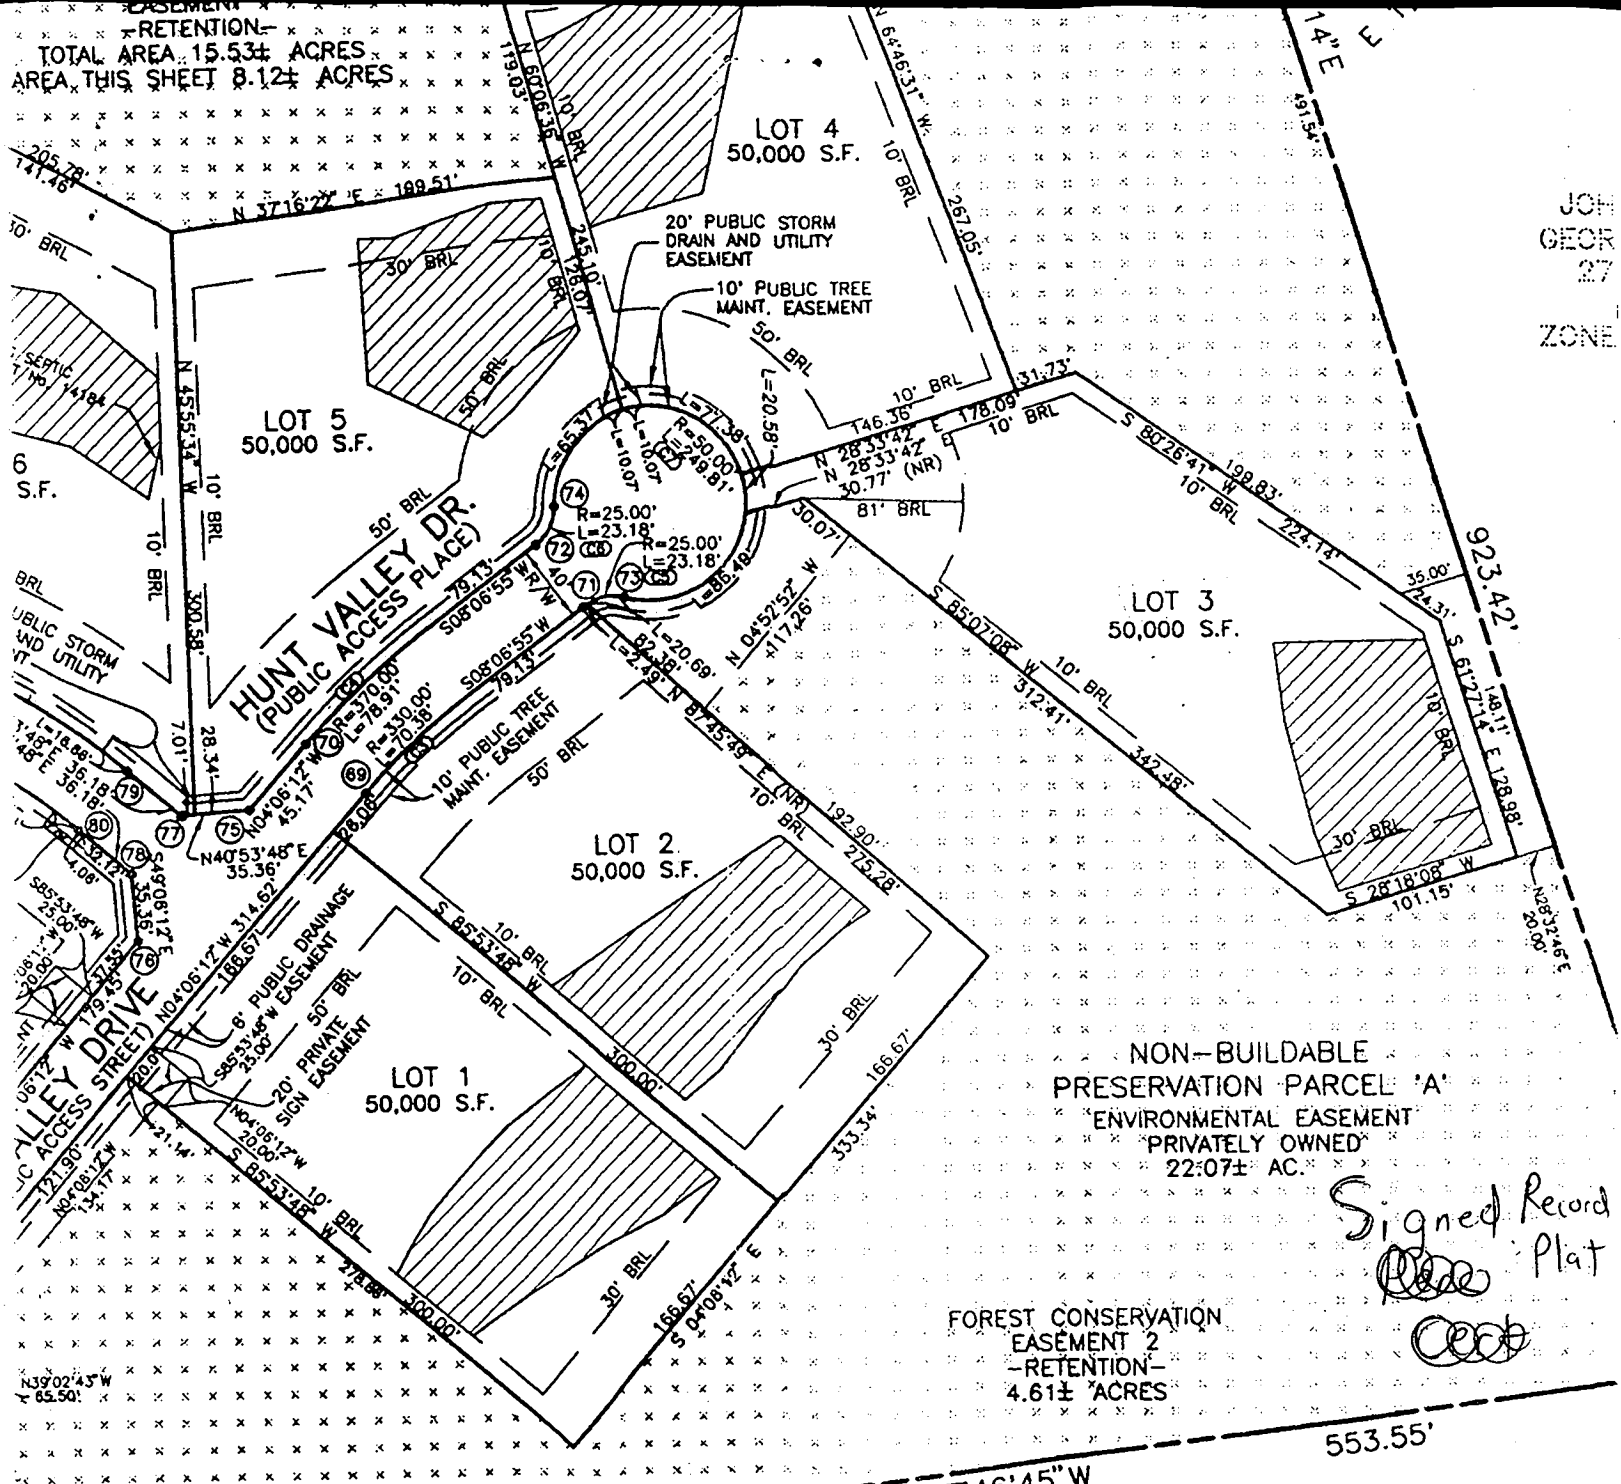

NON-BUILDABLE
 PRESERVATION PARCEL 'A'
 ENVIRONMENTAL EASEMENT
 PRIVATELY OWNED
 22:07± AC.

Signed Record
 Plat
[Signature]

FOREST CONSERVATION
 EASEMENT 2
 -RETENTION-
 4.61± ACRES

N/F
 PRES. PARCEL B
 ENVIRONMENTAL
 PRES. EASEMENT
 N/F
 WELLINGTON 2/1
 PLAT NO. 12206
 ZONED: RC-DEC

THE REQUIREMENTS § 3-10
 ANNOTATED CODE OF MARY
 (AS SUPPLEMENTED) AS FA
 OF THIS PLAT AND THE SE
 COMPLIED WITH.

[Signature]
 DAVID M. HARRIS
 REGISTER PROFESSIONAL L
 MD. REGISTRATION NUMBER
 FOR BENCHMARK ENGINEER
 MD. REGISTRATION NUMBER


EX. FOREST CONSERVATION
 EASEMENT
 SURVEYOR PLAT NUMBER 12206
BENCHMARK ENGINEERING, INC.
 SUITE 418
 8480 BALTIMORE NATIONAL PIKE
 ELLICOTT CITY, MARYLAND 21043
 410-465-6105

[Signature]
 SIGNATURE OF OWNER
 STEVEN BREEDEN, VP
 SDC GROUP, INC.


THE SOLE AND ONLY PURPOSE OF

LOT 73
 REVERTIBLE GRADING
 EASEMENT PER
 PLATS 10519 AND 12206
 (BOTH SIDES)
 EXISTING
 SEPTIC
 PER PLAT
 No. 12206

REBAR & CAP FOUND
 (230)

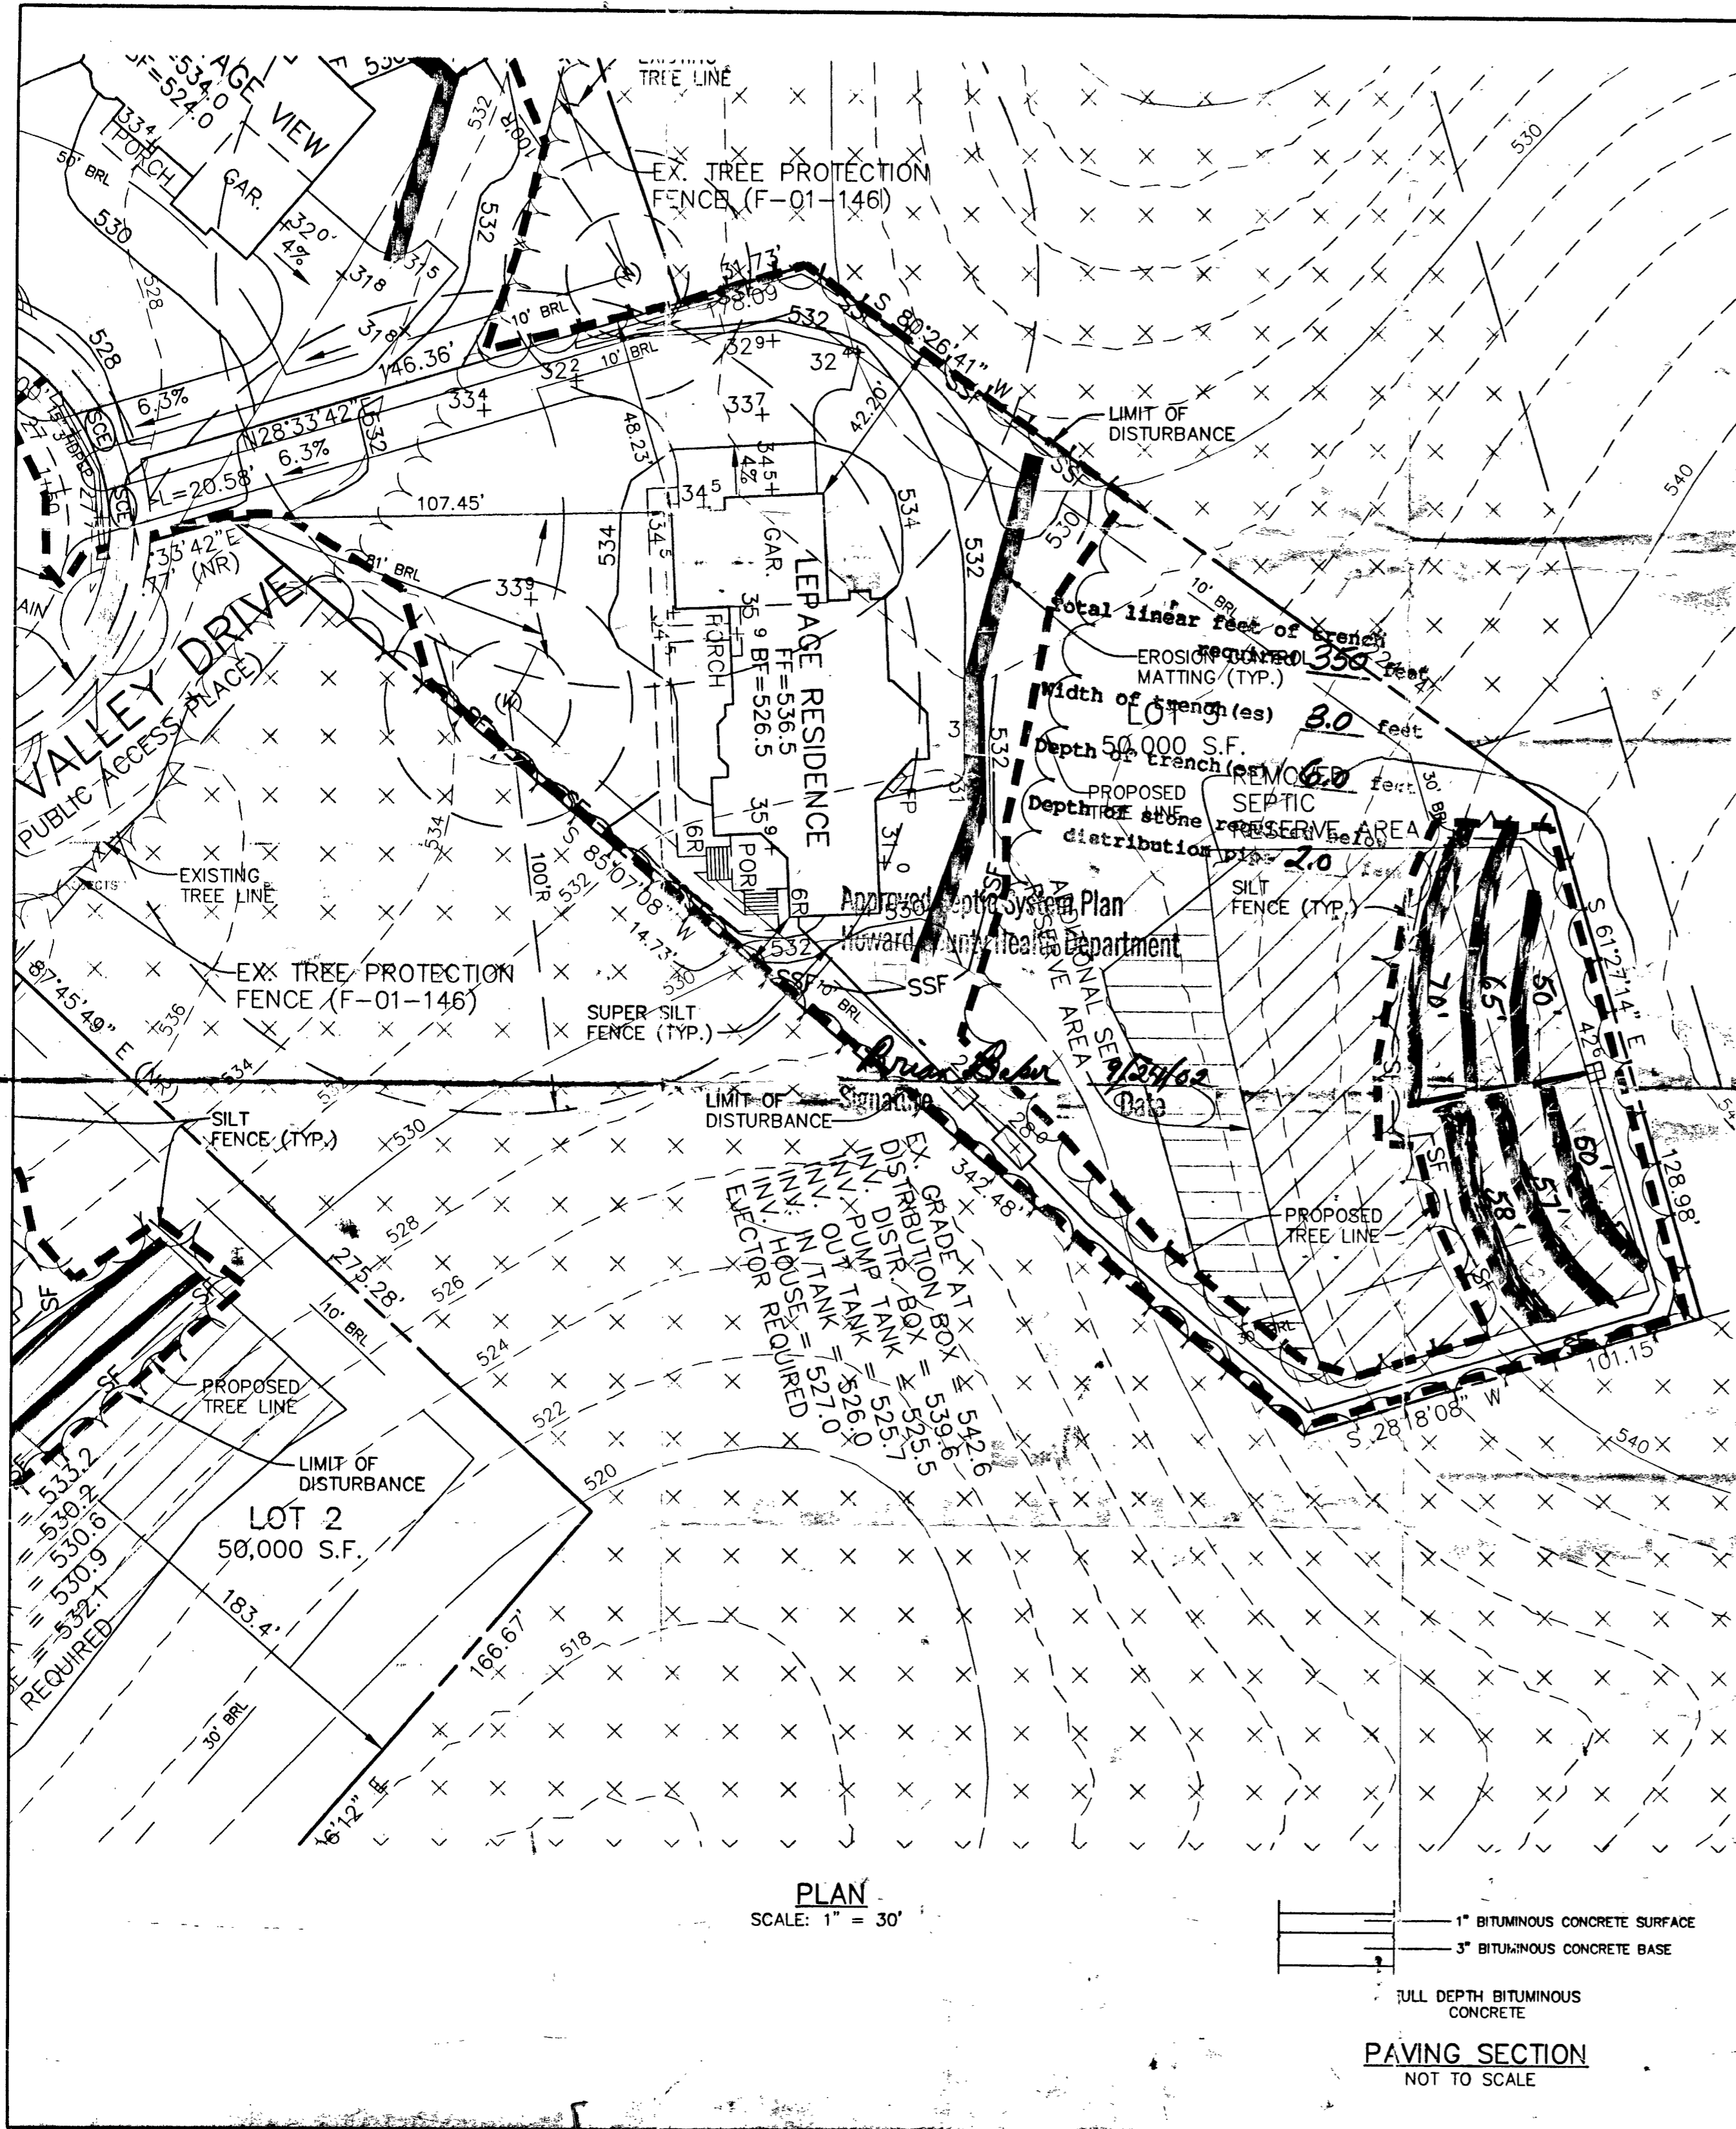


- NOTES:**
1. THE LOT SHOWN HEREON WAS RECORDED BY PLAT NUMBER 15288, REFER TO THE RECORD PLAT FOR LOT DIMENSIONS, LOT AREAS, ALL EASEMENTS AND BUILDING RESTRICTIONS.
 2. THIS AREA DESIGNATES A PRIVATE SEWERAGE EASEMENT OF 10,000 SQUARE FEET AS REQUIRED BY THE STATE DEPARTMENT OF THE ENVIRONMENT FOR INDIVIDUAL SEWERAGE DISPOSAL. IMPROVEMENTS OF ANY NATURE IN THIS AREA IS RESTRICTED UNTIL PUBLIC SEWER IS AVAILABLE. THIS EASEMENT SHALL BECOME NULL AND VOID UPON CONNECTION TO A PUBLIC SEWERAGE SYSTEM. THE COUNTY HEALTH OFFICER SHALL HAVE THE AUTHORITY TO GRANT VARIANCES FOR ENCROACHMENT INTO THE PRIVATE SEWERAGE EASEMENT. RECORDATION OF A MODIFIED SEWERAGE EASEMENT PLAT SHALL NOT BE NECESSARY.
 3. SEDIMENT AND EROSION CONTROLS WERE APPROVED BY HOWARD SOIL CONSERVATION DISTRICT UNDER GP-02-48 AND MODIFIED FOR THIS SPECIFIC HOUSE.
 4. TOPOGRAPHY SHOWN HEREON IS TAKEN FROM THE APPROVED ROAD CONSTRUCTION PLANS.
 5. EXACT LENGTH OF SEPTIC TRENCHES ARE TO BE DETERMINED BY THE HEALTH DEPARTMENT AT THE TIME OF PERMIT ISSUANCE.
 6. SPOIL FROM THE TRENCHING OF THE SEPTIC AREA IS TO BE PLACED ON THE UPHILL SIDE OF THE EXCAVATION FOR EACH INDIVIDUAL LOT.
 7. ALL SEDIMENT AND EROSION CONTROL FEATURES USED ON THIS SITE SHALL COMPLY WITH 1994 MARYLAND STANDARDS AND SPECIFICATIONS FOR SOIL EROSION AND SEDIMENT CONTROL.
 8. ALL STORMWATER MANAGEMENT FEATURES USED ON THIS SITE MUST COMPLY WITH THE APPROVED ROAD CONSTRUCTION PLANS.
 9. ALL DRAINAGE AND STORMWATER MANAGEMENT FEATURES USED ON THIS SITE MUST COMPLY WITH THE APPROVED ROAD CONSTRUCTION PLANS (F-01-146).

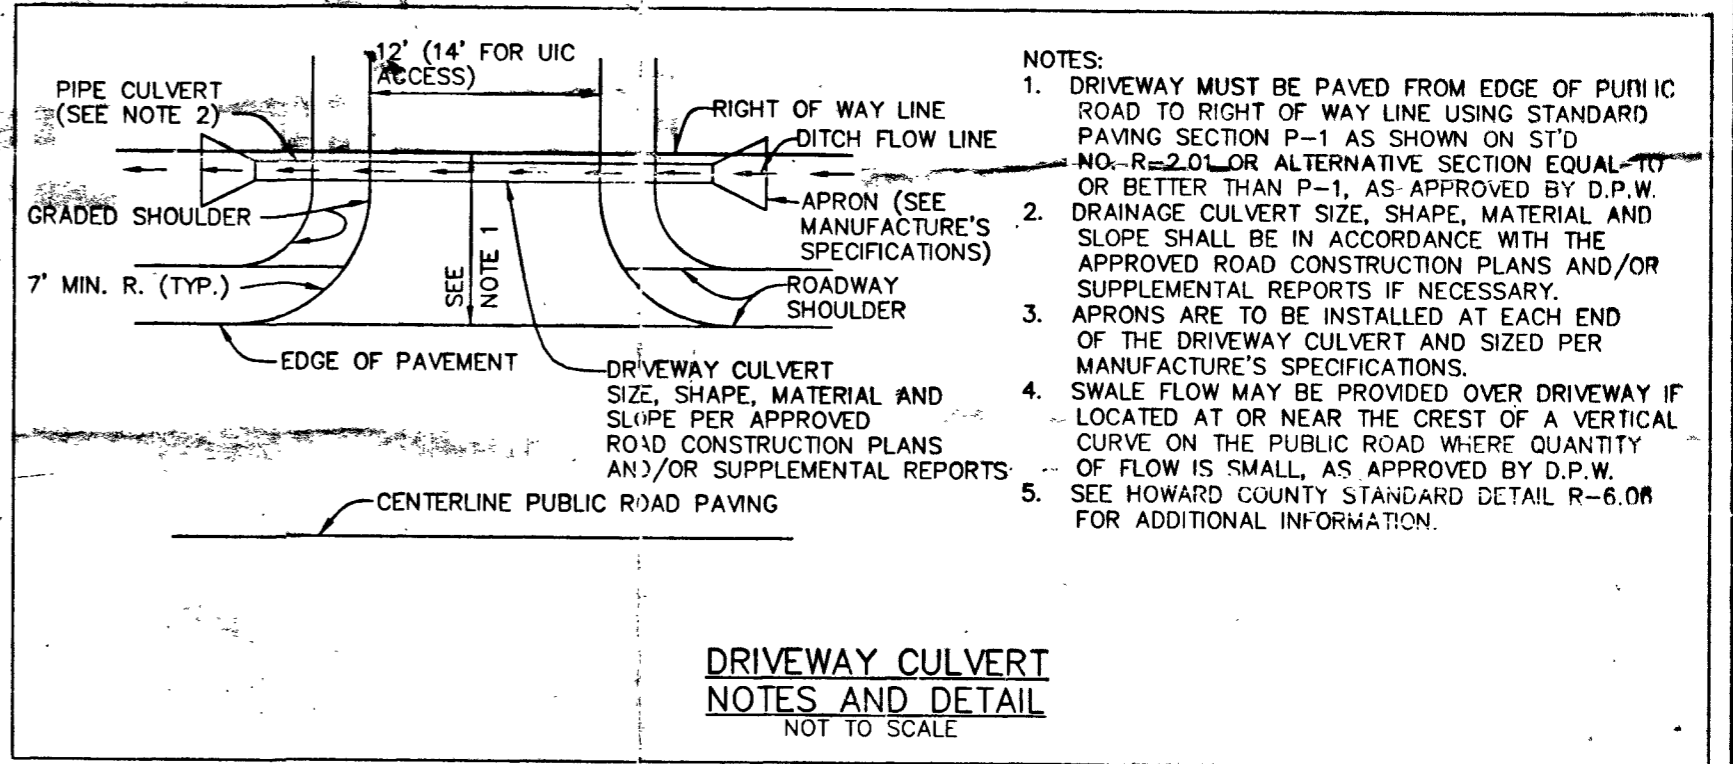

- LEGEND**
- LIMIT OF DISTURBANCE
 - EX. SILT FENCE
 - PROP. SILT FENCE
 - EX. SUPER SILT FENCE
 - PROP. SUPER SILT FENCE
 - EX. EARTH DIKE
 - PROP. EARTH DIKE
 - STABILIZED CONSTRUCTION ENTRANCE
 - EXISTING CONTOUR
 - PROPOSED CONTOUR
 - EROSION CONTROL MATTING

PLAN
SCALE: 1" = 30'

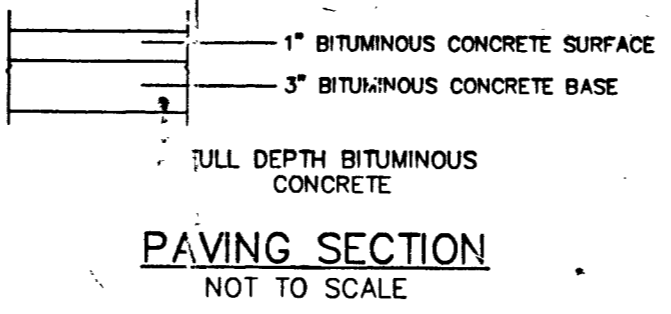

NO.	DATE	REVISION

BENCHMARK
ENGINEERS ▲ LAND SURVEYORS ▲ PLANNERS
ENGINEERING, INC.

8480 BALTIMORE NATIONAL PIKE ▲ SUITE 418
ELLCOTT CI Y. MARYLAND 21043
PHONE: 410-465-6105 ▲ FAX: 410-465-6644
EMAIL: bchmrk@cats.com

OWNER/BUILDER: JAMES H. SELFRIDGE BUILDERS 14045 GARED DRIVE GLENWOOD, MD 21738 PHONE: 410-531-8930 FAX: 410-531-8939	PROJECT: THE WOODS OF WELLINGTON LOT 3
LOCATION: 2960 HUNT VALLEY DRIVE GLENWOOD, MD 21738 TAX MAP 14 - BLOCK 20 - P/O PARCEL 246 4th ELECTION DISTRICT OF HOWARD COUNTY, MARYLAND	TITLE: PERMIT PLAN
HOUSE TYPE: HAMILTON (CUSTOM)	DATE: AUGUST, 2002
DESIGN: JMC	DRAFT: JMC
SCALE: 1" = 30'	PROJECT NO. 1430
	DRAWING 1 OF 1

