

Fill out in triplicate.  
Make fee of \$15.00 payable to:  
HOWARD COUNTY HEALTH DEPT. - SANITATION

# APPLICATION

A 05860  
P \_\_\_\_\_

SEWAGE DISPOSAL TESTING

MARYLAND STATE DEPARTMENT OF HEALTH

HOWARD COUNTY

ELLCOTT CITY

Septic Tank - 1000 gal

DISTRICT: 4

Dry Well - 572 sq ft absorbent sidewalk area to begin DATE 10/2/62

below the inlet pipe. Inlet pipe must be 5 ft below original grade

Two dry wells should be used, and each Dry Well should be at least 10 ft diameter (not counting gravel core) and 4 ft deep below

Place Dry Well approx 48 ft from fence line nearest Daisy Road and between 35 and 70 ft from fence line on right side of lot side next to wooded.

TO: THE COUNTY HEALTH OFFICER Varen

ELLCOTT CITY, MARYLAND

I, HEREBY, APPLY FOR THE NECESSARY TESTS IN ORDER TO CONSTRUCT (OR RECONSTRUCT) A SEWAGE DISPOSAL SYSTEM.

✓ PROPERTY OWNER Charles J. Kelley

✓ ADDRESS Rt 2 Daisy Rd. Woodbine, Md. ✓ PHONE HU 9-4740

PROPERTY LOCATION:

✓ SUBDIVISION \_\_\_\_\_ LOT NO. \_\_\_\_\_

✓ ROAD AND DESCRIPTION Daisy Rd. 2nd house on <sup>left</sup> south of Union Chapel Rd and Daisy Rd. Intersection - white 2 story with green shutters

OCCUPANT \_\_\_\_\_ PHONE \_\_\_\_\_

PERSON TO CONSTRUCT SYSTEM \_\_\_\_\_

ADDRESS \_\_\_\_\_ PHONE \_\_\_\_\_

✓ SIZE OF LOT 1.00 AC ✓ TYPE BLDG. Masonry 4  
NUMBER OF BEDROOMS

IF NOT SINGLE RESIDENCE DESCRIBE \_\_\_\_\_

✓ SIGNATURE OF APPLICANT Charles J. Kelley


✓ APPROVED BY Donald W. Whittington FOR Dry Wells DATE 10/2/62  
(KIND OF SYSTEM)

REJECTED BY \_\_\_\_\_ FOR \_\_\_\_\_ DATE \_\_\_\_\_  
(KIND OF SYSTEM)


HOLD PENDING FURTHER TESTS \_\_\_\_\_ DATE \_\_\_\_\_

REASONS FOR REJECTION OR HOLDING \_\_\_\_\_

# THIS IS NOT A PERMIT

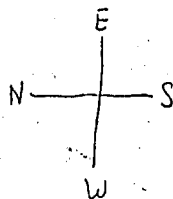

Daisy Rd.

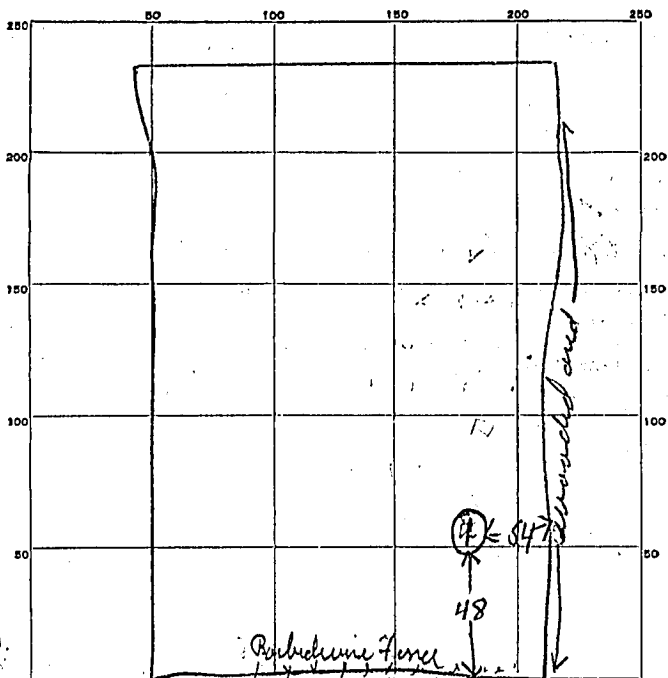

INDICATE NORTH - NAME ADJOINING ROADWAY AS BASE LINE.

Daisy Road

DATE	TEST NO.	DEPTH	PRE-WET		TEST - 1" DROP		TIME
			START	STOP	START	STOP	
10/1/62	1	9	110	115	115	130	15 min

SOIL AUGER FINDING fine s. & clay -

TESTED BY DWM 10-3-62

REMARKS \_\_\_\_\_

ALSO PRESENT Jamie Kelley LOT NO. \_\_\_\_\_