

P.M.  
4-4-63 PERMIT

Approved  
2/15/63  
P 05919  
A 05860

SEWAGE DISPOSAL SYSTEM

MARYLAND STATE DEPARTMENT OF HEALTH

HOWARD COUNTY

ELLCOTT CITY

INDEXED  
4-4-63

DISTRICT 4

INDEXED DATE 10-11-62

Charles J. Kelley IS PERMITTED TO INSTALL  ALTER

ADDRESS Rt. 2 Woodbone, Maryland PHONE Hu 9-4746

A SEWAGE DISPOSAL SYSTEM LOCATED AT 2nd house on left south of Union Chapel Road  
and Daisy Road Intersection White 2 story with green shutters

SUBDIVISION ROAD LOT

PROPERTY OWNER Charles J. Kelley

ADDRESS Same as above

SPECIFICATIONS

DRAIN FIELD DEPTH FEET, BOTTOM AREA SQ. FT.

X SEEPAGE PITS ABSORBENT SIDE-WALL AREA SQ. FT.

1000 SEPTIC TANK CAPACITY GALLONS

FOR GARBAGE GRINDER, INCREASE DISPOSAL AREA 22% & TANK CAPACITY 50%.

OTHER Dry Well 572 sq. ft. absorbent sidewall area to begin below the  
inlet pipe. Inlet pipe must be 5 ft. below original grade. Two dry wells


should be used and each Dry Well should be at least 10 ft. diameter (not counting gravel area)  
and 9 ft. deep below. Place Dry wells about 48 ft. from fence line nearest Daisy Road  
and between 35 and 70 ft. from fence line on right side of lot (side next to wooded area.)

PLANS APPROVED BY Donald W. Monaghan DATE 10-3-62

FILL SEPTIC TANK AND DISTRIBUTION BOX WITH WATER BEFORE CALLING FOR AN INSPECTION. COVER NO WORK UNTIL INSPECTED AND APPROVED.

NEITHER THE HOWARD COUNTY COMMISSIONERS NOR THE HEALTH DEPARTMENT IS RESPONSIBLE FOR THE SUCCESSFUL OPERATION OF ANY SYSTEM.

A 05860

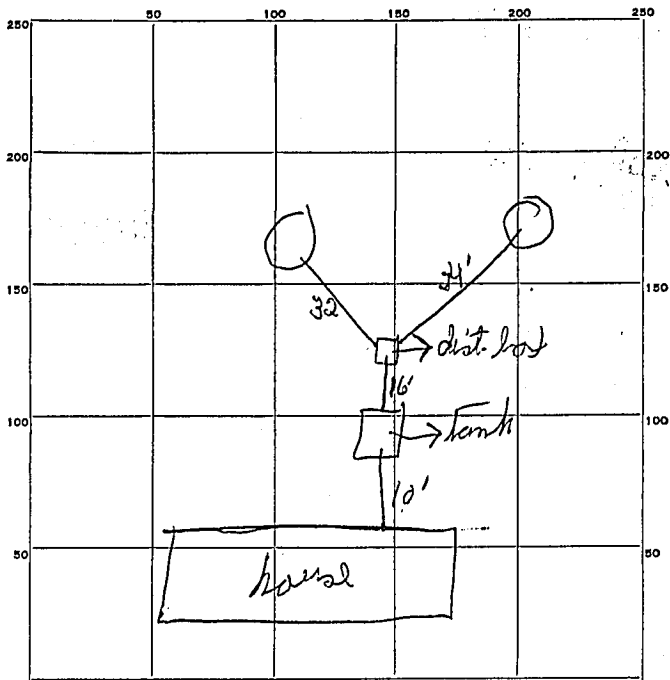

INDICATE NORTH. - NAME ADJOINING ROADWAY AS BASE LINE.

PERMIT CARD ✓

SEPTIC TANK, LEVEL ✓

CLEANOUTS L

DISTRIBUTION BOX, LEVEL \_\_\_\_\_

TILE FIELD, DEPTH \_\_\_\_\_ FT. TRENCH WIDTH \_\_\_\_\_ FT.

GRAVEL DEPTH \_\_\_\_\_ IN. TOTAL LENGTH \_\_\_\_\_ FT.

NUMBER OF TRENCHES \_\_\_\_\_ TOTAL BOTTOM AREA \_\_\_\_\_

2 SEEPAGE PITS, INSIDE DIAMETER 9' FT. DEPTH BELOW INLET 10' FT.

ABSORBENT AREA 572+ SQ. FT.

REMARKS

O.K. to cover tanks & lines - Tops of  
 by wells & gravel to be checked later. P.W.  
 4/9/63 gravel around Dig Well look Tops not yet installed  
 4/15/63 - Tops installed on Dig Well

DATE SYSTEM APPROVED

4/15/63

INSPECTOR

W. W. [Signature]